IF UST'S ARE ENCOUNTERED WITHIN THE PROJECT LIMITS BY THE DEPARTMENT'S PERSONNEL DURING PROJECT IMPLEMENTATION, THEY SHALL BE HANDLED IN ACCORDANCE WITH GDOT STANDARD SPECIFICATIONS FOR CONSTRUCTION, SECTION 217 - REMOVAL OF UNDERGROUND STORAGE TANKS

ANY CONTAMINATED SOIL EXCAVATED DURING CONSTRUCTION ACTIVITIES WITHIN THE PROJECT LIMITS SHALL BE HANDLED IN ACCORDANCE WITH GDOT STANDARD SPECIFICATIONS FOR CONSTRUCTION, SECTION 215 - REMOVAL OF SOLID WASTE AND SHALL BE DISPOSED OF OFF-SITE ACCORDING TO PREVAILING RULES AND REGULATIONS OF EPD, LAND PROTECTION BRANCH, SOLID WASTE MANAGEMENT PROGRAM.

VOID

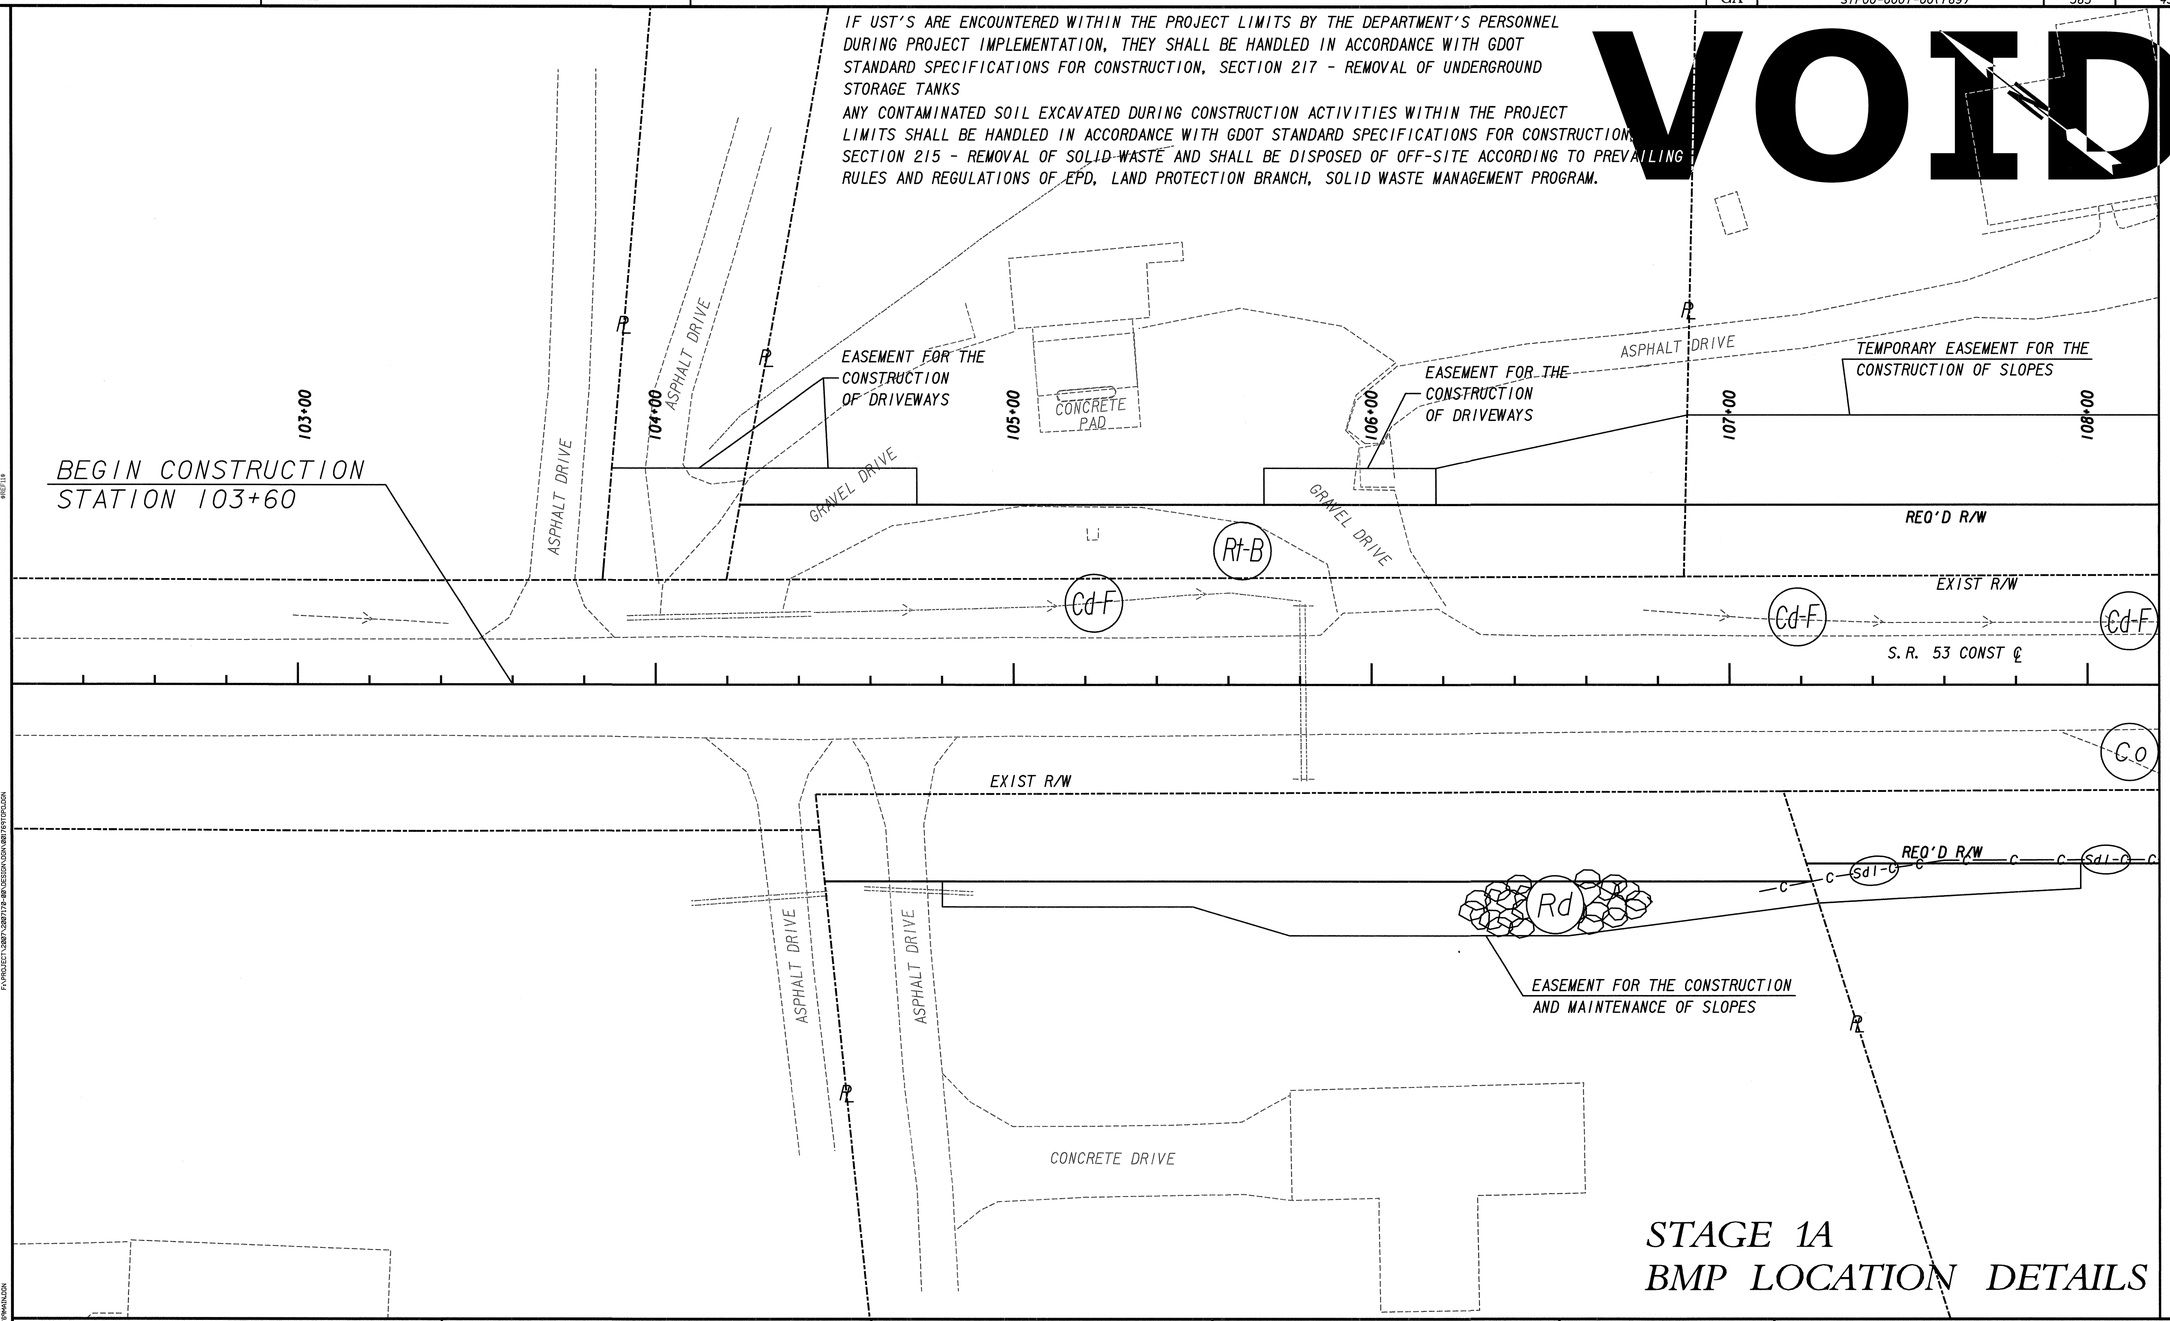

STAGE 1A
BMP LOCATION DETAILS

Heath & Lineback Engineers
INCORPORATED
2390 CANTON ROAD, BUILDING 200
MARIETTA, GEORGIA 30066-5393

MULKEY
ENGINEERS & CONSULTANTS
1255 CANTON STREET, SUITE G
ROSWELL, GEORGIA 30075
(678) 461-3511

SCALE IN FEET
0 20 40 80

REVISION DATES		

STATE OF GEORGIA
DEPARTMENT OF TRANSPORTATION
OFFICE: DISTRICT 1
BMP LOCATION DETAILS
STAGE 1A

DRAWING No. 54-01

3/1/2007 GPLN