DATE$$$	TIME$$$	PRF	DGN	STATE	PROJECT NUMBER	SHEET NO.	TOTAL SHEETS
$USER$		$$PENTABLE$$		GA	STP00-0002-00(382)	11	638

VOID

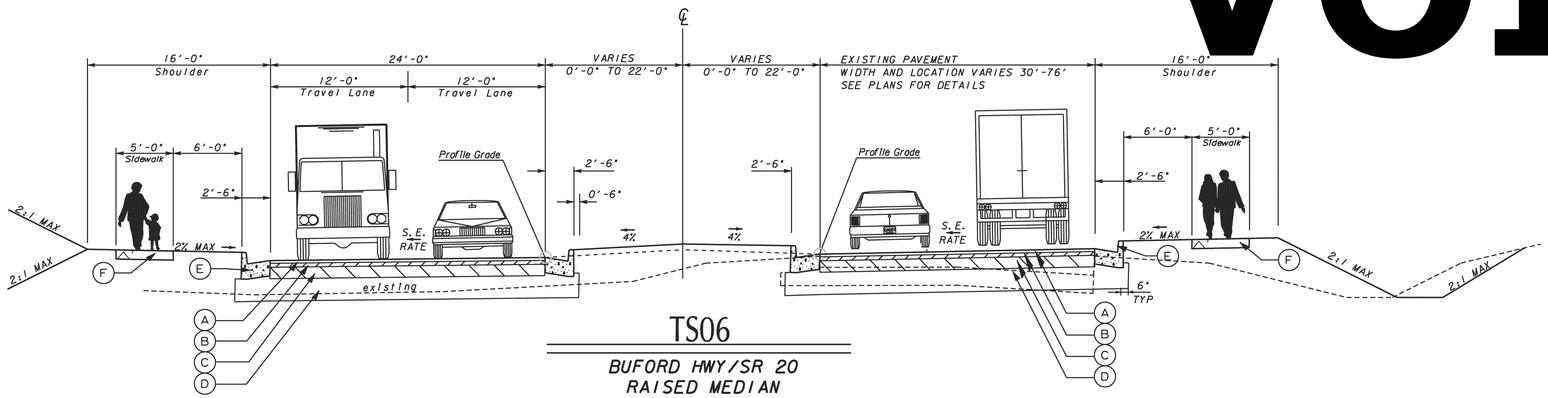

TS06

BUFORD HWY/SR 20
RAISED MEDIAN
URBAN SECTION WITH A 44' MEDIAN
(D.S. 45 MPH)
SUPERELEVATED SECTION
(N.T.S)

STA 1130+43 TO STA 1135+08
STA 1146+31 TO STA 1164+87
STA 1181+69 TO STA 1182+88
STA 1206+93 TO STA 1213+90
STA 1228+11 TO STA 1241+77

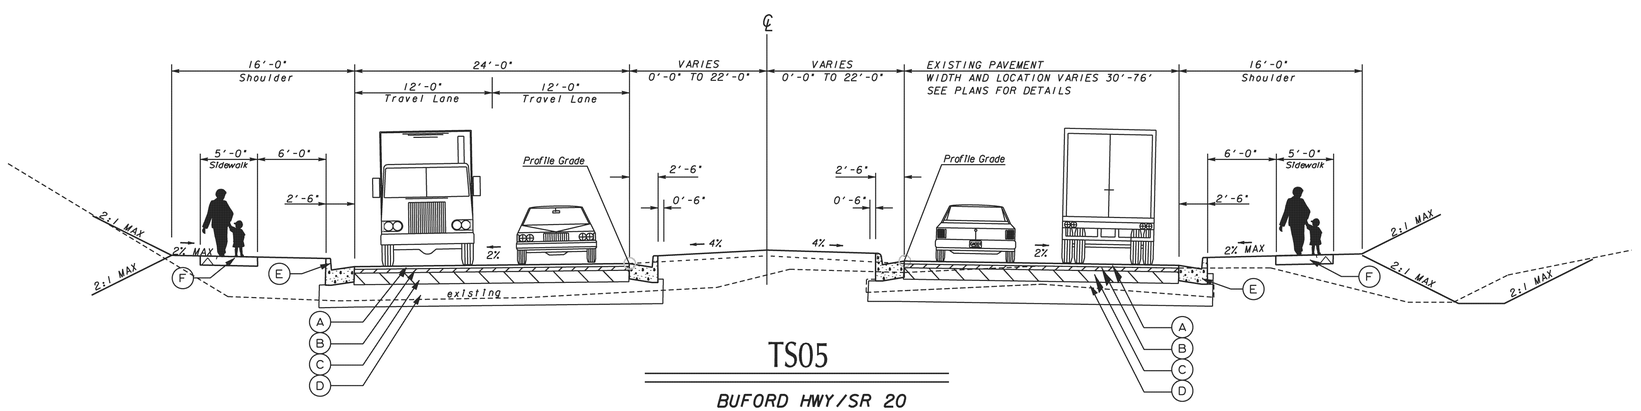

TS05

BUFORD HWY/SR 20
RAISED MEDIAN
URBAN SECTION WITH A 44' MEDIAN
(D.S. 45MPH)
NORMAL CROWN
(N.T.S)

STA 1175+43 TO STA 1181+69
STA 1205+54 TO STA 1206+93
STA 1222+94 TO STA 1228+11

REQUIRED PAVEMENT

- (A) RECYCLED ASPH CONC 12.5 MM SUPERPAVE, GP 1 OR 2, POLY MODIFIED INCL BITUM, 165 lbs/SY
- (B) RECYCLED ASPH CONC 19 MM SUPERPAVE, GP 1 OR 2, INCL BITUM, 330 lbs/SY
- (C) RECYCLED ASPH CONC 25 MM SUPERPAVE, GP 1 OR 2, INCL BITUM, 880 lbs/SY
- (D) GRADED AGGREGATE BASE, 14"
- (E) 8" x 30" CONCRETE CURB AND GUTTER, GA STD 9032B, TP2
- (F) CONCRETE SIDEWALK, 4 IN
- (G) PAVEMENT REINFORCEMENT FABRIC
- (L) LEVELING WILL BE USED AS DIRECTED BY ENGINEER
- (M) P-7 FOR PAVEMENT EDGE TREATMENT

Moreland Altobelli Associates, Inc.
2211 Beaver Ruin Road
Suite 190
Norcross, Georgia 30071
Telephone (770) 263-5945

NTS

REVISION DATES		

STATE OF GEORGIA
DEPARTMENT OF TRANSPORTATION
OFFICE: ROAD DESIGN

TYPICAL SECTIONS

S.R. 20 BUFORD HIGHWAY

DRAWING No. 5-04

3/1/2007 GPLN

...\FOR048\HWY\DGN\002392typs.dgn 12/11/2013 1:45:56 PM