VOID

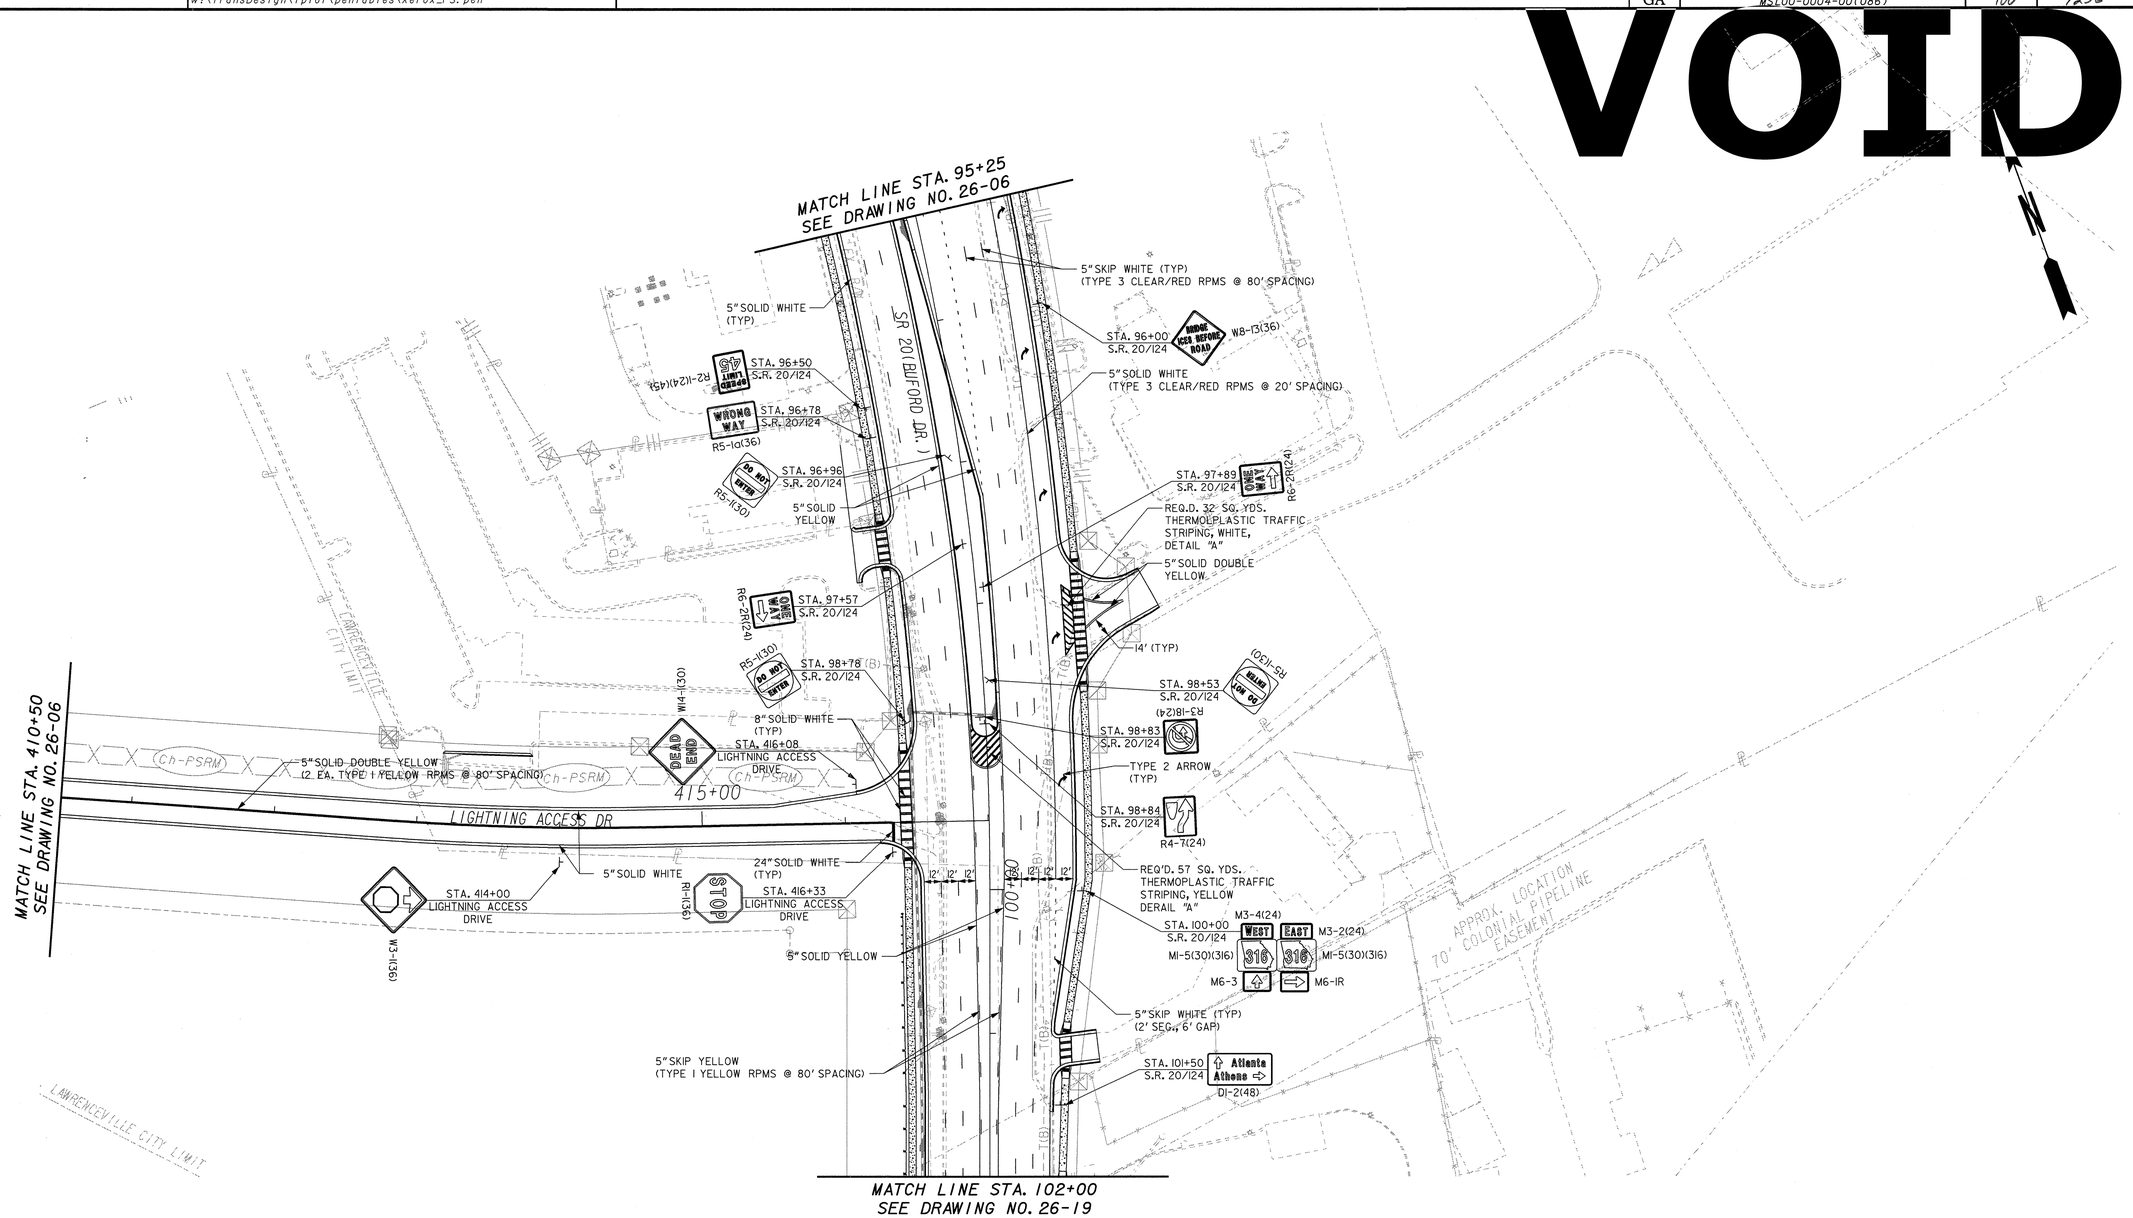

REVISION DATES		

PBS&J

SCALE IN FEET
0 50 100 200

STATE OF GEORGIA
DEPARTMENT OF TRANSPORTATION
OFFICE: PROGRAM DELIVERY

SIGNING AND MARKING PLANS

SR 316
SR 20 (BUFORD DRIVE)
STA. 95+25 - STA. 102+00

DRAWING No. 26-18

3/1/2007 GPLN