STATE	PROJECT NUMBER	SHEET NO.	TOTAL SHEETS
GA.	STP-0004-00(731)HOUSTON	25	73

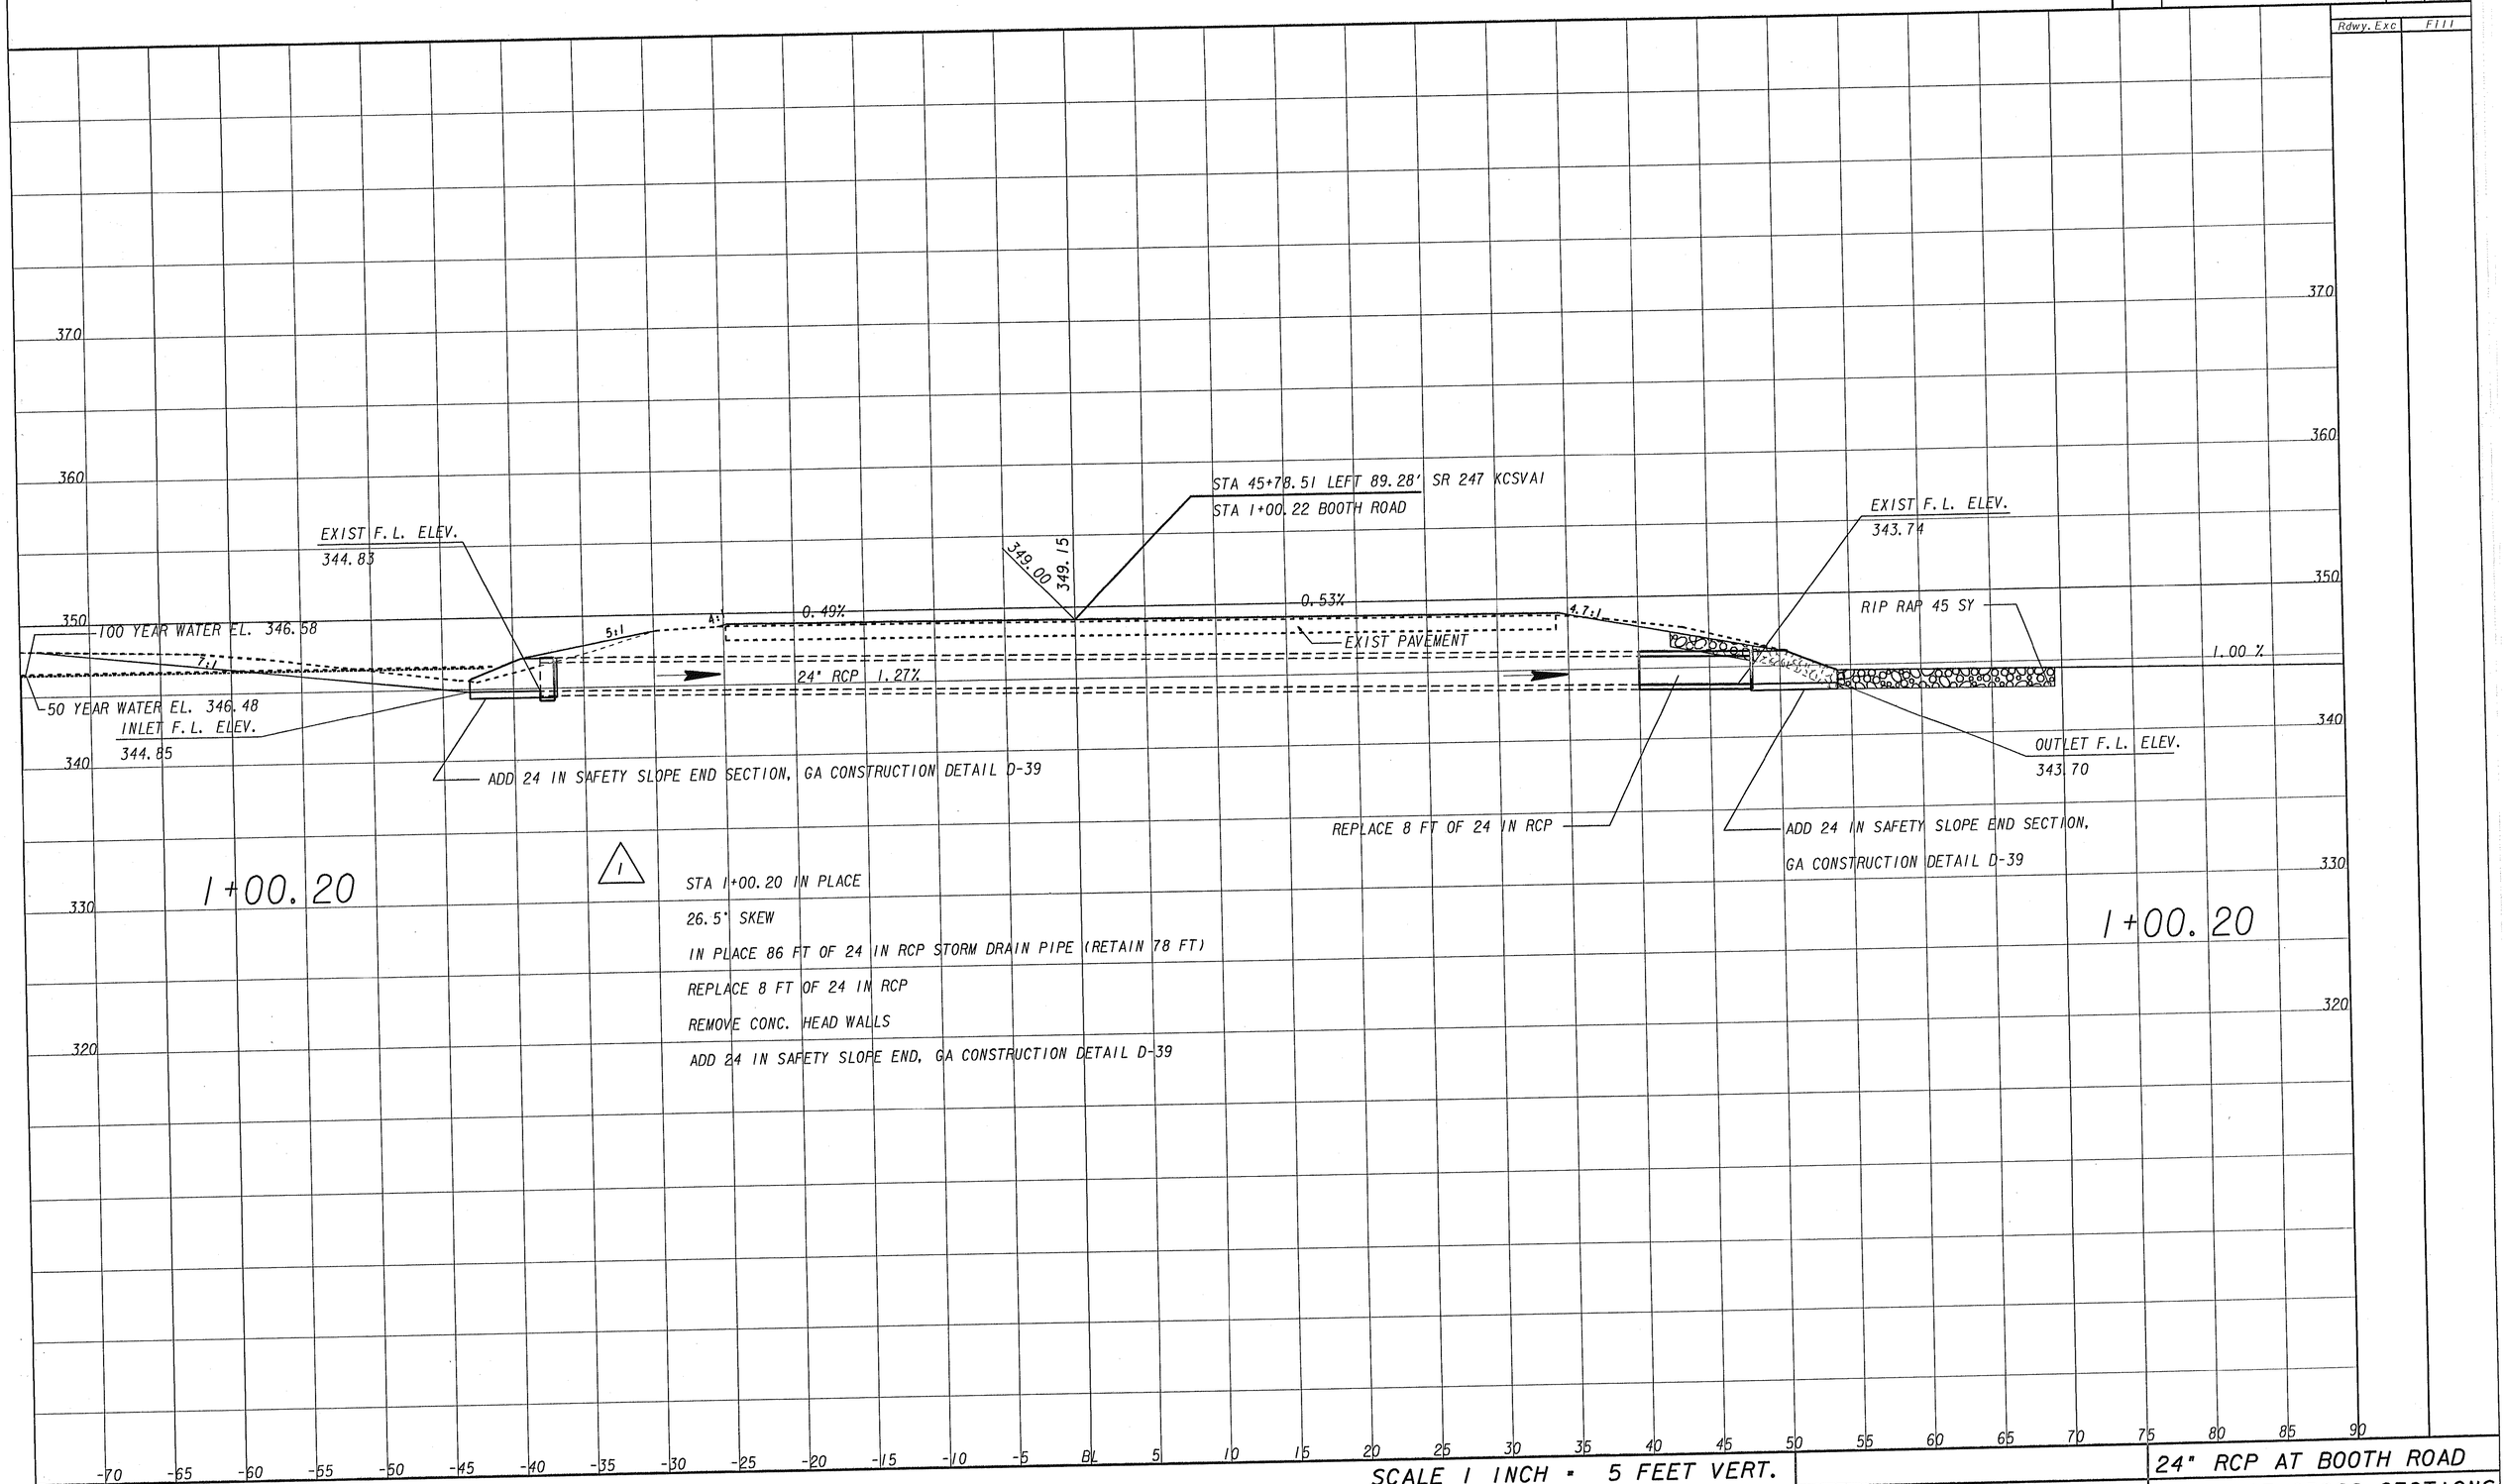

SCALE 1 INCH = 5 FEET VERT.
SCALE 1 INCH = 5 FEET HORIZ.

24" RCP AT BOOTH ROAD
DRAINAGE CROSS SECTIONS

Fri Oct 31 12:57:43 2003 \\GDOT_TM_SV20\OCF\8830paper.gcf jhoskins H:\Work\mh\0004731\dgn\0004731D01DRAINAGEPROFILE.prf
3/17/2008 10:51:39 AM \\GDOT-DSN1\GOPLOT\OCF\Road Design Tiff-18x12 to Tiff-36x24.gcf jblanchard X:\Scanning Staging Area\0004731\0004731_0025.tif GO-RD-Plans-Review