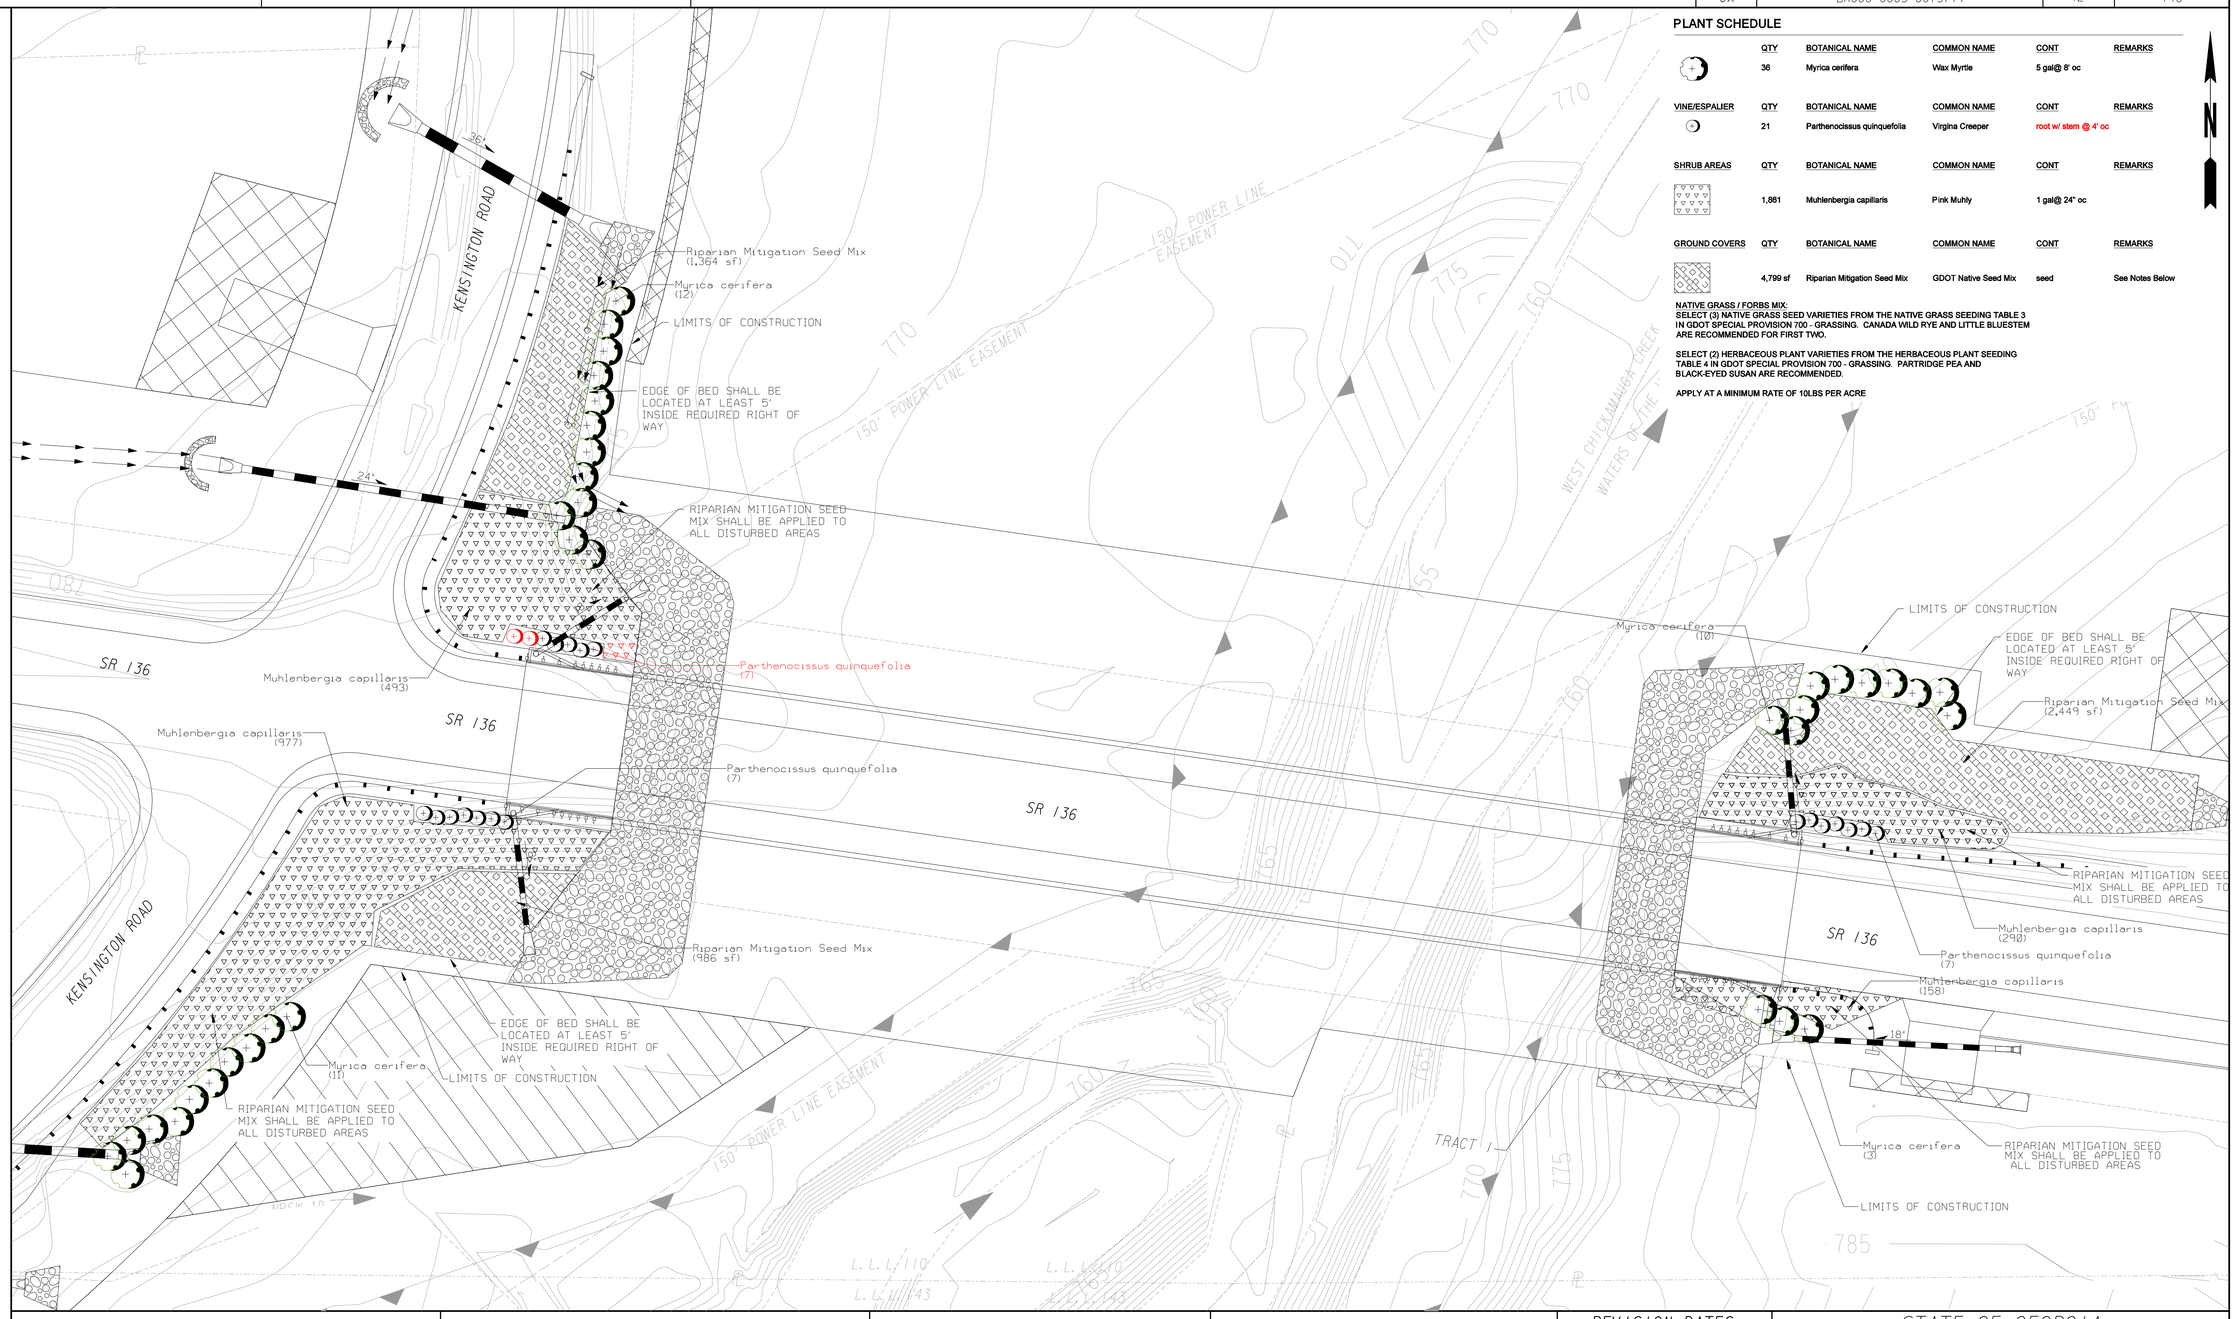

PLANT SCHEDULE

	QTY	BOTANICAL NAME	COMMON NAME	CONT	REMARKS
	36	Myrica cerifera	Wax Myrtle	5 gal@ 8' oc	

VINE/ESPALIER	QTY	BOTANICAL NAME	COMMON NAME	CONT	REMARKS
	21	Parthenocissus quinquefolia	Virgina Creeper	root w/ stem @ 4' oc	

SHRUB AREAS	QTY	BOTANICAL NAME	COMMON NAME	CONT	REMARKS
	1,861	Muhlenbergia capillaris	Pink Muhly	1 gal@ 24" oc	

GROUND COVERS	QTY	BOTANICAL NAME	COMMON NAME	CONT	REMARKS
	4,799 sf	Riparian Mitigation Seed Mix	GDOT Native Seed Mix	seed	See Notes Below

NATIVE GRASS / FORBS MIX:
SELECT (3) NATIVE GRASS SEED VARIETIES FROM THE NATIVE GRASS SEEDING TABLE 3 IN GDOT SPECIAL PROVISION 700 - GRASSING. CANADA WILD RYE AND LITTLE BLUESTEM ARE RECOMMENDED FOR FIRST TWO.

SELECT (2) HERBACEOUS PLANT VARIETIES FROM THE HERBACEOUS PLANT SEEDING TABLE 4 IN GDOT SPECIAL PROVISION 700 - GRASSING. PARTRIDGE PEA AND BLACK-EYED SUSAN ARE RECOMMENDED.

APPLY AT A MINIMUM RATE OF 10LBS PER ACRE

street SMARTS

SCALE IN FEET
0 20 40 80

REVISION DATES		
05/31/11		
02/19/14		

STATE OF GEORGIA
DEPARTMENT OF TRANSPORTATION

OFFICE:

LANDSCAPING PLANS

SR 136 OVER WEST CHICKAMAUGA CREEK
BR000-0005-00(571) 5/5/2011

DRAWING No.
29-001

GPLN