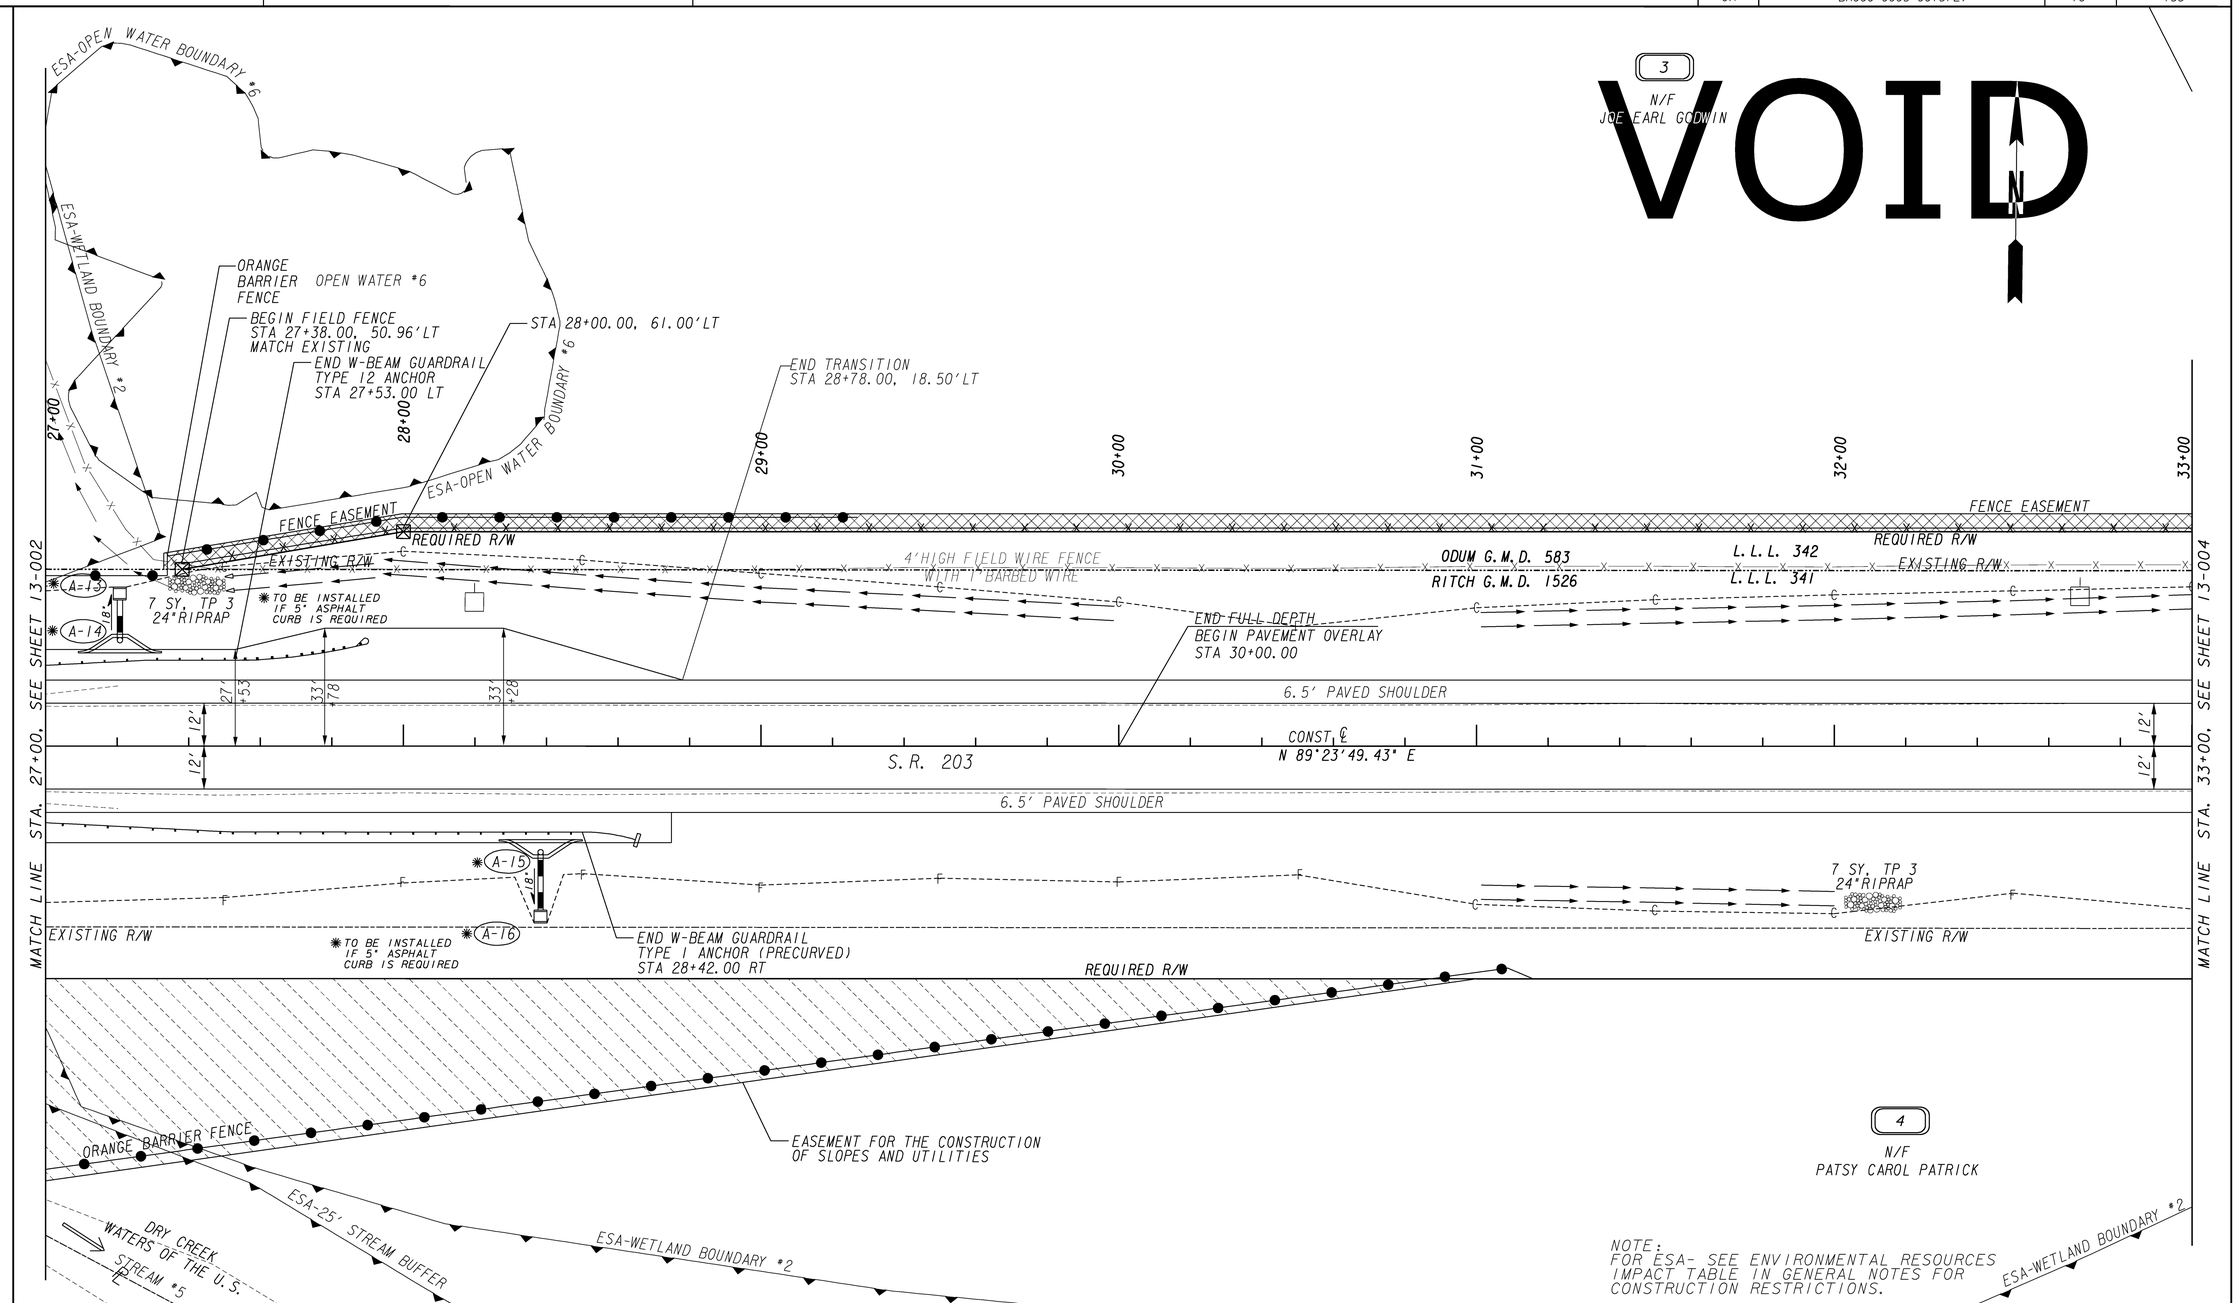

PROPERTY AND EXISTING R/W LINE
REQUIRED R/W LINE
CONSTRUCTION LIMITS
PERM ESMT FOR CONSTR OF SLOPES
TEMP ESMT FOR CONSTR OF SLOPES
TEMP ESMT FOR CONSTR OF DRIVES
MILL & OVERLAY CONSTRUCTION

street SMARTS

SCALE IN FEET
0 20 40 80

REVISION DATES

STATE OF GEORGIA
DEPARTMENT OF TRANSPORTATION
OFFICE:

MAINLINE PLAN

SR 203 OVER DRY CREEK
BRIDGE REPLACEMENT
BR000-0005-00(572) 11/3/2011

DRAWING No.
13-003

GPLN