SUMMARY OF QUANTITIES-OVERHEAD WIRE SPAN

STATION	SPAN WIDTH	LANE	SIGNS-TYPE 1 MAT'L (0.08)				SIGNS-TYPE 2 MAT'L (0.10)				GALV. SEIMANS-MARTIN GUY STRAND MESSENGER CABLE (lin. ft.)-(Including 3-bolt 1" galv. clamps with 5/8" galv. bolts.)		STRAIN POLES (CONCRETE OR STEEL) EACH			TREATED TIMBER POLES, CLASS 2, 30 FT.
			CODE	SIZE	QUAN.	SQ. FT.	CODE	SIZE	QUAN.	SQ. FT.	1/4" DIA. CABLE LIN. FT.	3/8" DIA. CABLE LIN. FT.	TYPE I	TYPE II	TYPE III	EACH
SIXES RD	SURVEY															
110+00	132'	EBL#1	M-SPEC#2(36)	36" X 36"	1	9.00						264.00			2	
			R3-5L(30)	30" X 36"	1	7.50										
		WBL#1	M-SPEC#1(36)	36" X 36"	1	9.00										
			R3-5L(30)	30" X 36"	1	7.50										
		WBL#2	M-SPEC#1(36)	36" X 36"	1	9.00										
			R3-5L(30)	30" X 36"	1	7.50										
114+50	134'	EBL#1	M-SPEC#2(36)	36" X 36"	1	9.00						268.00			2	
			R3-5L(30)	30" X 36"	1	7.50										
		WBL#1	M-SPEC#1(36)	36" X 36"	1	9.00										
			R3-5L(30)	30" X 36"	1	7.50										
		WBL#2	M-SPEC#1(36)	36" X 36"	1	9.00										
			R3-5L(30)	30" X 36"	1	7.50										
RAMP 'B'	SURVEY															
346+36	70'	SBL#1	R3-5L(30)	30" X 36"	1	7.50						140.00		2		
		SBL#2	R3-5L(30)	30" X 36"	1	7.50										
		SBL#3	R3-5R(30)	30" X 36"	1	7.50										
RAMP 'D'	SURVEY															
545+00	86'	NBL#1	R3-5L(30)	30" X 36"	1	7.50						172.00		2		
		NBL#2	R3-5L(30)	30" X 36"	1	7.50										
		NBL#3	R3-5R(30)	30" X 36"	1	7.50										
		NBL#4	R3-5R(30)	30" X 36"	1	7.50										
TOTALS						151.50						844.00		4	4	

NOTES: 1. FOR CABLE AND STRAIN POLES REFER TO SECTION 639 GA.STD. SPECIFICATIONS.
2. LANE NUMBERS ASSIGNED FROM CENTER LINE OUT IN DIRECTION OF SURVEY.
3. WHEN TWO OR MORE SIGN FACING THE SAME DIRECTION ARE TO BE MOUNTED OVER THE SAME LANE(S), THE SIGNS SHALL BE CENTERED OVER THE LANE(S) WITH A 2" SPACE BETWEEN SIGNS.
4. FOR ERECTION DETAILS SEE "TYPICAL ERECTION DETAILS-OVERHEAD LANE MARKERS".

DETAIL OF M-SPECIAL SIGNS

- NO SCALE -

VOID

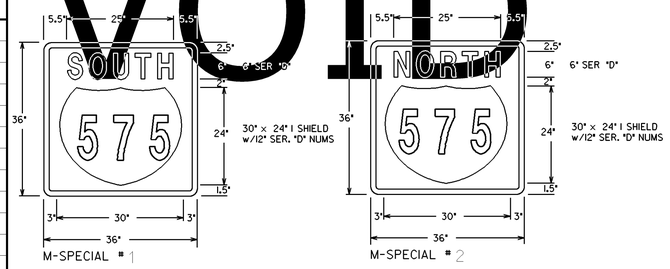

M-SPECIAL SIGNS SHALL HAVE WHITE LEGEND AND BORDERS ON GREEN REFLECTORIZED BACKGROUND. GEORGIA AND U.S. SHIELDS SHALL HAVE A WHITE REFLECTORIZED BACKGROUND WITH BLACK LEGEND. INTERSTATE SYMBOLS SHALL BE PER THE M.U.T.C.D..

R-SPECIAL SIGNS SHALL HAVE WHITE REFLECTORIZED BACKGROUNDS WITH BLACK LEGENDS, BORDERS, AND SYMBOLS.

GPLN

DESIGNED BY: TF | CHECKED BY: PA | DATE: 6-23-10
REVIEWED BY: | DATE:

GEORGIA
DEPARTMENT OF TRANSPORTATION

NOT TO SCALE

REVISIONS

STATE OF GEORGIA
DEPARTMENT OF TRANSPORTATION
OFFICE: TRAFFIC OPERATIONS
SIGNING AND MARKING PLANS
OVERHEAD WIRE SPAN

DRAWING No. 6-09