31-JUL-2013 13:23 Chad.Havens	006043CV01 8825Full.pen	R:\07400004\006043\DGN\As Builts\DGN\006043CV01.dgn GRWCOV	STATE	PROJECT NUMBER	SHEET NO.	TOTAL SHEETS
			GA	CSNHS-0006-00(043)	1	668

DEPARTMENT OF TRANSPORTATION
STATE OF GEORGIA

PLAN AND PROFILE OF PROPOSED
RIDGEWALK PARKWAY OVER I-575
CHEROKEE COUNTY

FEDERAL AID PROJECT
CSNHS-0006-00(043)

AS-BUILT PLANS
12/12/12

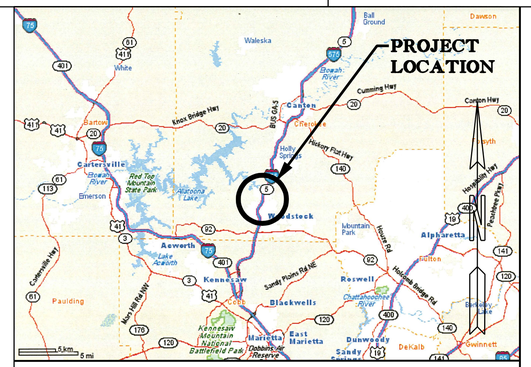

LOCATION SKETCH

TRAFFIC DESIGN DATA:	I-575	RIDGEWALK PKWY.
TRAFFIC A.D.T.(V.P.D.)	88120 (2012)	8320 (2012)
TRAFFIC A.D.T.(V.P.D.)	160500 (2032)	15950 (2032)
TRAFFIC D.H.V.(V.P.H.)	13620 (2032)	1590 (2032)
DIRECTIONAL DIST.	51%	53%
% TRUCKS	6	3
24 HR.TRUCKS %	7	5
SPEED DESIGN (MPH)	75	45

FEDERAL ROUTE # I-575

STATE ROUTE # 5

P.I.NO. 0006043

NOTE :
ALL REFERENCES IN THIS DOCUMENT,WHICH INCLUDES ALL PAPERS,WRITINGS, DOCUMENTS,DRAWINGS,OR PHOTOGRAPHS USED,OR TO BE USED IN CONNECTION WITH THIS DOCUMENT,TO "STATE HIGHWAY DEPARTMENT OF GEORGIA","STATE HIGHWAY DEPARTMENT","GEORGIA STATE HIGHWAY DEPARTMENT","HIGHWAY DEPARTMENT",OR "DEPARTMENT "WHEN THE CONTEXT THEREOF MEANS THE STATE HIGHWAY DEPARTMENT OF GEORGIA,AND SHALL BE DEEMED TO MEAN THE DEPARTMENT OF TRANSPORTATION.

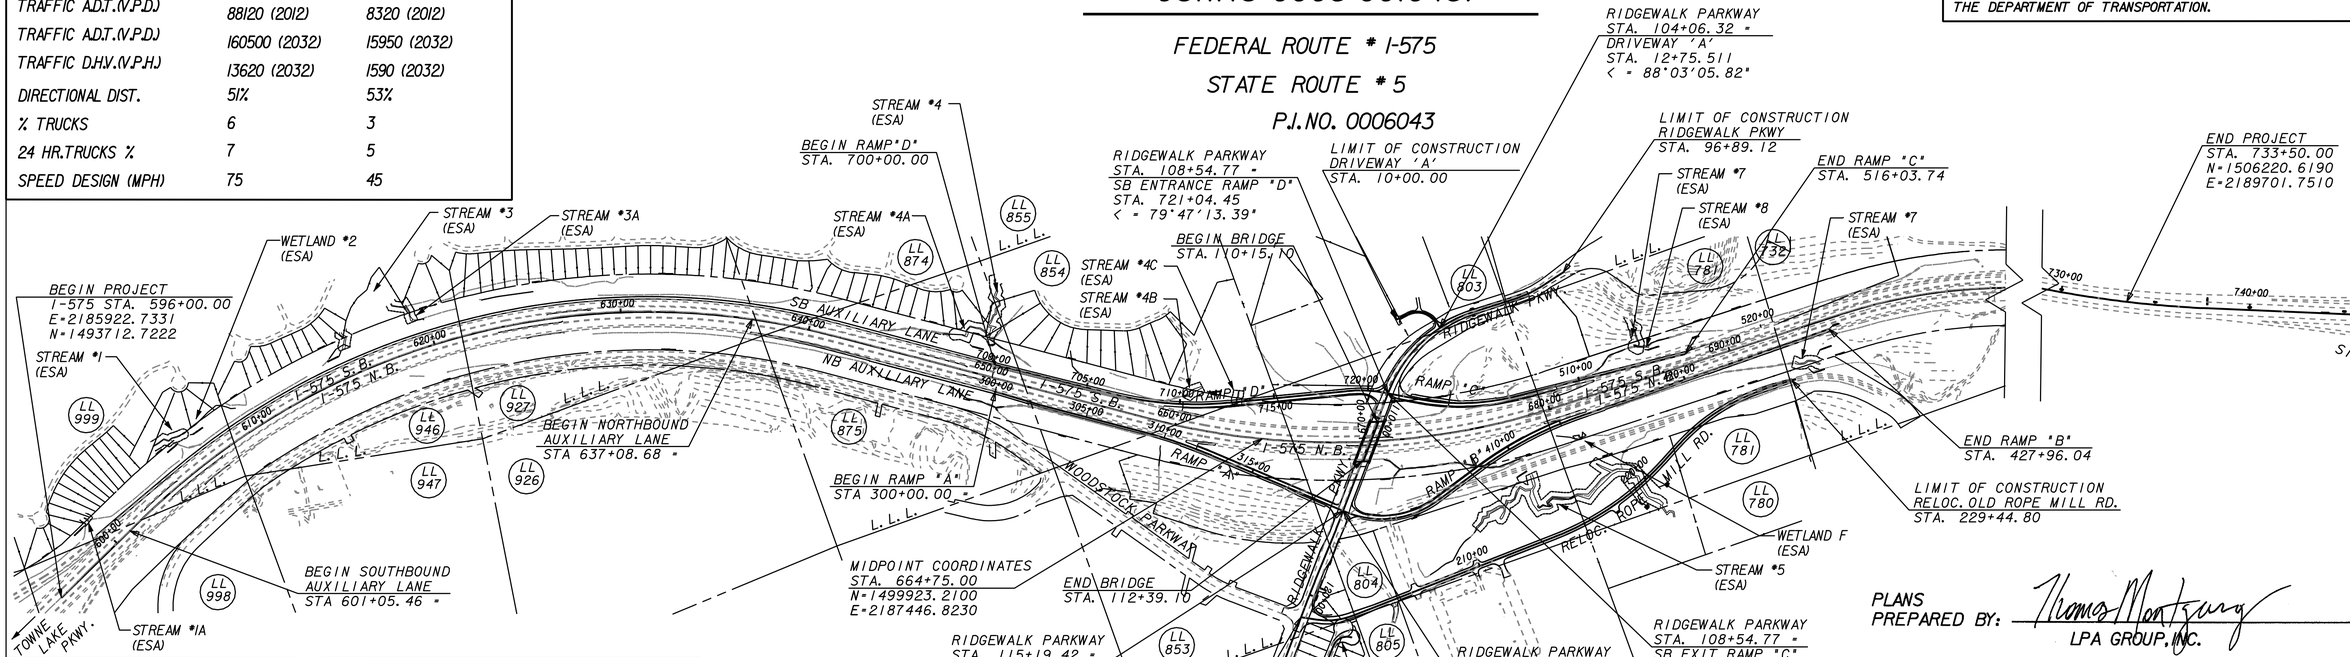

THIS PROJECT HAS BEEN PREPARED USING THE HORIZONTAL GEORGIA COORDINATE SYSTEM OF 1985 (NAD 1983)/(94) WEST ZONE, AND THE NORTH AMERICAN VERTICAL DATUM (NAVD) OF 1988.

MID-POINT COORDINATES

STATION= 664+75.00

N 1499923.2100

E 2187446.8230

LOCATION & DESIGN APPROVAL DATE: 06-01-09

FUNCTIONAL CLASS:
PRINCIPAL ARTERIAL FREEWAY

THIS PROJECT IS 100% IN CHEROKEE COUNTY AND IS 100% IN CONG.DIST.NO. 6.

PROJECT DESIGNATION: FULL OVERSIGHT

THE DATA,TOGETHER WITH ALL OTHER INFORMATION SHOWN ON THESE PLANS OR IN ANYWAY INDICATED THEREBY,WHETHER BY DRAWINGS OR NOTES,OR IN ANY OTHER MANNER,ARE BASED UPON FIELD INVESTIGATIONS AND ARE BELIEVED TO BE INDICATIVE OF ACTUAL CONDITIONS. HOWEVER, THE SAME ARE SHOWN AS INFORMATION ONLY,ARE NOT GUARANTEED,AND DO NOT BIND THE DEPARTMENT OF TRANSPORTATION IN ANY WAY. THE ATTENTION OF BIDDER IS SPECIFICALLY DIRECTED TO SUBSECTIONS 102.04,102.05,AND 104.03 OF THE SPECIFICATIONS.

THE LPA GROUP
TRANSPORTATION CONSULTANTS
A UNIT OF MICHAEL BAKER CORPORATION
3595 ENGINEERING DRIVE
NORCROSS, GEORGIA 30092
(770) 263-9118

THIS PLAN SET IS SEALED ONLY FOR THE AS-BUILT CONDITIONS DOCUMENTED THROUGH THE R.F.I. AND RED LINE PROCESS BY THE CONTRACTOR. THIS DOCUMENT WAS ORIGINALLY SEALED BY THOMAS D. MONTGOMERY, LICENSE NO. 23354 ON NOVEMBER 30, 2010.

THIS MEDIA SHALL NOT BE CONSIDERED A CERTIFIED DOCUMENT AS TO THE ORIGINAL DOCUMENT BUT CERTIFIED ONLY AS TO THE REVISIONS.

GEORGIA REGISTERED No. 23354 PROFESSIONAL ENGINEER THOMAS D. MONTGOMERY 11/30/10

COUNTY No. 057 PROJECT No. CSNHS-0006-00(043)	CHEROKEE COUNTY
LENGTH OF PROJECT	MILES
NET LENGTH OF ROADWAY	3.123
NET LENGTH OF BRIDGES	0.042
NET LENGTH OF PROJECT	3.165
NET LENGTH OF EXCEPTIONS	0.000
GROSS LENGTH OF PROJECT	3.165

SCALE IN FEET
0 400 800 1600

PLANS PREPARED BY: Thomas Montgomery
LPA GROUP, INC.

RECOMMENDED FOR SUBMISSION BY: Daryl O. Van Meter
INNOVATIVE PROGRAM DELIVERY

11/30/2010 — DATE
CHIEF ENGINEER

PLANS COMPLETED 12-02-2010	REVISIONS 09-28-2011
REVISIONS 01-26-2011	SHEETS: 1,4,438,442
SHEETS: 1,4,426	REVISIONS 09-26-2012
REVISIONS 03-29-2011	SHEETS: 1,4,45,46,57,58,549,618,634
SHEETS: 1,4,44,45,61,69,100,186,190,350,351, 392,416,417	REVISIONS 12-07-2012
REVISIONS 04-22-2011	SHEETS: 1,2,4,23A,23B,44,45,549,573,575, 578,579,582,588,591,596,597,599,600,601,606,
SHEETS: 1,4,549,554	610,615,616,627,628,637,640
REVISIONS 05-31-2011	REVISIONS 07-31-2013
SHEETS: 1,4,57,58,187,263-268	SHEETS: 1,4,43,185