AS-BUILT PLANS 12/12/12

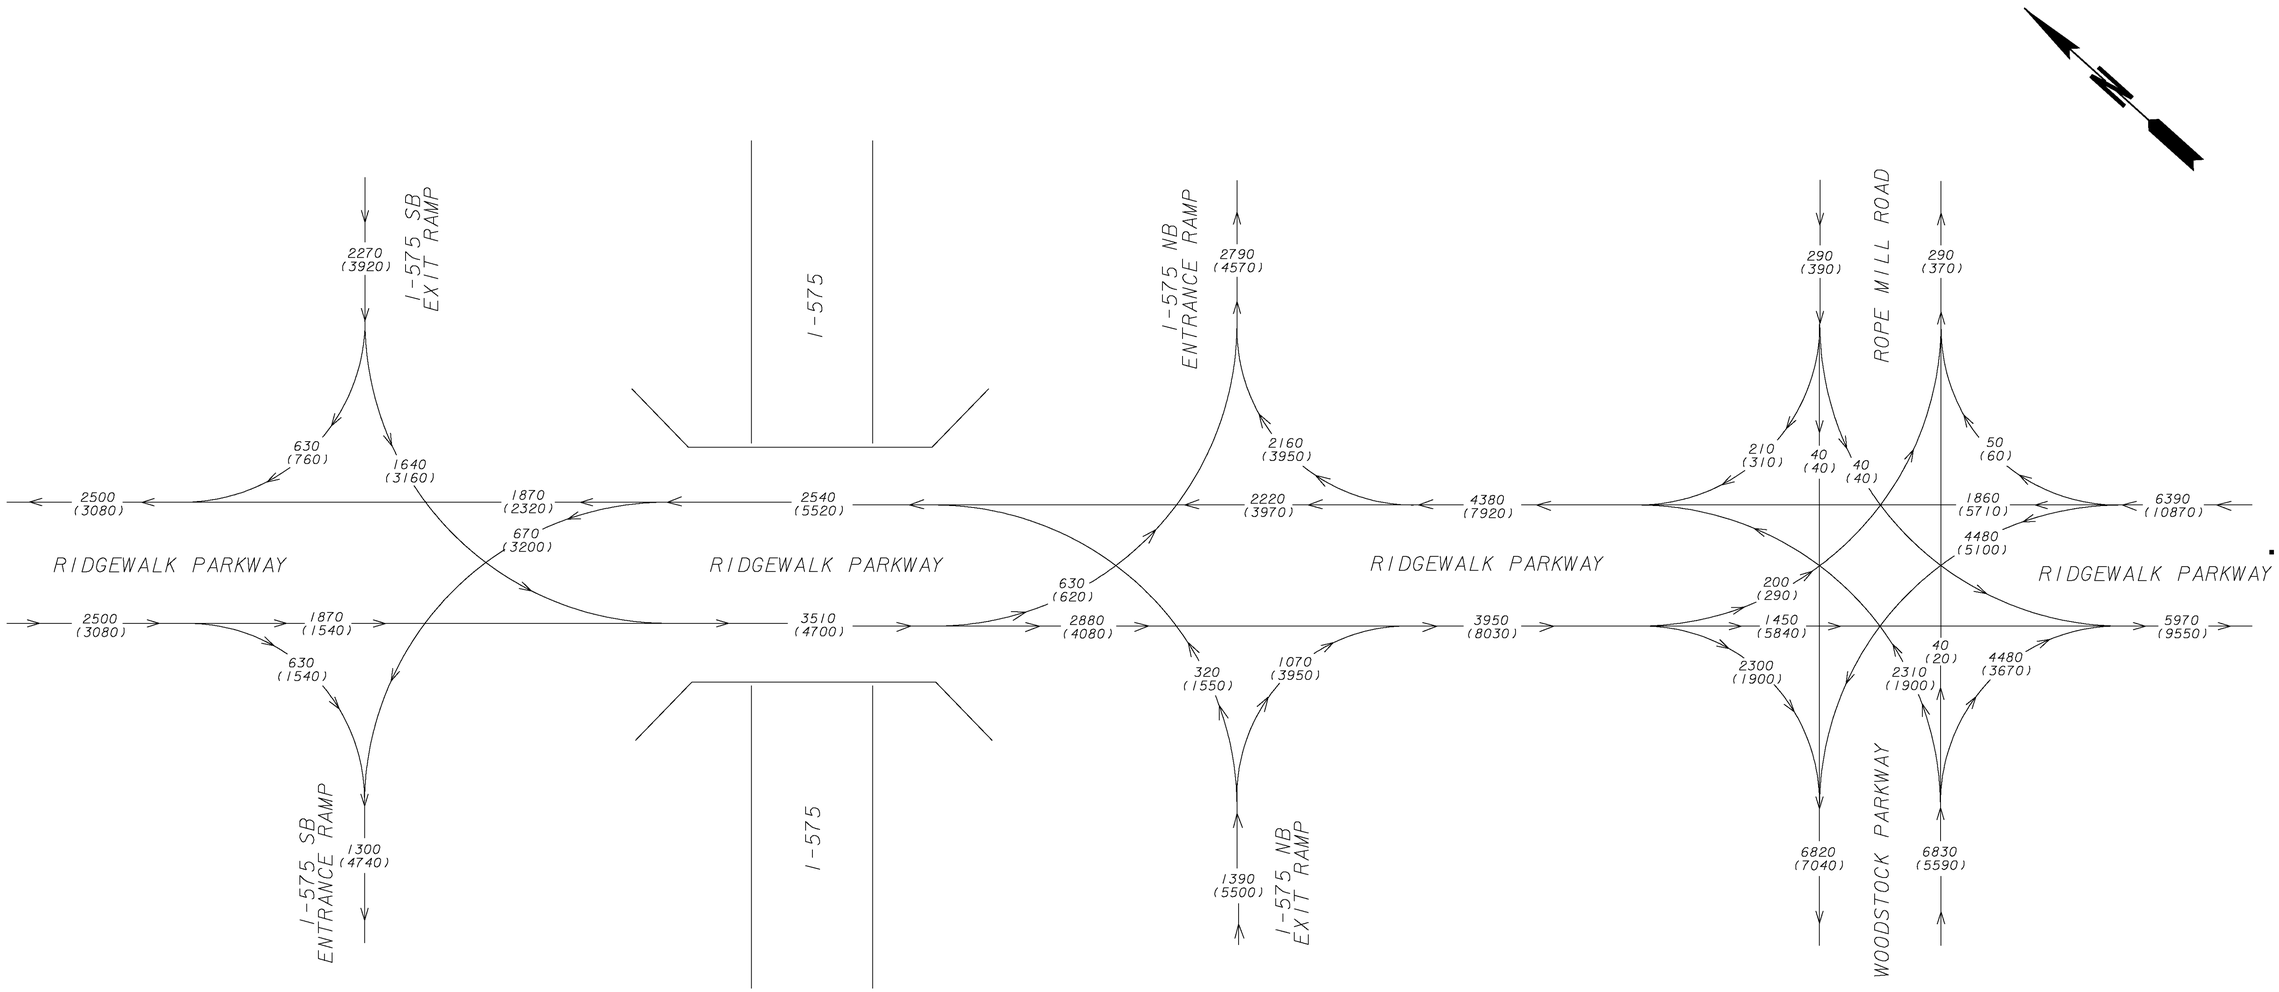

2012 ADT = 000
2032 ADT = (000)

PEAK HOUR TRUCK = 3%
24 HOUR TRUCK = 5%

THE LPA GROUP
TRANSPORTATION CONSULTANTS
A UNIT OF MICHAEL BAKER CORPORATION
3595 ENGINEERING DRIVE
NORCROSS, GEORGIA 30092
(770) 263-9118

REVISION DATES		

STATE OF GEORGIA
DEPARTMENT OF TRANSPORTATION
OFFICE: INNOVATIVE PROGRAM DELIVERY

TRAFFIC DIAGRAM
2012/2032 AVERAGE DAILY TRAFFIC
RIDGEWALK PARKWAY
AT I-575 INTERCHANGE

DRAWING No. 10-002

1/5/2009 GPLN