AS-BUILT PLANS 12/12/12

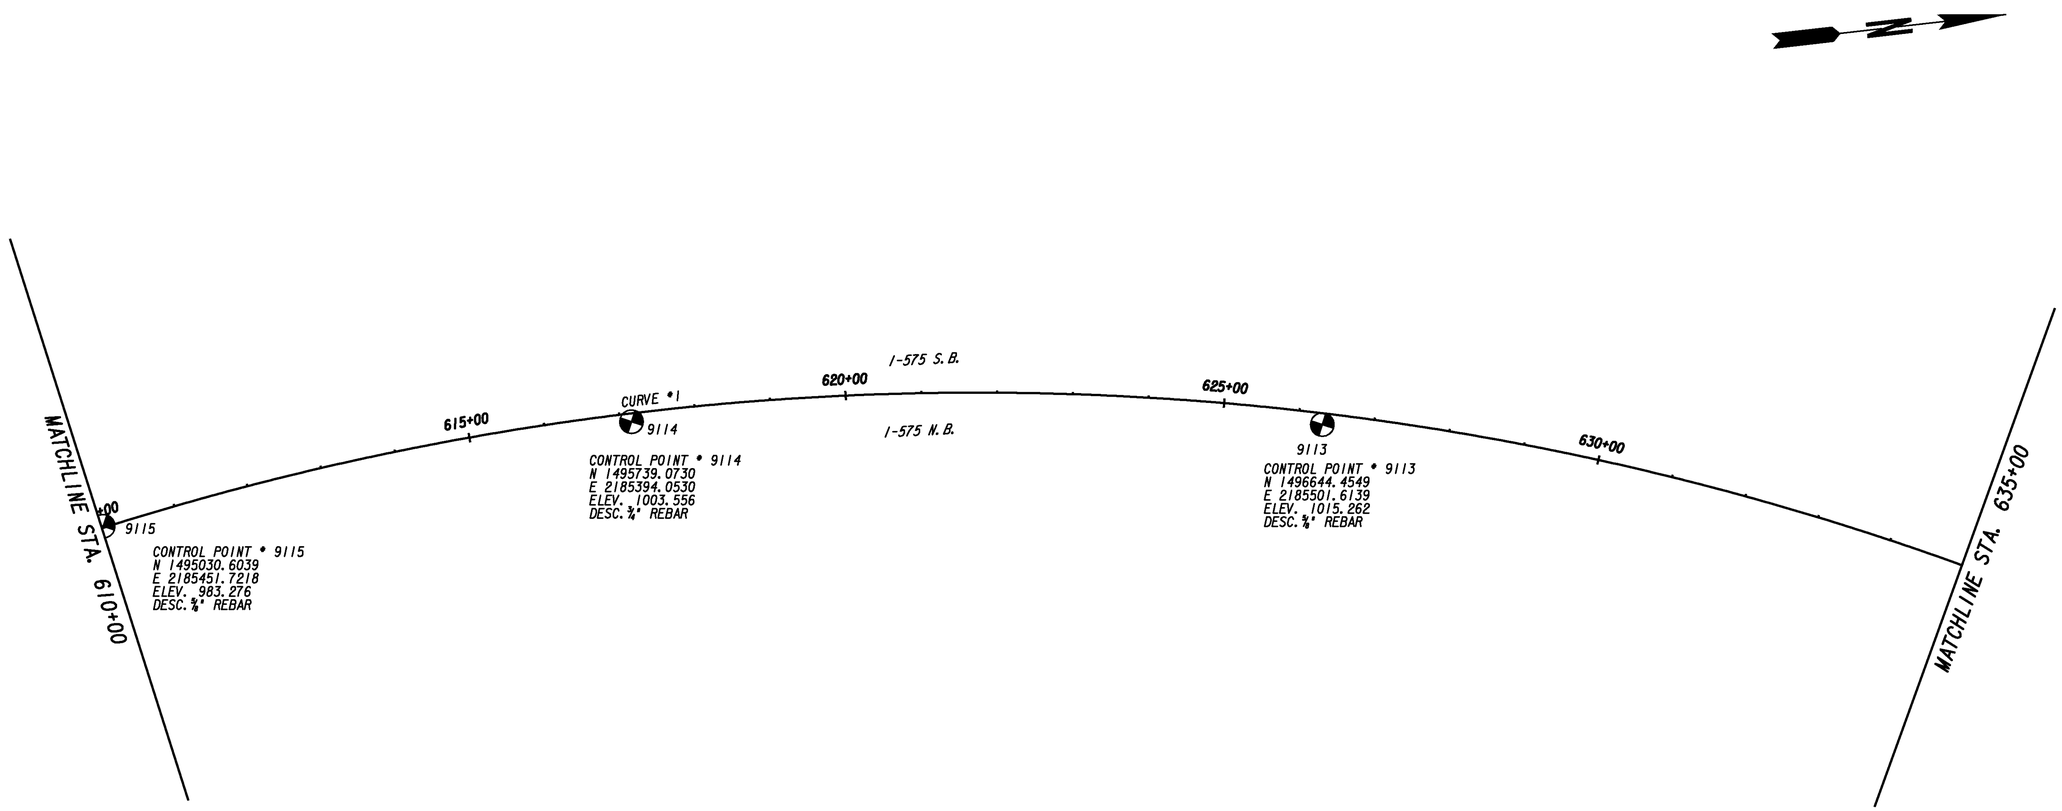

CURVE #1		I-575
P.I. STA.	=	623+68.49
P.I.	= N	1496262.040
	= E	2184843.149
Δ	=	58°58'33"
D	=	1°30'00"
R	=	3819.72'
T	=	2160.03'
L	=	3931.72'
P.C. STA.	=	602+08.46
P.T. STA.	=	641+40.18

PROPERTY AND EXISTING R/W LINE
REQUIRED R/W LINE
CONSTRUCTION LIMITS
EASEMENT FOR CONSTR & MAINTENANCE OF SLOPES
EASEMENT FOR CONSTR OF SLOPES
EASEMENT FOR CONSTR OF DRIVES

BEGIN LIMIT OF ACCESS.....BLA
END LIMIT OF ACCESS.....ELA
LIMIT OF ACCESS
REQ'D R/W & LIMIT OF ACCESS

THE LPA GROUP
TRANSPORTATION CONSULTANTS
3595 ENGINEERING DRIVE
NORCROSS, GEORGIA 30092
(770) 263-9118

SCALE IN FEET
0 100 200 400

REVISION DATES

STATE OF GEORGIA
DEPARTMENT OF TRANSPORTATION
OFFICE: INNOVATIVE PROGRAM DELIVERY

CONSTRUCTION LAYOUT

DRAWING No. 11-002