AS-BUILT PLANS 12/12/12

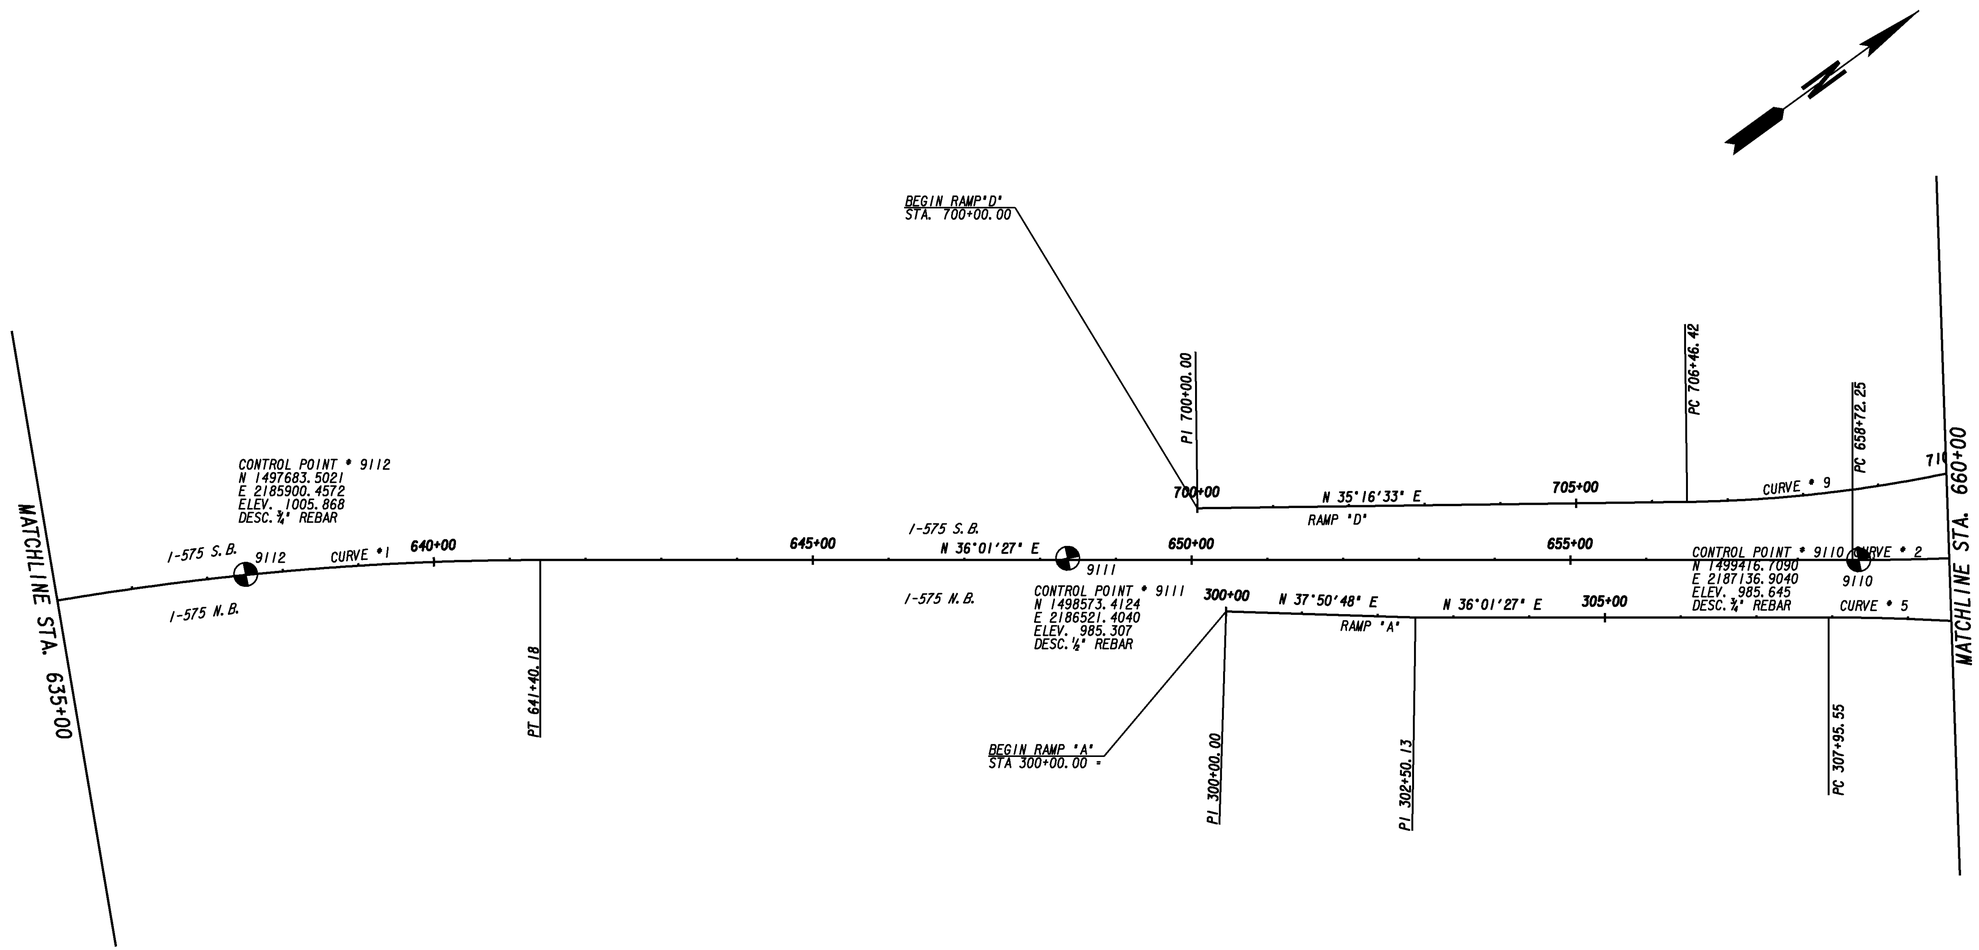

CURVE *1		I-575
P.I. STA.	=	623+68.49
P.I.	= N	1496262.040
	= E	2184843.149
Δ	=	58°58'33"
D	=	1°30'00"
R	=	3819.72'
T	=	2160.03'
L	=	3931.72'
P.C. STA.	=	602+08.46
P.T. STA.	=	641+40.18

CURVE *2		I-575
P.I. STA.	=	669+95.69
P.I.	= N	1500318.451
	= E	2187792.914
Δ	=	-32°46'43"
D	=	1°30'00"
R	=	3819.72'
T	=	1123.43'
L	=	2185.25'
P.C. STA.	=	658+72.25
P.T. STA.	=	680+57.50

CURVE *5		RAMP A
P.I. STA.	=	309+96.58
P.I.	= N	1499502.495
	= E	2187293.529
Δ	=	8°12'48"
D	=	2°02'47"
R	=	2800.00'
T	=	201.03'
L	=	401.38'
P.C. STA.	=	307+95.55
P.T. STA.	=	311+96.93
S.E. RATE	=	5.00%

CURVE *9		RAMP D
P.I. STA.	=	709+56.43
P.I.	= N	1499531.538
	= E	2187120.956
Δ	=	-19°32'40"
D	=	3°10'59"
R	=	1800.00'
T	=	310.01'
L	=	614.00'
P.C. STA.	=	706+46.42
P.T. STA.	=	712+60.42
S.E. RATE	=	6.00%

PROPERTY AND EXISTING R/W LINE
REQUIRED R/W LINE
CONSTRUCTION LIMITS
EASEMENT FOR CONSTR & MAINTENANCE OF SLOPES
EASEMENT FOR CONSTR OF SLOPES
EASEMENT FOR CONSTR OF DRIVES

BEGIN LIMIT OF ACCESS.....BLA
END LIMIT OF ACCESS.....ELA
LIMIT OF ACCESS
REQ'D R/W & LIMIT OF ACCESS

THE LPA GROUP
TRANSPORTATION CONSULTANTS
3595 ENGINEERING DRIVE
NORCROSS, GEORGIA 30092
(770) 263-9118

SCALE IN FEET
0 100 200 400

REVISION DATES

STATE OF GEORGIA
DEPARTMENT OF TRANSPORTATION
OFFICE: INNOVATIVE PROGRAM DELIVERY

CONSTRUCTION LAYOUT

DRAWING No. 11-003