AS-BUILT PLANS 12/12/12

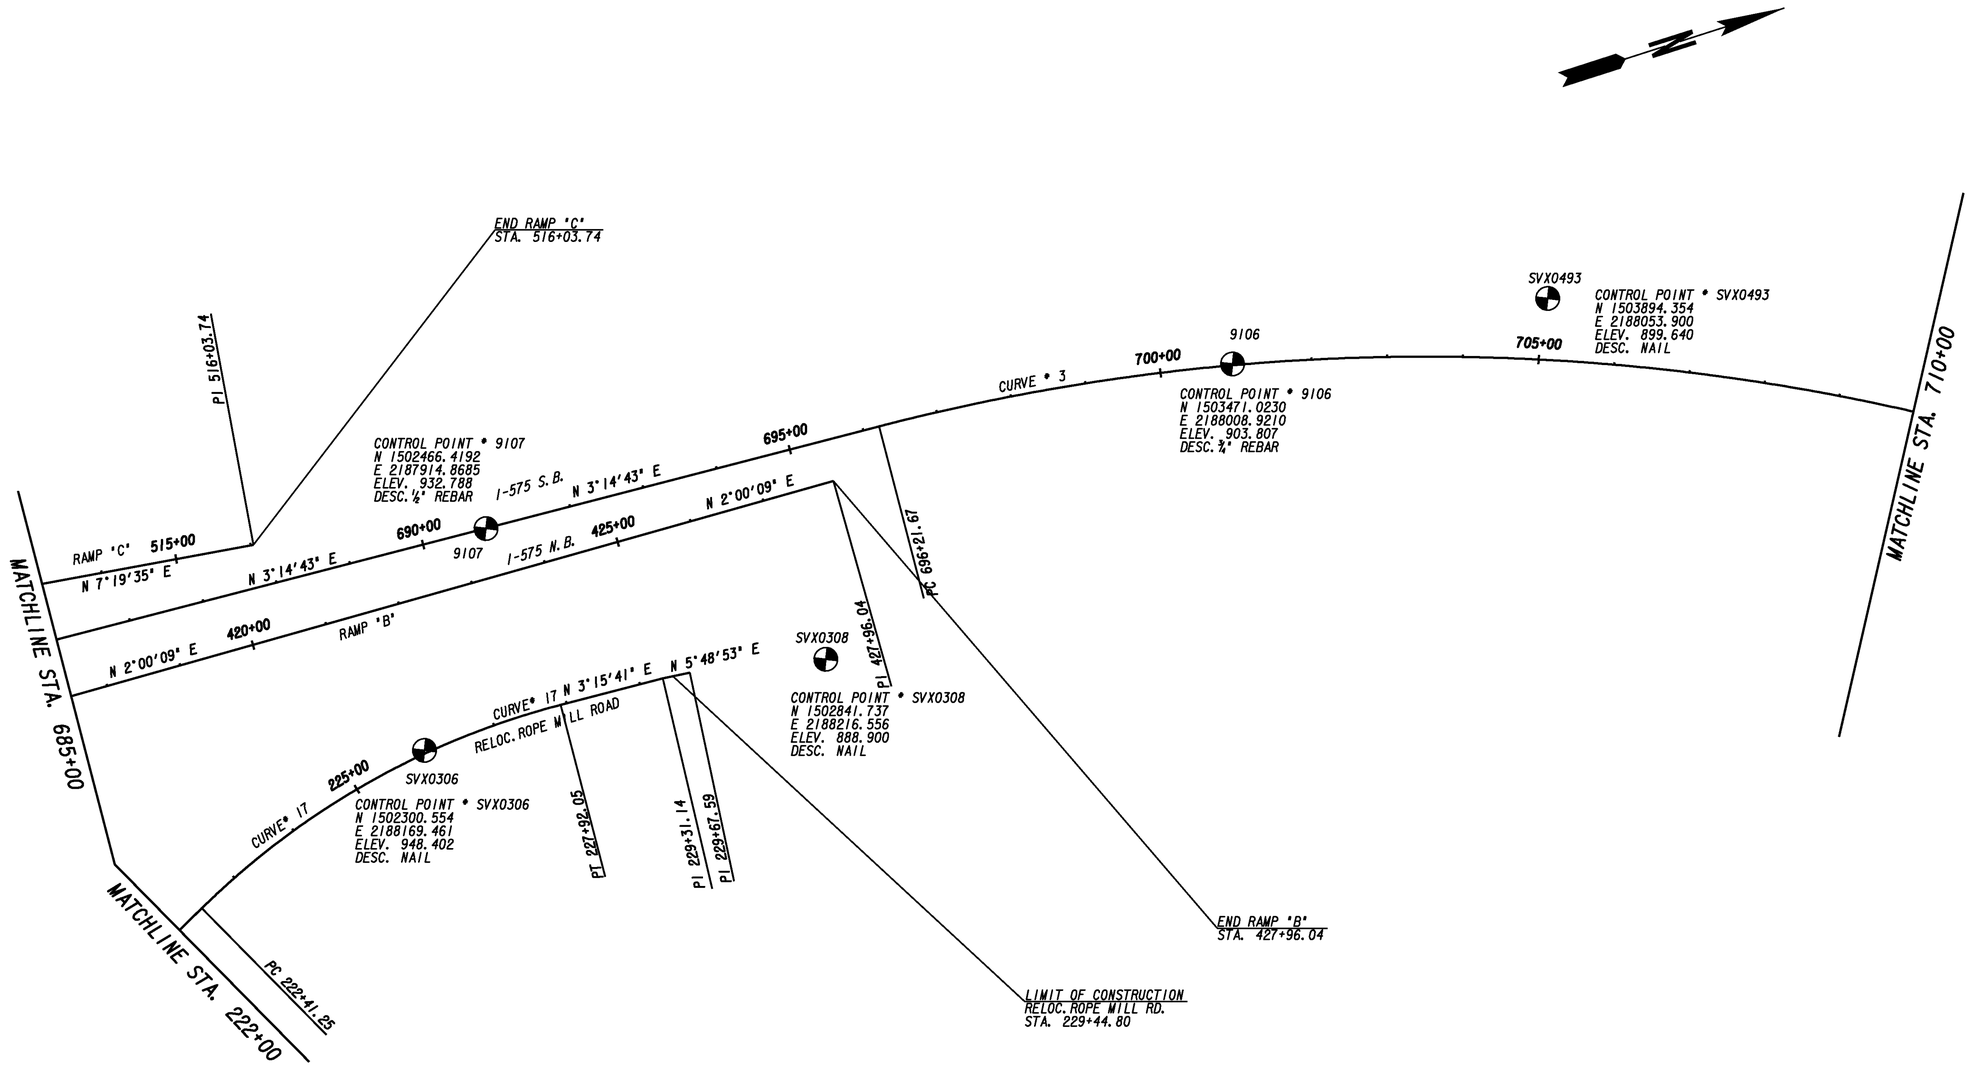

CURVE *3		I-575
P. I. STA.	=	705+30.02
P. I.	= N	1503908.635
	= E	2187996.490
Δ	=	35°00'38"
D	=	1°59'22"
R	=	2880.00'
T	=	908.35'
L	=	1759.82'
P. C. STA.	=	696+21.67
P. T. STA.	=	713+81.49

CURVE *17		RELOC. ROPE MILL ROAD
P. I. STA.	=	225+23.15
P. I.	= N	1502207.937
	= E	2188150.606
Δ	=	30°03'21"
D	=	5°27'24"
R	=	1050.00'
T	=	281.89'
L	=	550.80'
P. C. STA.	=	222+41.25
P. T. STA.	=	227+92.05
S. E. RATE	=	3.05%

PROPERTY AND EXISTING R/W LINE
REQUIRED R/W LINE
CONSTRUCTION LIMITS
EASEMENT FOR CONSTR & MAINTENANCE OF SLOPES
EASEMENT FOR CONSTR OF SLOPES
EASEMENT FOR CONSTR OF DRIVES

BEGIN LIMIT OF ACCESS.....BLA
END LIMIT OF ACCESS.....ELA
LIMIT OF ACCESS
REQ'D R/W & LIMIT OF ACCESS

THE LPA GROUP
TRANSPORTATION CONSULTANTS
3595 ENGINEERING DRIVE
NORCROSS, GEORGIA 30092
(770) 263-9118

SCALE IN FEET
0 100 200 400

REVISION DATES

STATE OF GEORGIA
DEPARTMENT OF TRANSPORTATION
OFFICE: INNOVATIVE PROGRAM DELIVERY

CONSTRUCTION LAYOUT

DRAWING No. 11-005

1/5/2009 GPLN