AS-BUILT PLANS 12/12/12

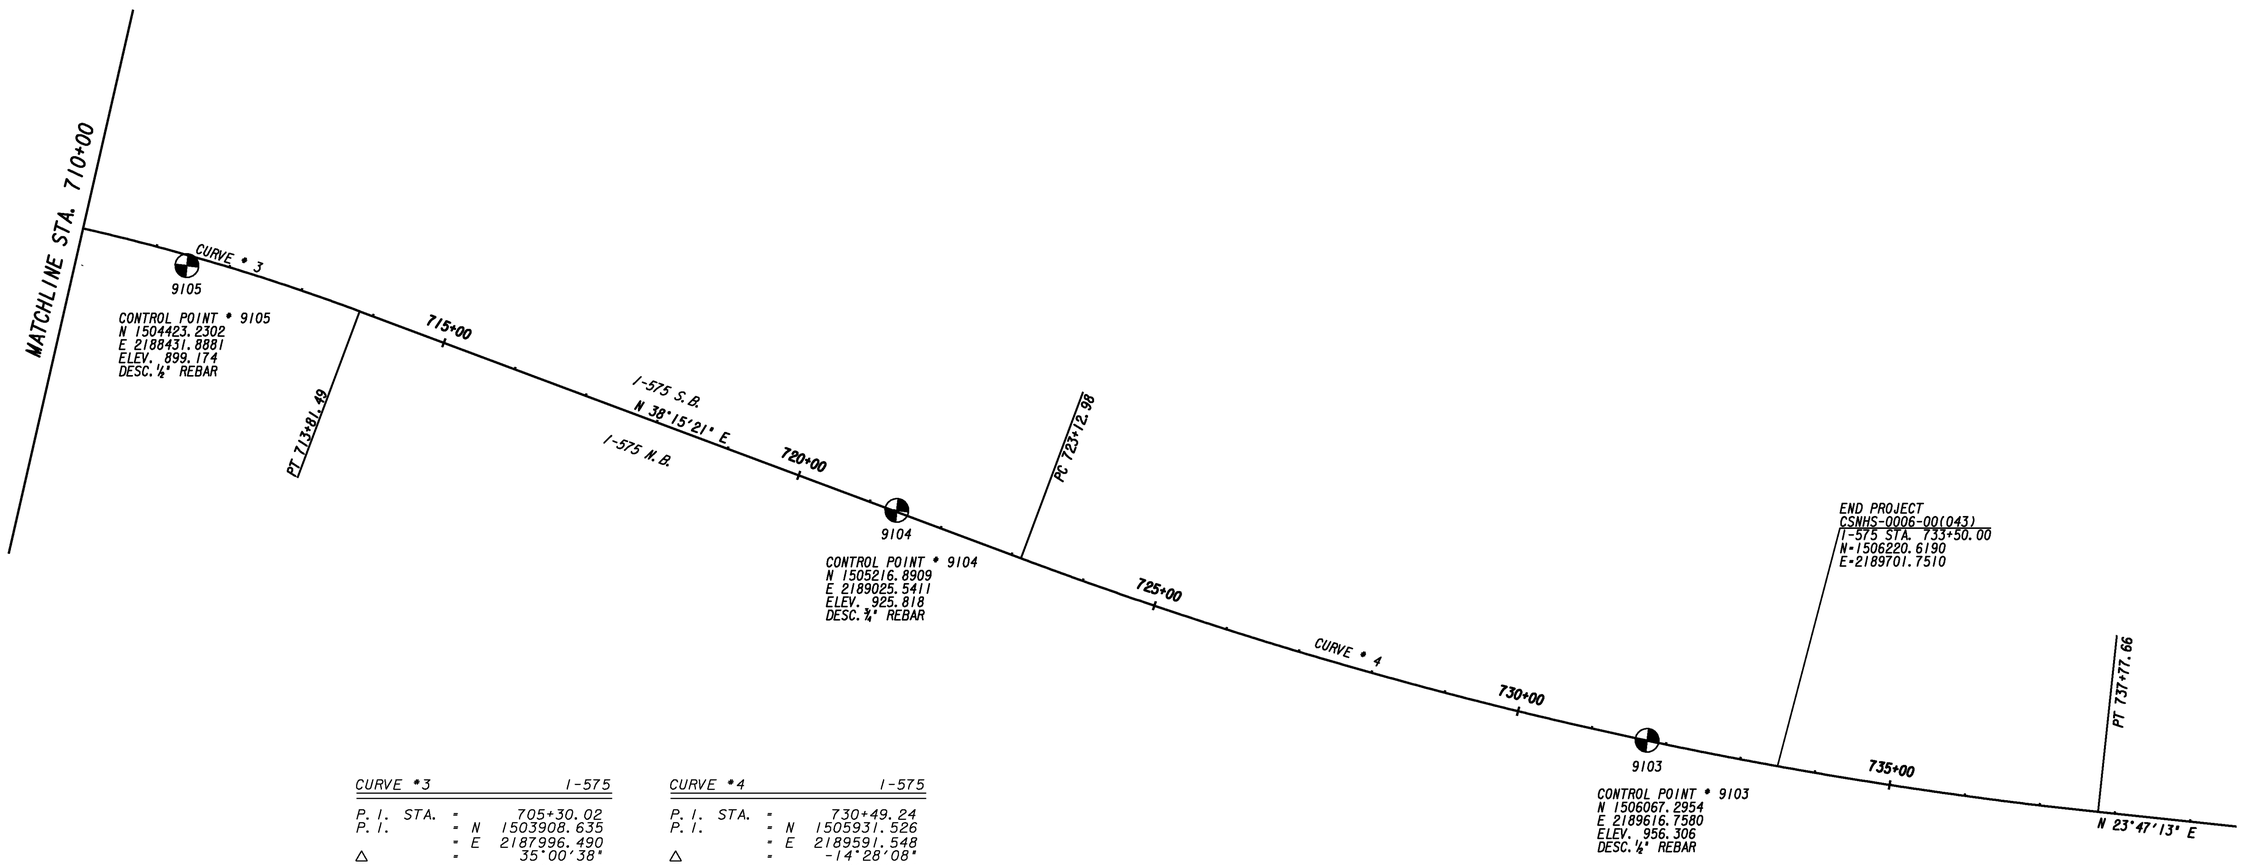

CURVE #3		I-575
P.I. STA.	=	705+30.02
P.I.	= N	1503908.635
	= E	2187996.490
Δ	=	35°00'38"
D	=	1°59'22"
R	=	2880.00'
T	=	908.35'
L	=	1759.82'
P.C. STA.	=	696+21.67
P.T. STA.	=	713+81.49

CURVE #4		I-575
P.I. STA.	=	730+49.24
P.I.	= N	1505931.526
	= E	2189591.548
Δ	=	-14°28'08"
D	=	0°59'16"
R	=	5800.00'
T	=	736.26'
L	=	1464.68'
P.C. STA.	=	723+12.98
P.T. STA.	=	737+77.66

PROPERTY AND EXISTING R/W LINE
REQUIRED R/W LINE
CONSTRUCTION LIMITS
EASEMENT FOR CONSTR & MAINTENANCE OF SLOPES
EASEMENT FOR CONSTR OF SLOPES
EASEMENT FOR CONSTR OF DRIVES

BEGIN LIMIT OF ACCESS.....BLA
END LIMIT OF ACCESS.....ELA
LIMIT OF ACCESS
REQ'D R/W & LIMIT OF ACCESS

THE LPA GROUP
TRANSPORTATION CONSULTANTS
3595 ENGINEERING DRIVE
NORCROSS, GEORGIA 30092
(770) 263-9118

SCALE IN FEET
0 100 200 400

REVISION DATES

STATE OF GEORGIA
DEPARTMENT OF TRANSPORTATION
OFFICE: INNOVATIVE PROGRAM DELIVERY

CONSTRUCTION LAYOUT

DRAWING No. 11-006

1/5/2009 GPLN