AS-BUILT PLANS 12/12/12

**CURVE #12 RIDGEWALK PARKWAY**

| | | |
|---|---|---|
| P.I. STA. | = | 105+52.82 |
| P.I. | = | N 1500864.449 |
| | = | E 2187206.395 |
| Δ | = | -51°25'37" |
| D | = | 8°03'31" |
| R | = | 711.00' |
| T | = | 342.39' |
| L | = | 638.17' |
| P.C. STA. | = | 102+10.43 |
| P.T. STA. | = | 108+48.60 |
| S.E. RATE | = | 4.00% |

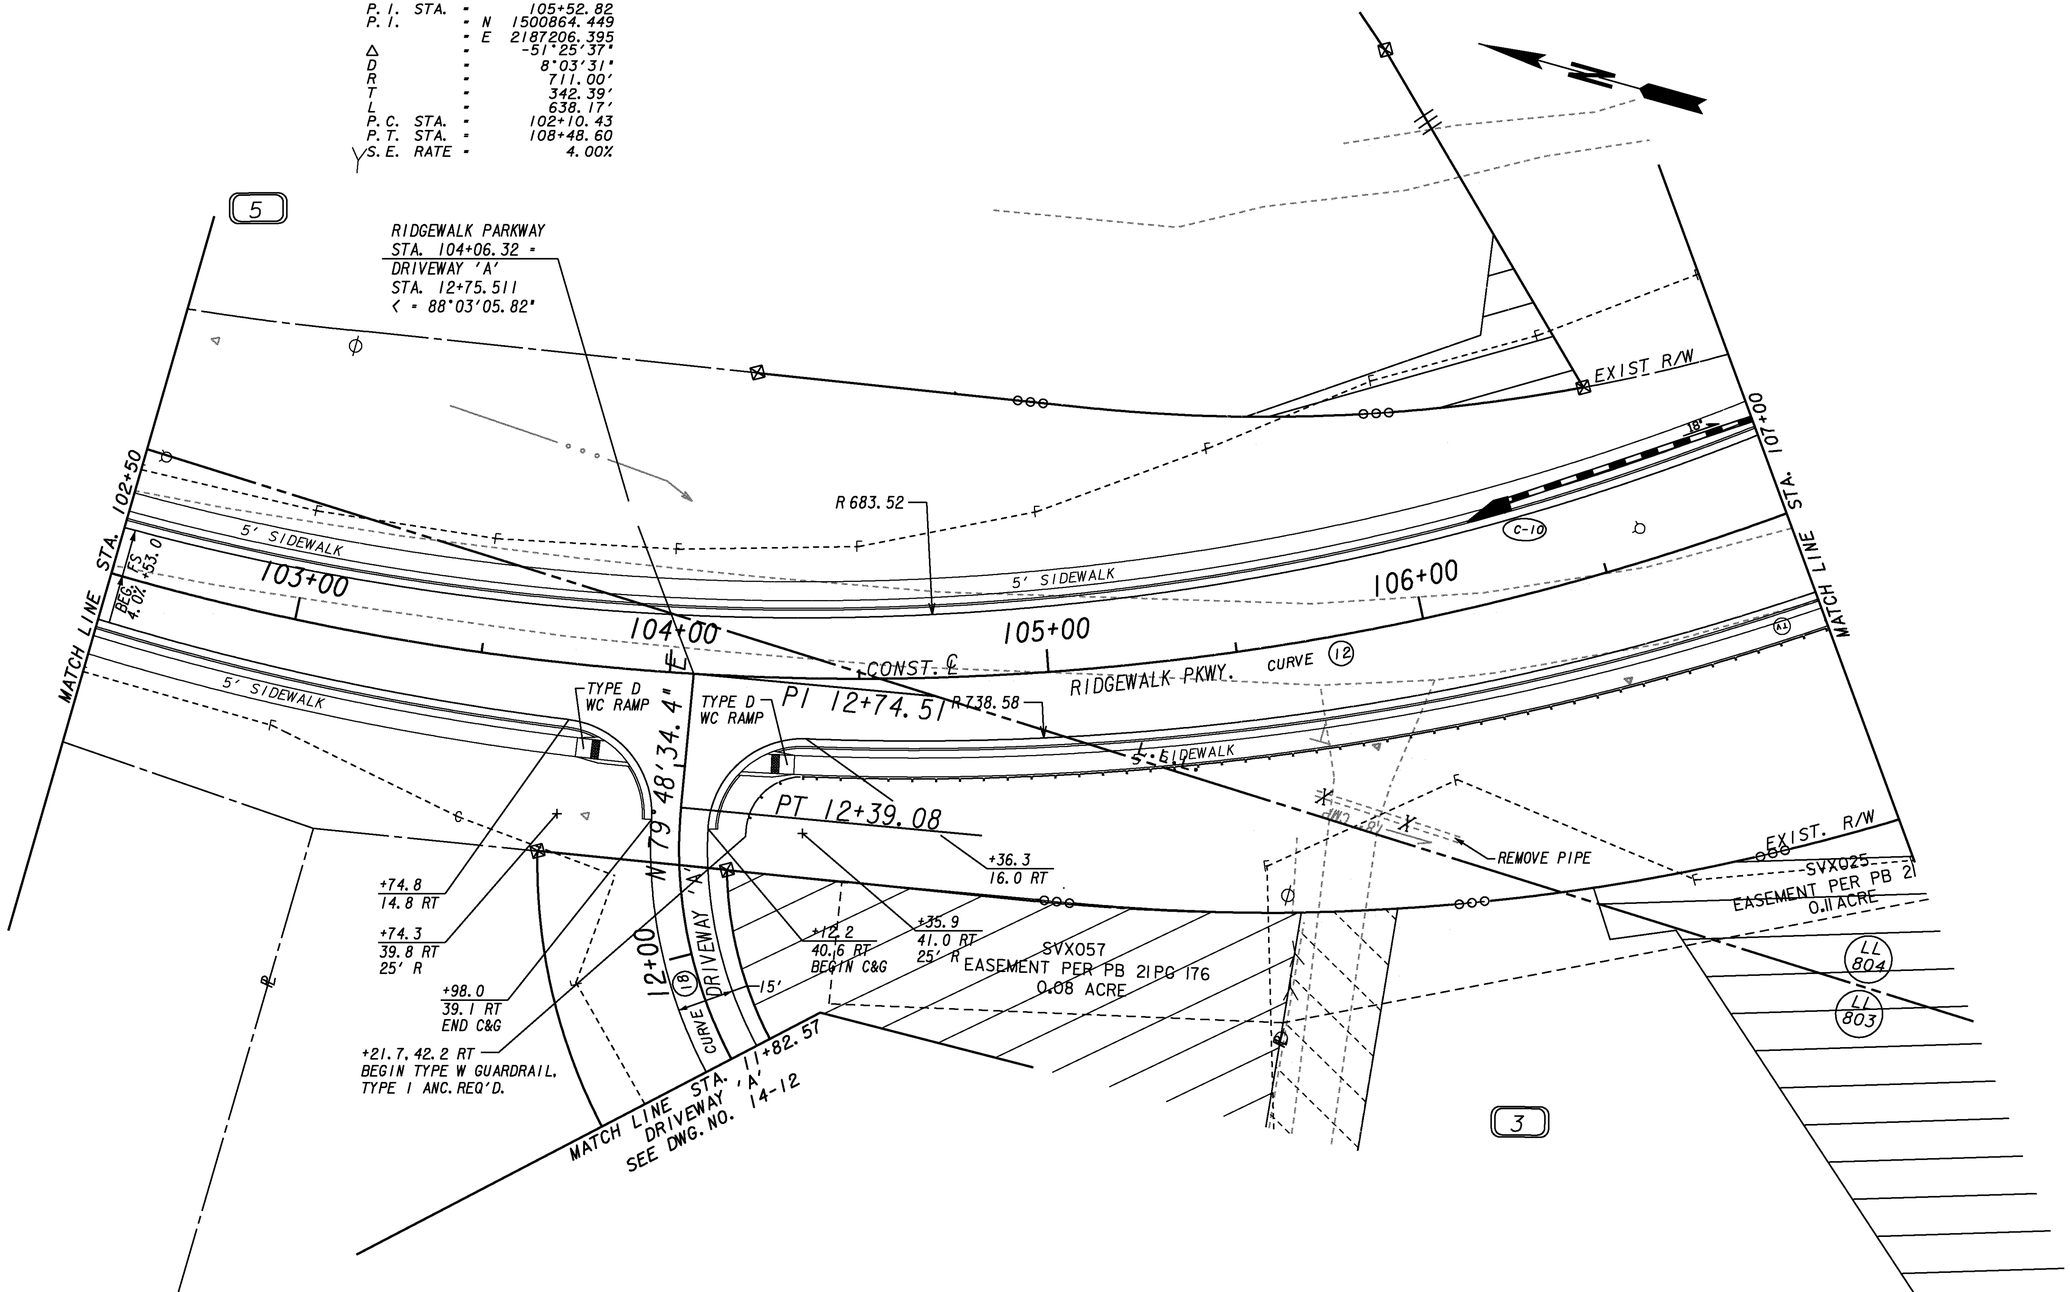


| | | |
|---|---|---|
| PROPERTY AND EXISTING R/W LINE | BEGIN LIMIT OF ACCESS.....BLA | |
| REQUIRED R/W LINE | END LIMIT OF ACCESS.....ELA | |
| CONSTRUCTION LIMITS | LIMIT OF ACCESS | |
| EASEMENT FOR CONSTR & MAINTENANCE OF SLOPES | REQ'D R/W & LIMIT OF ACCESS | |
| EASEMENT FOR CONSTR OF SLOPES | | |
| EASEMENT FOR CONSTR OF DRIVES | | |

THE LPA GROUP
TRANSPORTATION CONSULTANTS
3595 ENGINEERING DRIVE
NORCROSS, GEORGIA 30092
(770) 263-9118

SCALE IN FEET
0 20 40 80

REVISION DATES

STATE OF GEORGIA
DEPARTMENT OF TRANSPORTATION
OFFICE: INNOVATIVE PROGRAM DELIVERY

**CROSSROAD PLAN**

RIDGEWALK PARKWAY
STA. 102+50 TO STA. 107+00

DRAWING No. 14-002

1/5/2009 GPLN