AS-BUILT PLANS 12/12/12

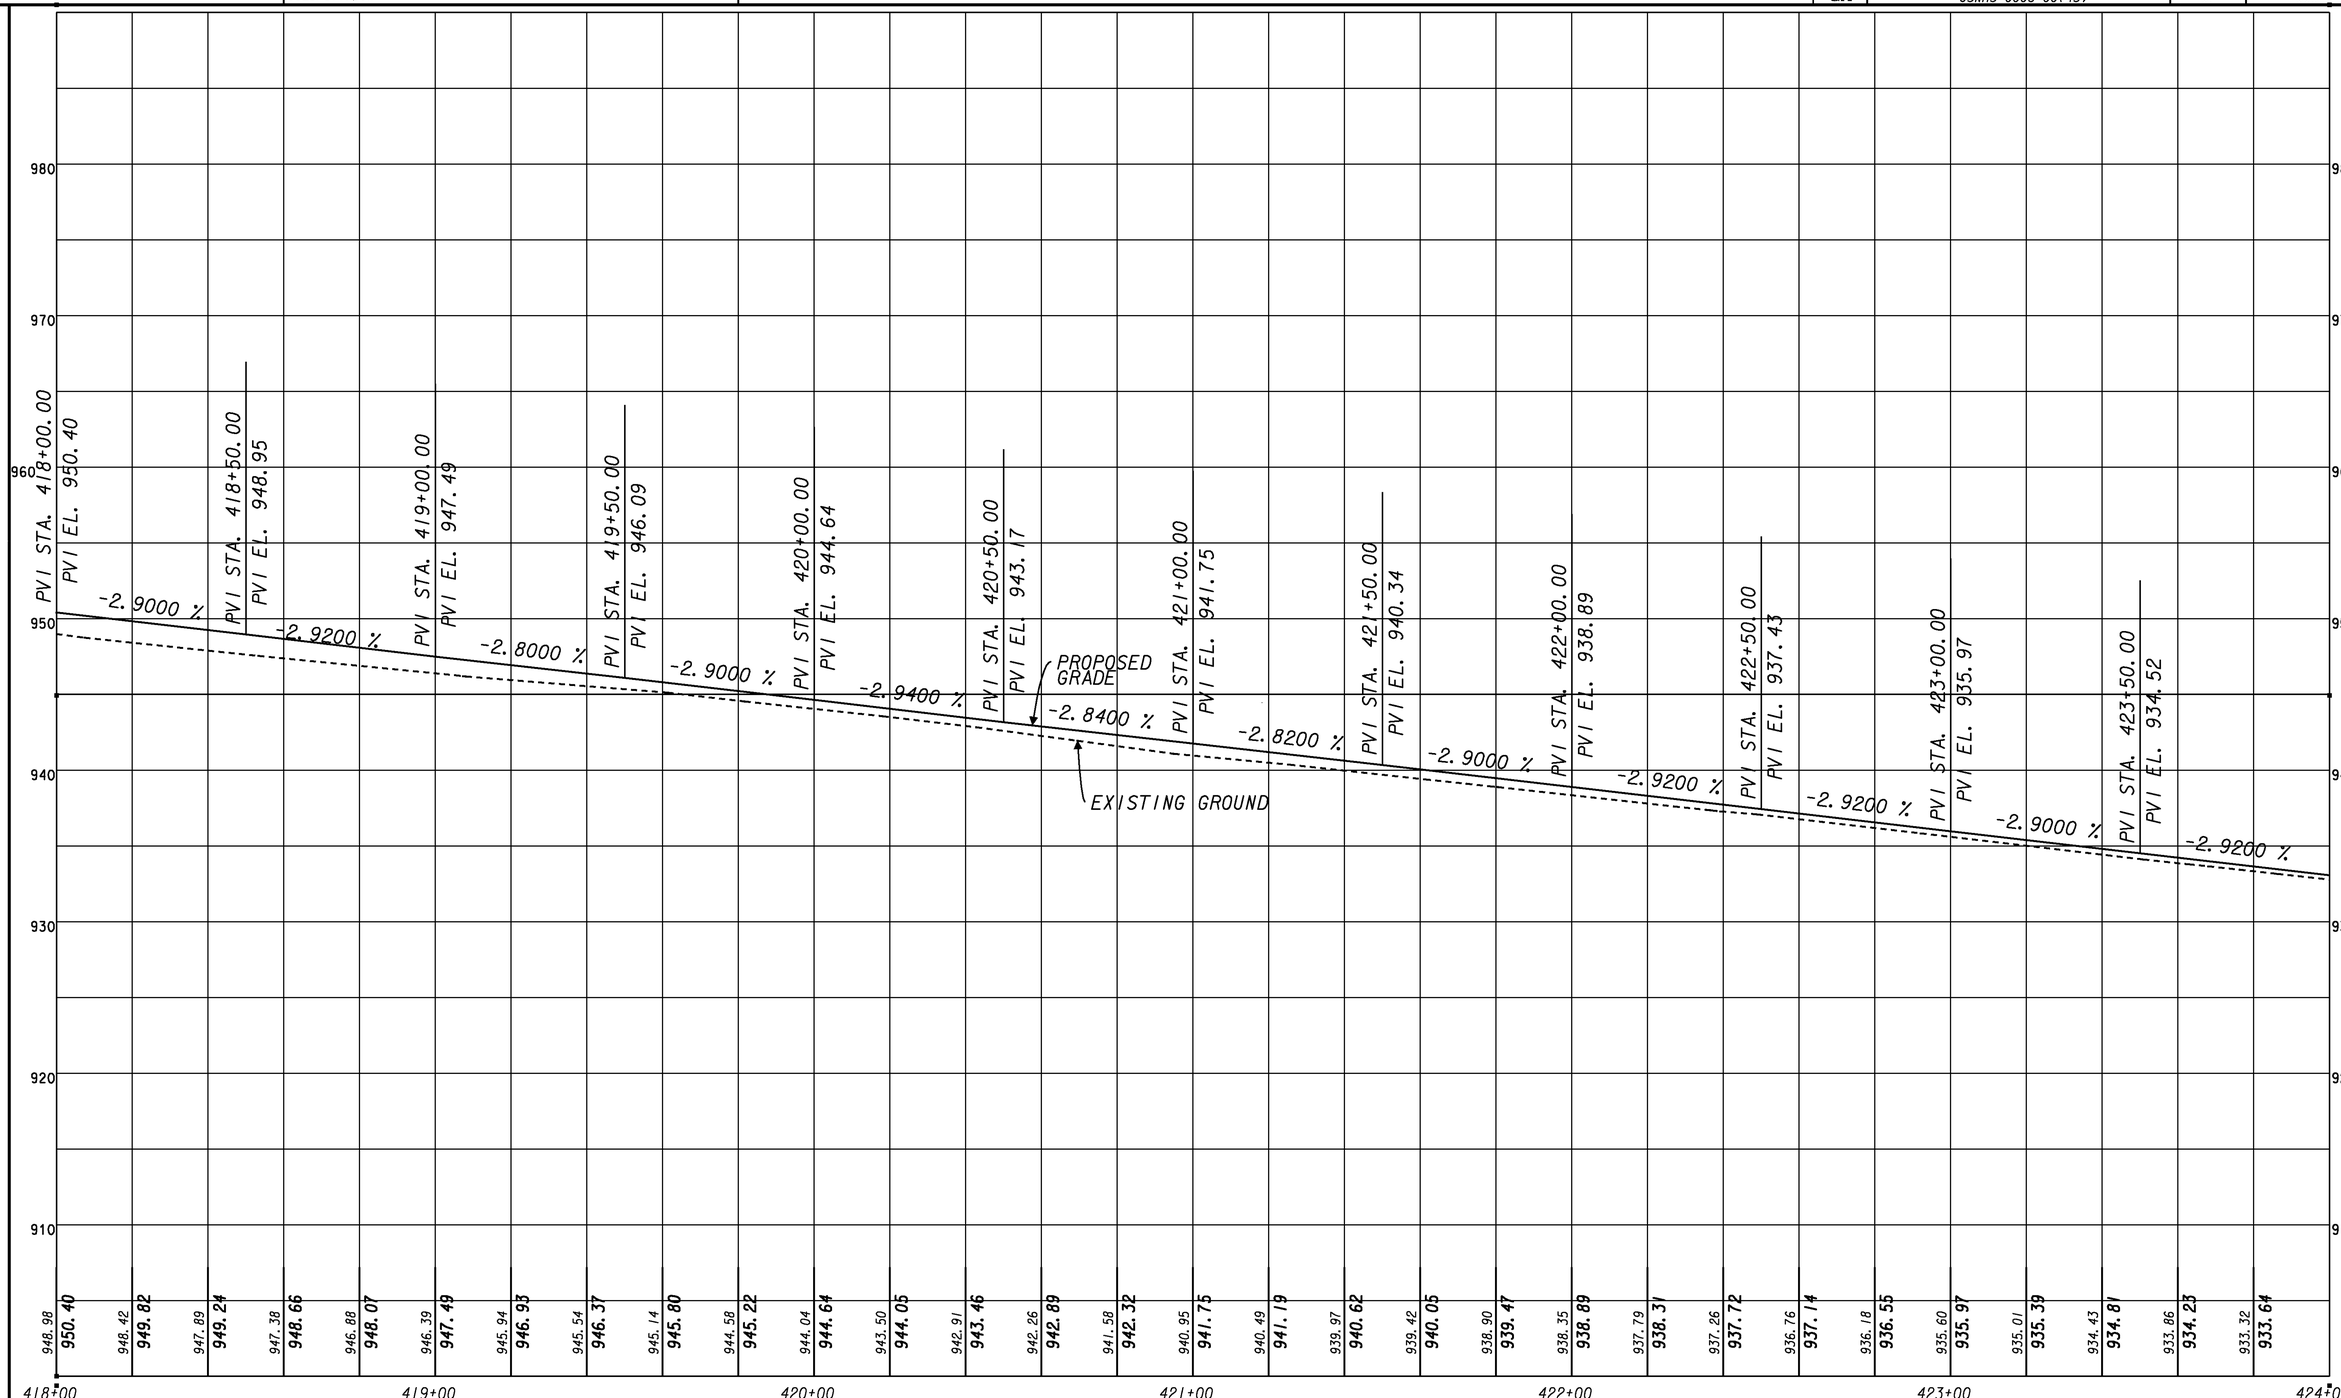

THE LPA GROUP
TRANSPORTATION CONSULTANTS
3595 ENGINEERING DRIVE
NORCROSS, GEORGIA 30092
(770) 263-9118

SCALE 1 Inch = 5 feet Vert.
SCALE 1 Inch = 20 feet Horiz.

REVISION DATES

STATE OF GEORGIA
DEPARTMENT OF TRANSPORTATION
OFFICE: INNOVATIVE PROGRAM DELIVERY

CROSSROAD PROFILE

RAMP "B"

DRAWING No. 16-015

1/5/2009 GRIEDG