AS-BUILT PLANS 12/12/12

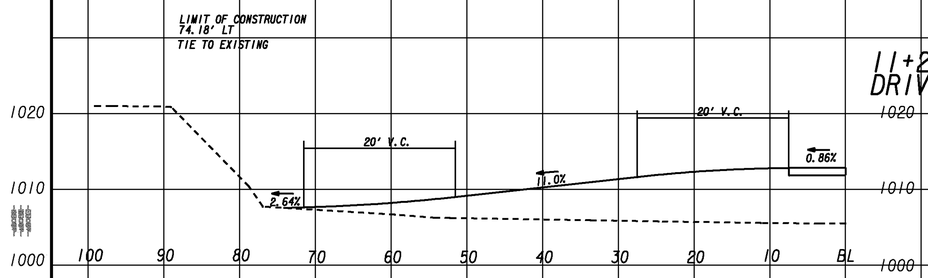

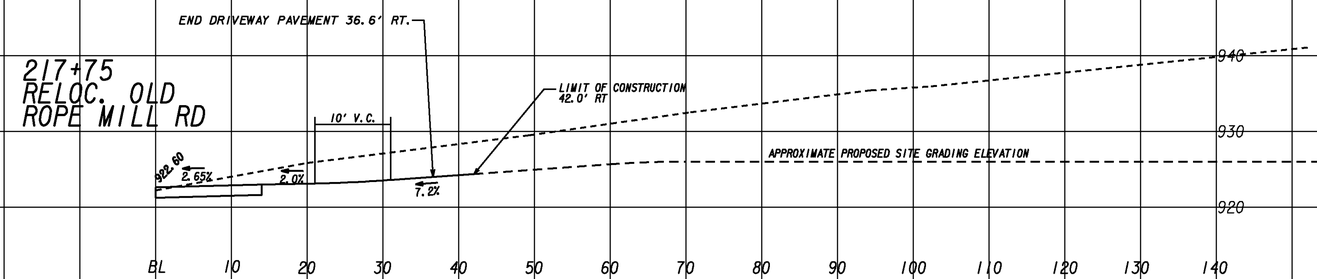

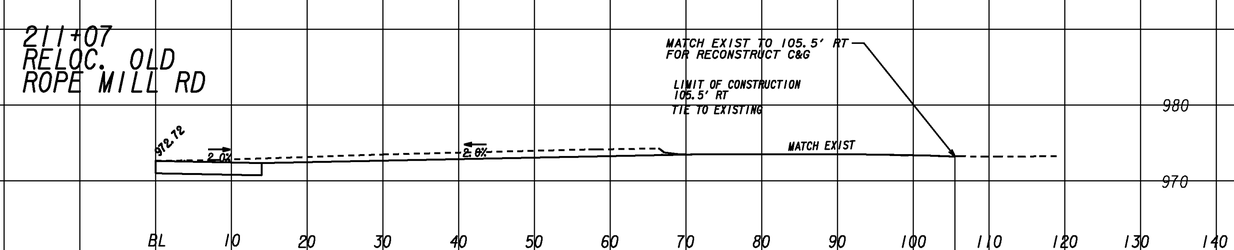

THE LPA GROUP
TRANSPORTATION CONSULTANTS
3595 ENGINEERING DRIVE
NORCROSS, GEORGIA 30092
(770) 263-9118

REVISION DATES
03-29-11

STATE OF GEORGIA
DEPARTMENT OF TRANSPORTATION
OFFICE: INNOVATIVE PROGRAM DELIVERY

DRIVEWAY PROFILES

RIDGEWALK PARKWAY
OLD ROPE MILL ROAD

DRAWING No. 17-002

3/1/2007 SUXSEW