Chad. Havens

AS-BUILT PLANS 12/12/12

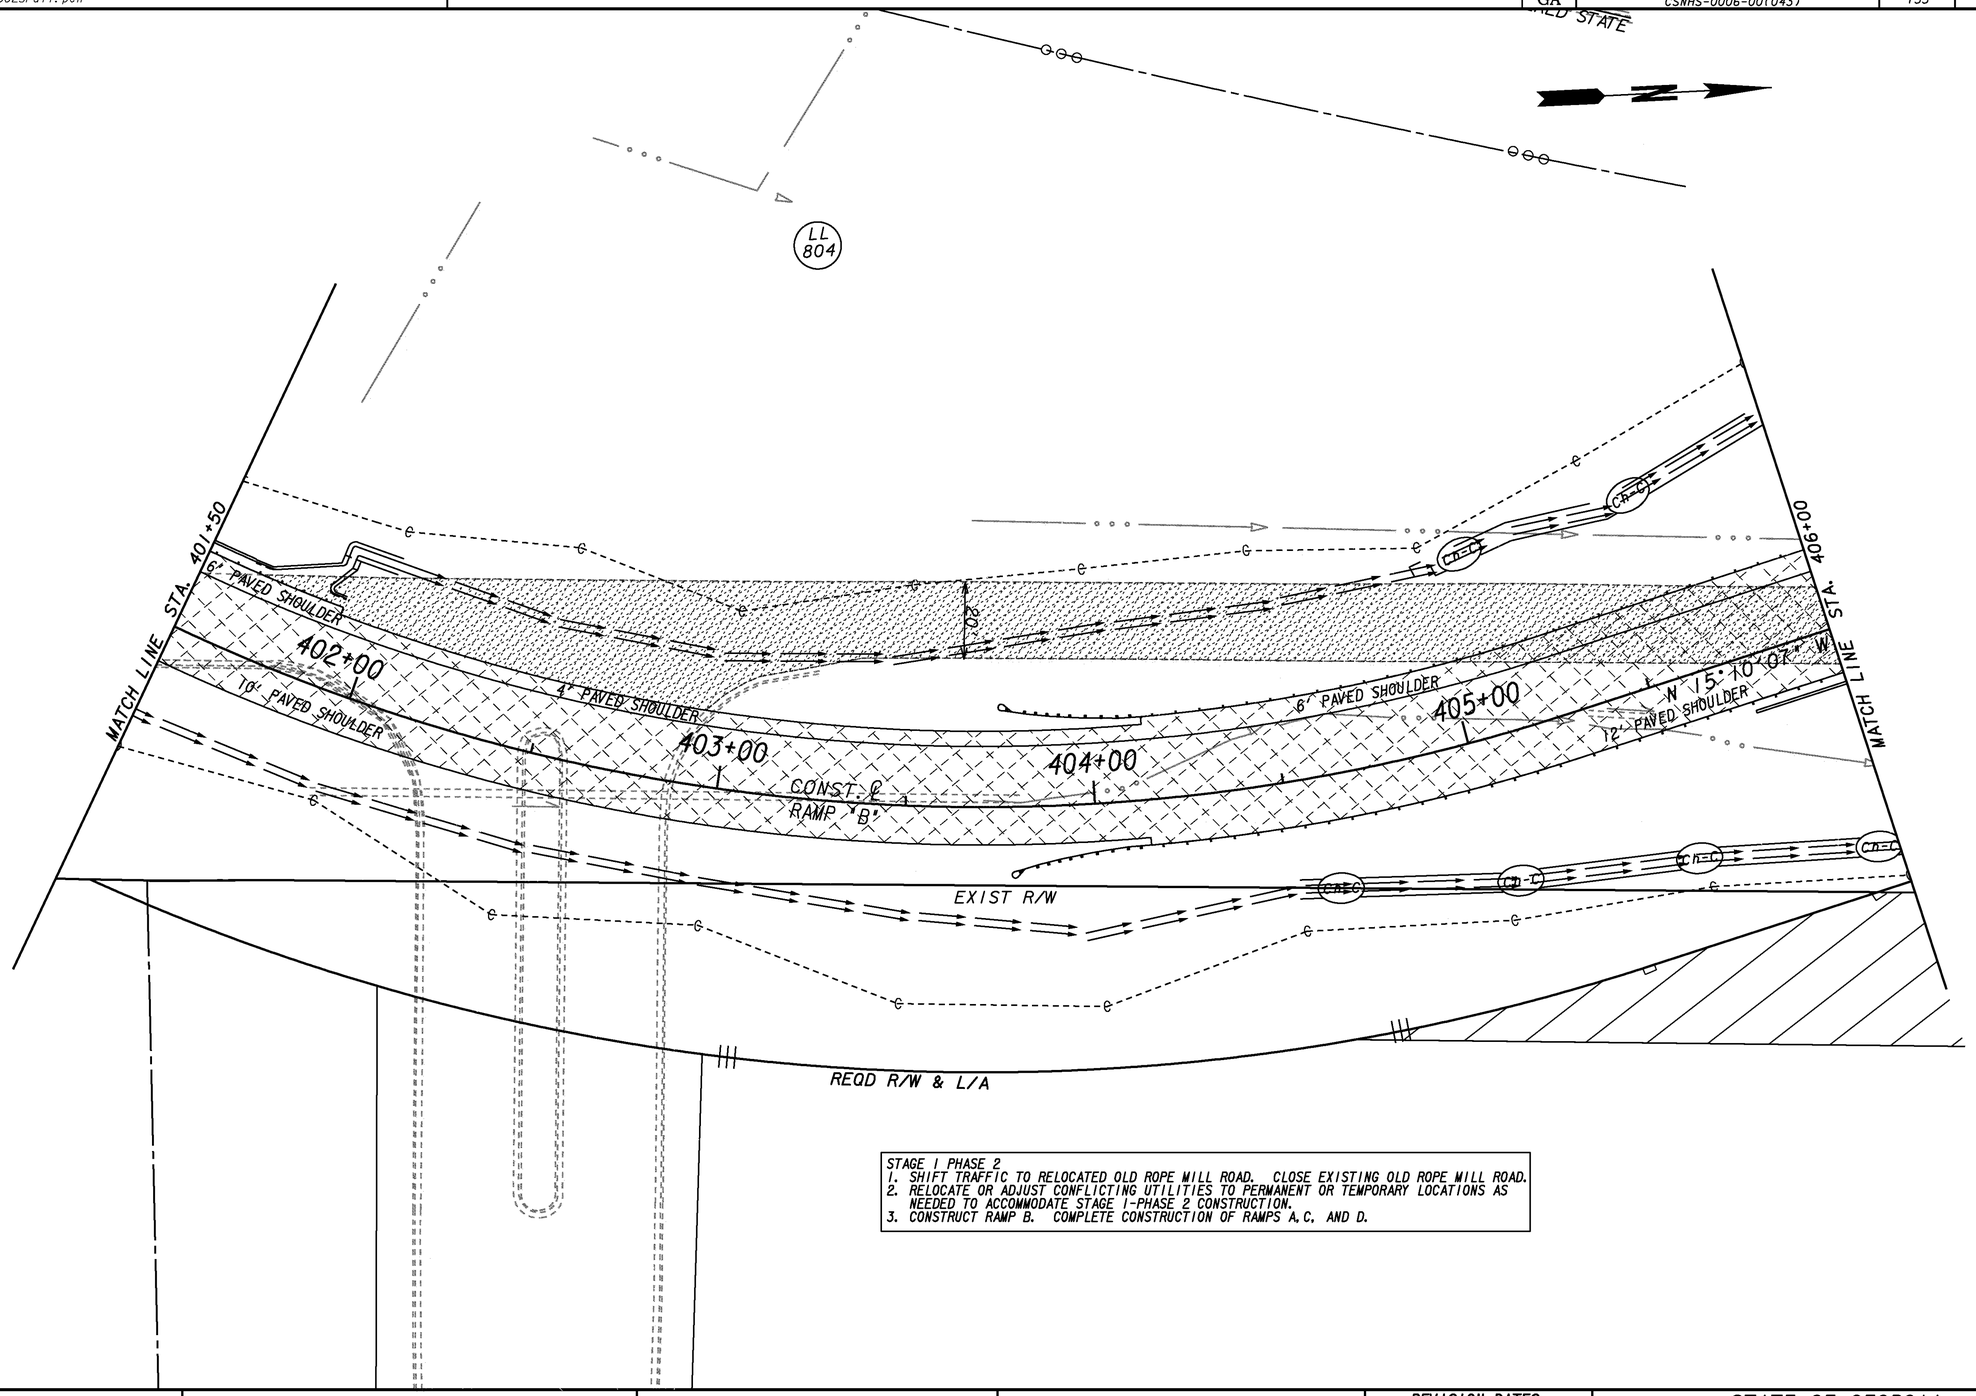

STAGE 1 PHASE 2
1. SHIFT TRAFFIC TO RELOCATED OLD ROPE MILL ROAD. CLOSE EXISTING OLD ROPE MILL ROAD.
2. RELOCATE OR ADJUST CONFLICTING UTILITIES TO PERMANENT OR TEMPORARY LOCATIONS AS NEEDED TO ACCOMMODATE STAGE 1-PHASE 2 CONSTRUCTION.
3. CONSTRUCT RAMP B. COMPLETE CONSTRUCTION OF RAMPS A, C, AND D.

LEGEND

- PAVEMENT REMOVAL
- TEMPORARY CONSTRUCTION PAVEMENT
- PERMANENT CONSTRUCTION
- CONCRETE MEDIAN CONSTRUCTION
- MILL & OVERLAY CONSTRUCTION
- OPEN LANES OF TRAFFIC

STAGE 1 PHASE 2

THE LPA GROUP
TRANSPORTATION CONSULTANTS
3595 ENGINEERING DRIVE
NORCROSS, GEORGIA 30092
(770) 263-9118

SCALE IN FEET
0 20 40 80

REVISION DATES

STATE OF GEORGIA
DEPARTMENT OF TRANSPORTATION
OFFICE: INNOVATIVE PROGRAM DELIVERY

CONSTRUCTION STAGING PLAN

I-575 NB ENTRANCE RAMP B
STA. 401+50 TO STA. 406+00

DRAWING No. 19-054

1/5/2009 GPLH