STATE	PROJECT NUMBER	SHEET NO.	TOTAL SHEETS
GA	CSNHS-0006-00(043)	160	668

AS-BUILT PLANS 12/12/12

STAGE 2
1. RELOCATE OR ADJUST CONFLICTING UTILITIES TO PERMANENT OR TEMPORARY LOCATIONS AS NEEDED TO ACCOMMODATE STAGE 2 CONSTRUCTION.
2. SHIFT TRAFFIC TO WESTBOUND (NORTHERN) HALF OF BRIDGE. PLACE TEMPORARY BARRIER AND STRIPING AND MAINTAIN TWO LANES OF TRAFFIC.
3. PROVIDE TEMPORARY SHORING AS NECESSARY FOR STAGE 2 CONSTRUCTION. REMOVE EXISTING BRIDGE.
4. CONSTRUCT EASTBOUND (SOUTHERN) HALF OF NEW BRIDGE OVER I-575, INCLUDING ABUTMENT WALLS AND APPROACH SLABS.
5. CONSTRUCT EASTBOUND (SOUTHERN) HALF OF RIDGEWALK PARKWAY UP TO AND INCLUDING INTERMEDIATE SURFACE. CONSTRUCT PERMANENT OR TEMPORARY SIGNALIZATION AS NEEDED TO ACCOMMODATE STAGE 2 CONSTRUCTION.

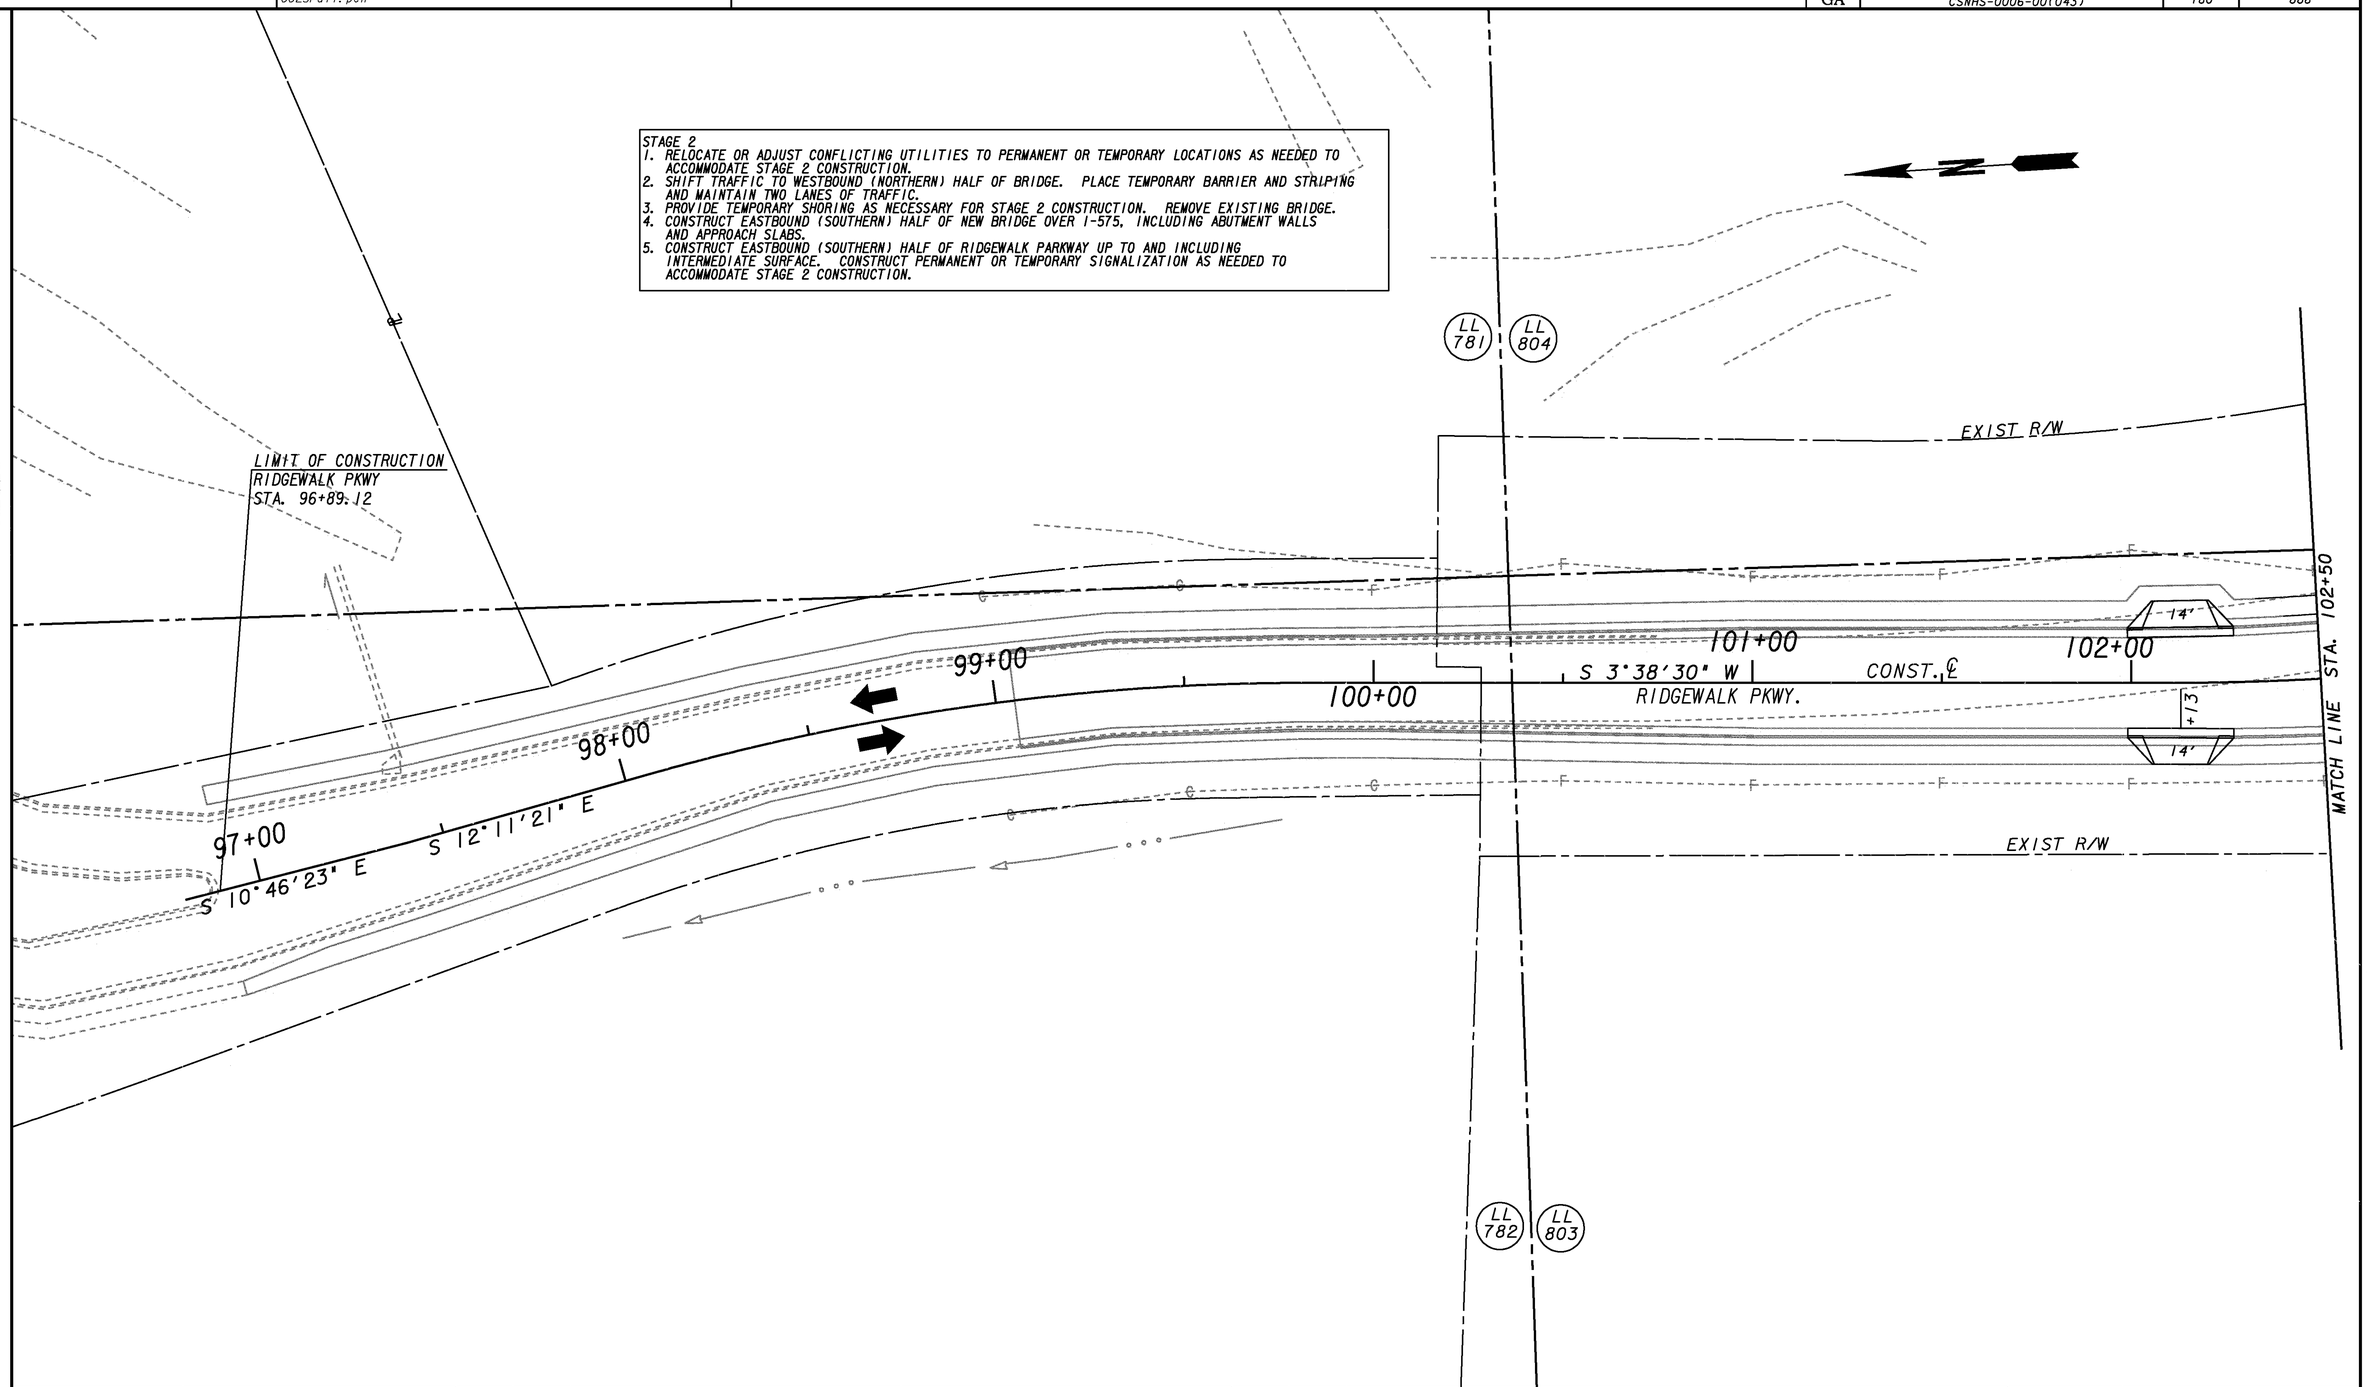

LEGEND

- PAVEMENT REMOVAL
- TEMPORARY CONSTRUCTION PAVEMENT
- PERMANENT CONSTRUCTION
- CONCRETE MEDIAN CONSTRUCTION
- MILL & OVERLAY CONSTRUCTION
- OPEN LANES OF TRAFFIC

STAGE 2

THE LPA GROUP
TRANSPORTATION CONSULTANTS
3595 ENGINEERING DRIVE
NORCROSS, GEORGIA 30092
(770) 263-9118

SCALE IN FEET
0 20 40 80

REVISION DATES

STATE OF GEORGIA
DEPARTMENT OF TRANSPORTATION
OFFICE: INNOVATIVE PROGRAM DELIVERY

CONSTRUCTION STAGING PLAN

RIDGEWALK PARKWAY
BEGIN CONST. TO STA. 102+50

DRAWING No. 19-059