STATE	PROJECT NUMBER	SHEET NO.	TOTAL SHEETS
GA	CSNHS-0006-00(043)	178	668

AS-BUILT PLANS 12/12/12

STAGE 3
1. SHIFT RIDGEWALK PARKWAY TRAFFIC TO NEW EASTBOUND AND WESTBOUND ALIGNMENT.
2. COMPLETE BRIDGE AND CONCRETE MEDIAN CONSTRUCTION.
3. CONSTRUCT FINAL PAVEMENT SURFACE AND PAVEMENT MARKING.

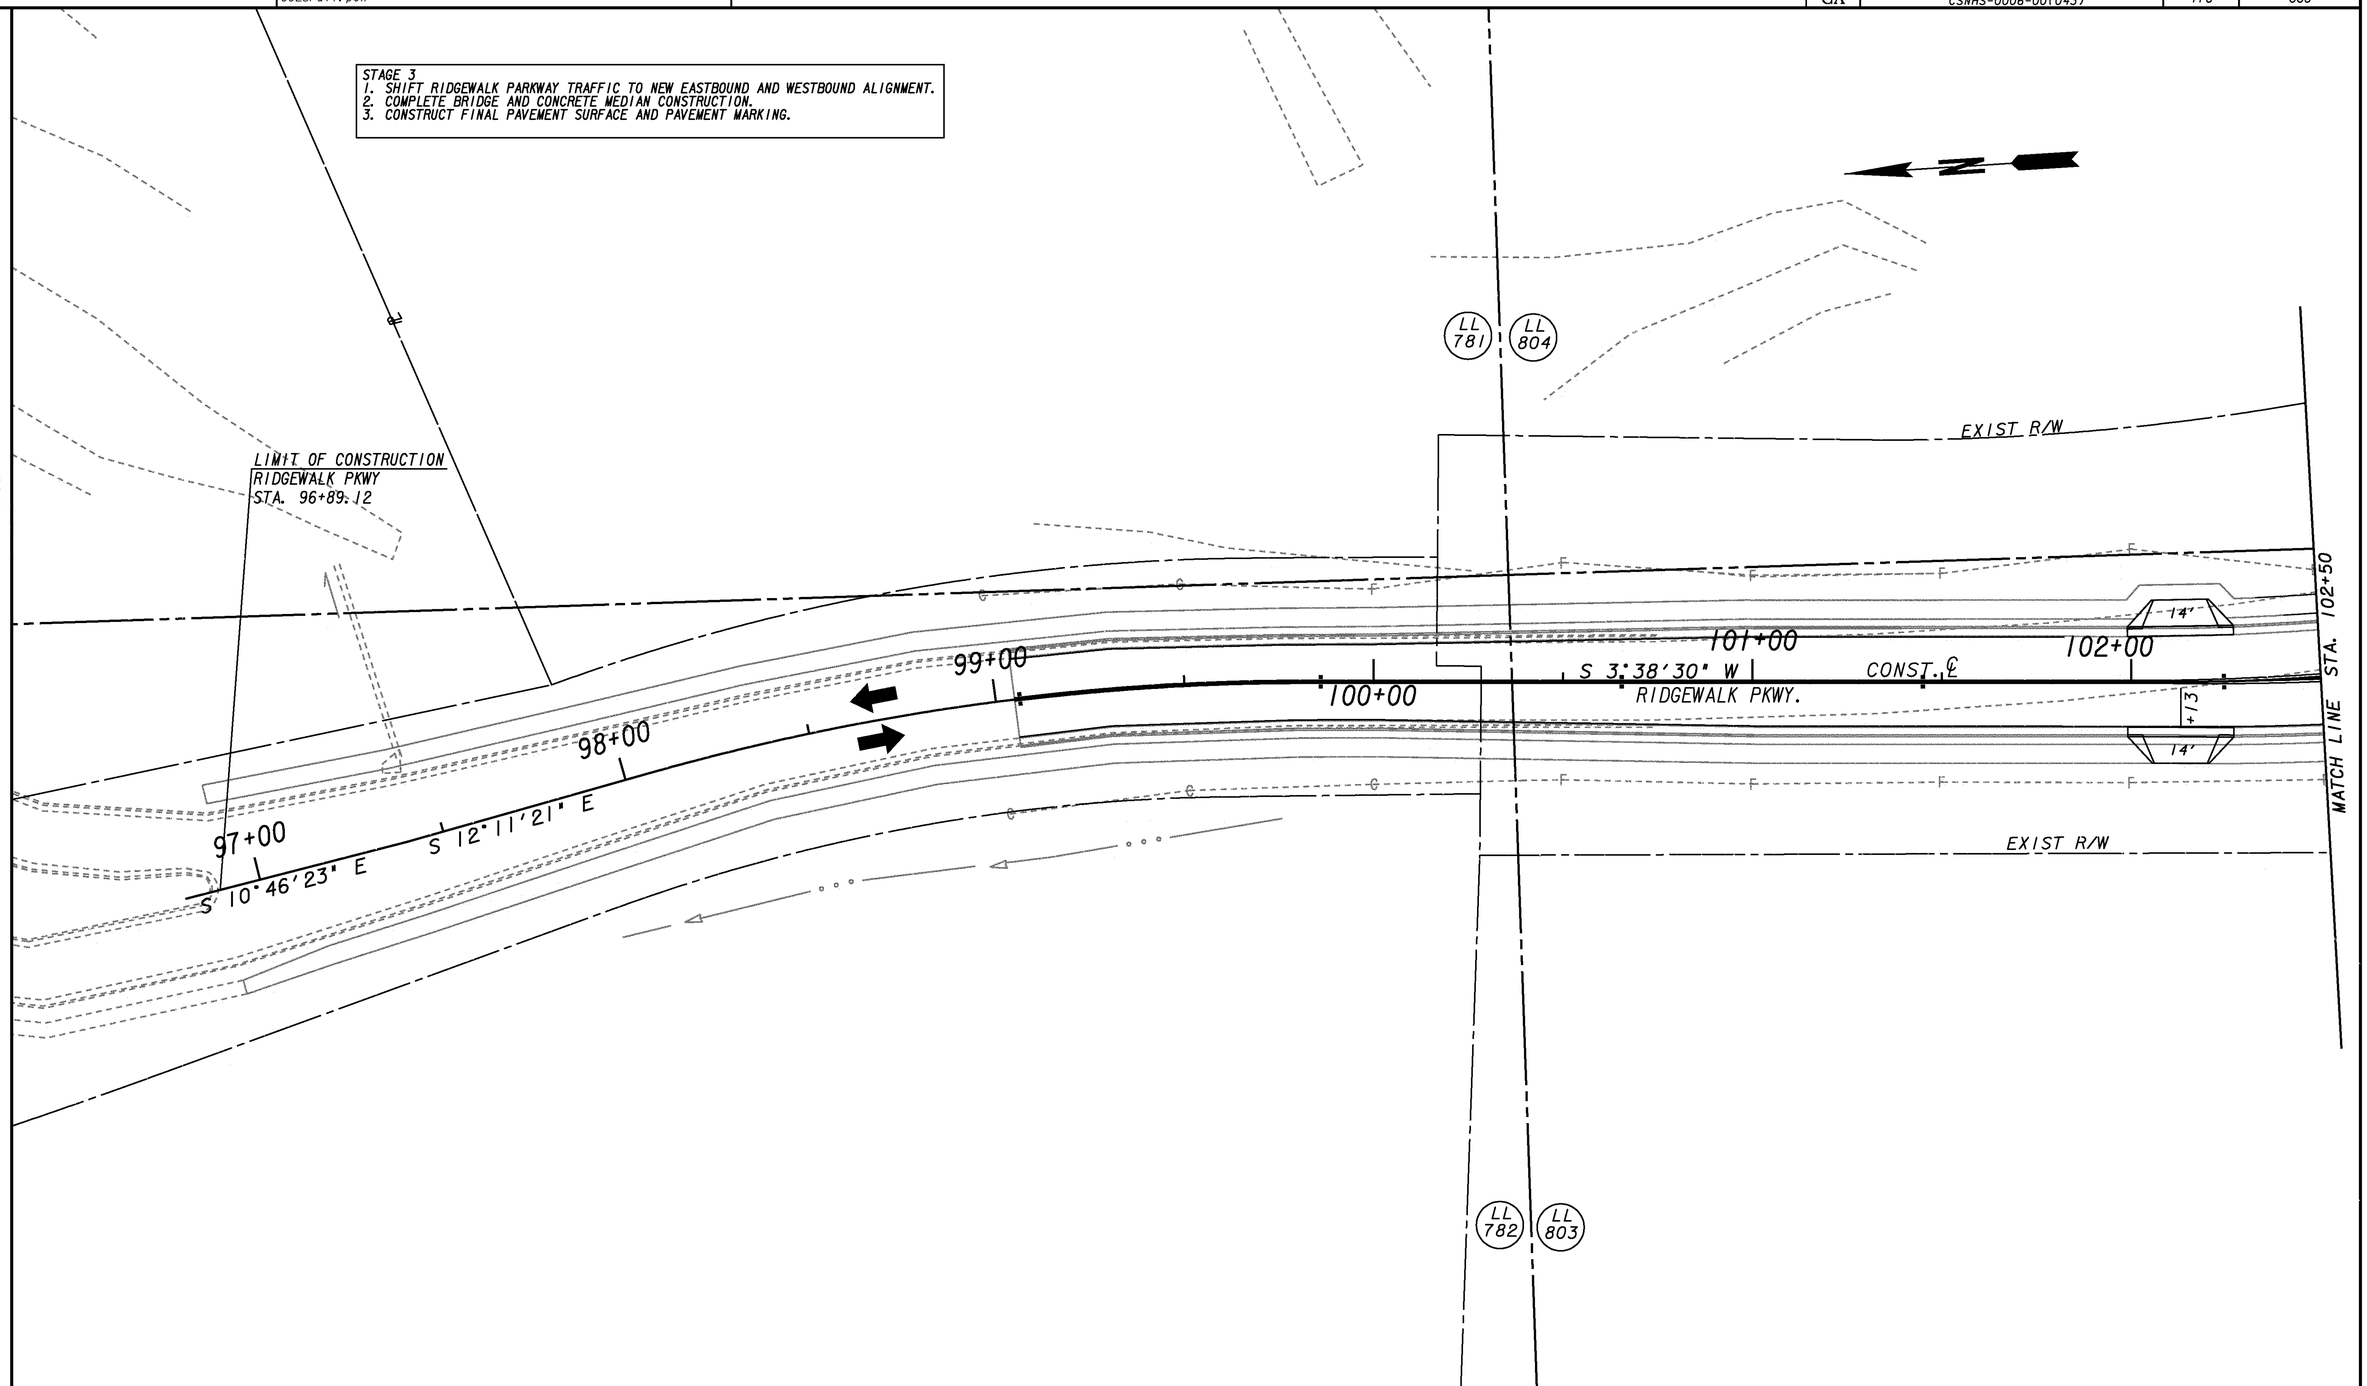

LEGEND

- PAVEMENT REMOVAL
- TEMPORARY CONSTRUCTION PAVEMENT
- PERMANENT CONSTRUCTION
- CONCRETE MEDIAN CONSTRUCTION
- MILL & OVERLAY CONSTRUCTION
- OPEN LANES OF TRAFFIC

STAGE 3

THE LPA GROUP
TRANSPORTATION CONSULTANTS
3595 ENGINEERING DRIVE
NORCROSS, GEORGIA 30092
(770) 263-9118

SCALE IN FEET
0 20 40 80

REVISION DATES

STATE OF GEORGIA
DEPARTMENT OF TRANSPORTATION
OFFICE: INNOVATIVE PROGRAM DELIVERY

CONSTRUCTION STAGING PLAN

RIDGEWALK PARKWAY
BEGIN CONST. TO STA. 102+50

DRAWING No. 19-077

1/5/2009 GPLN