AS-BUILT PLANS 12/12/12

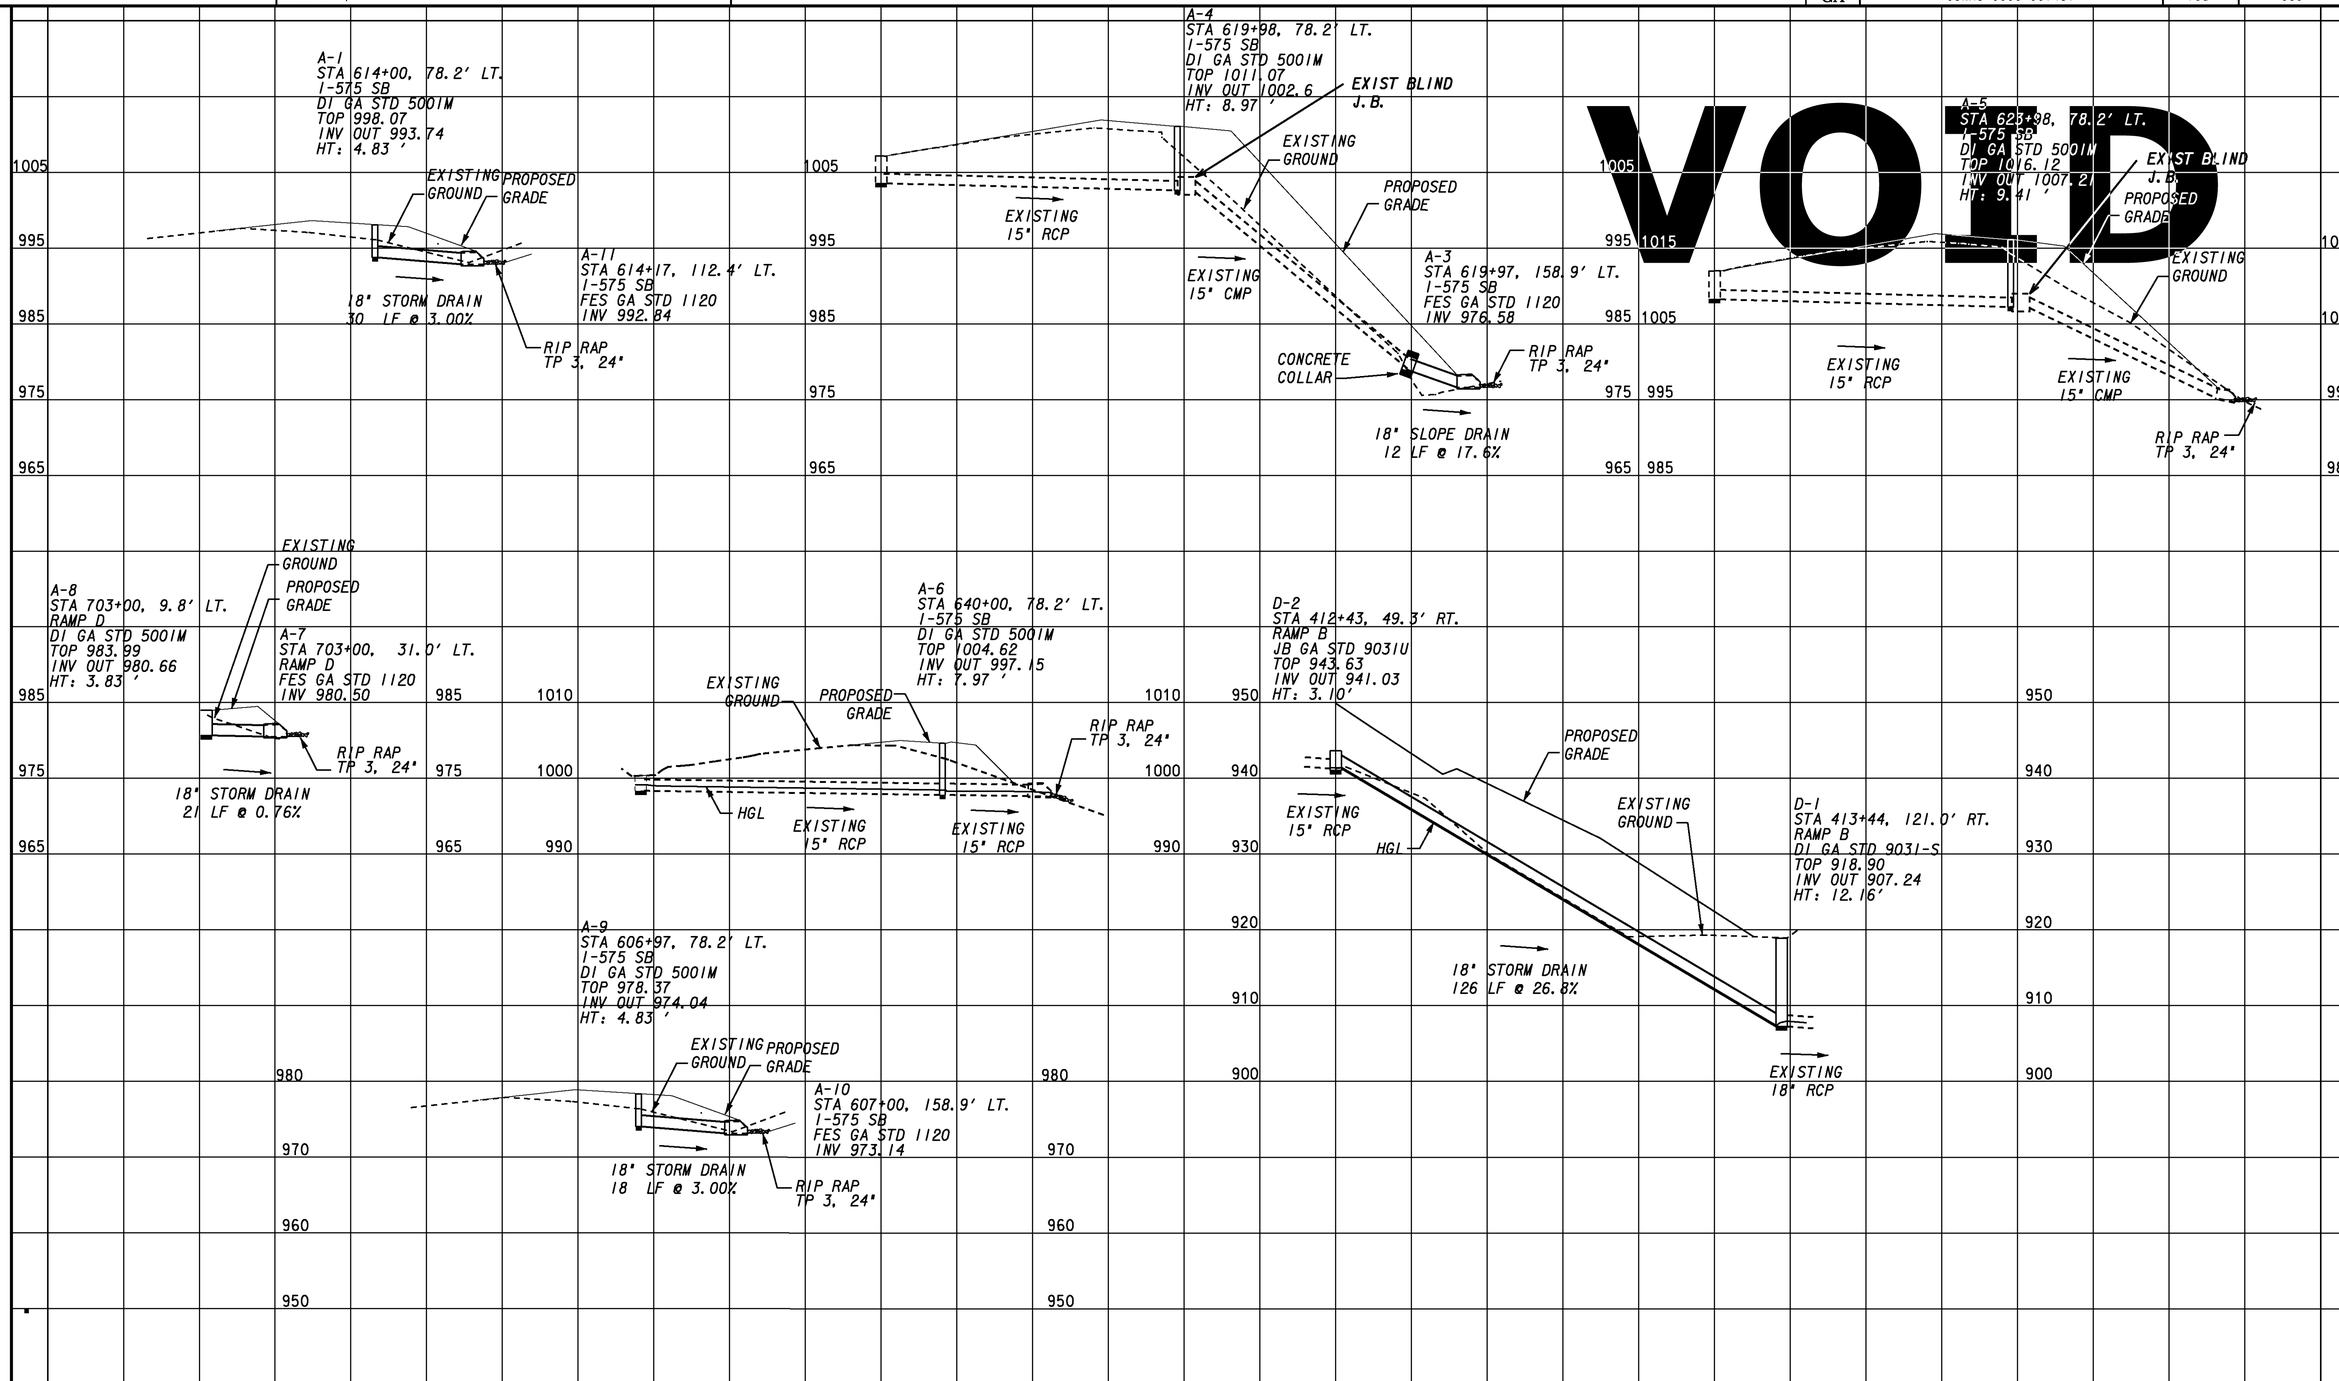


THE LPA GROUP
TRANSPORTATION CONSULTANTS
3595 ENGINEERING DRIVE
NORCROSS, GEORGIA 30092
(770) 263-9118

HORZ. 1" = 20'
VERT. 1" = 10'

REVISION DATES

STATE OF GEORGIA
DEPARTMENT OF TRANSPORTATION
OFFICE: INNOVATIVE PROGRAM DELIVERY

# DRAINAGE PROFILES
# RIDGEWALK PARKWAY
# RELOC. ROPE MILL ROAD

DRAWING No. 22-001