AS-BUILT PLANS 12/12/12

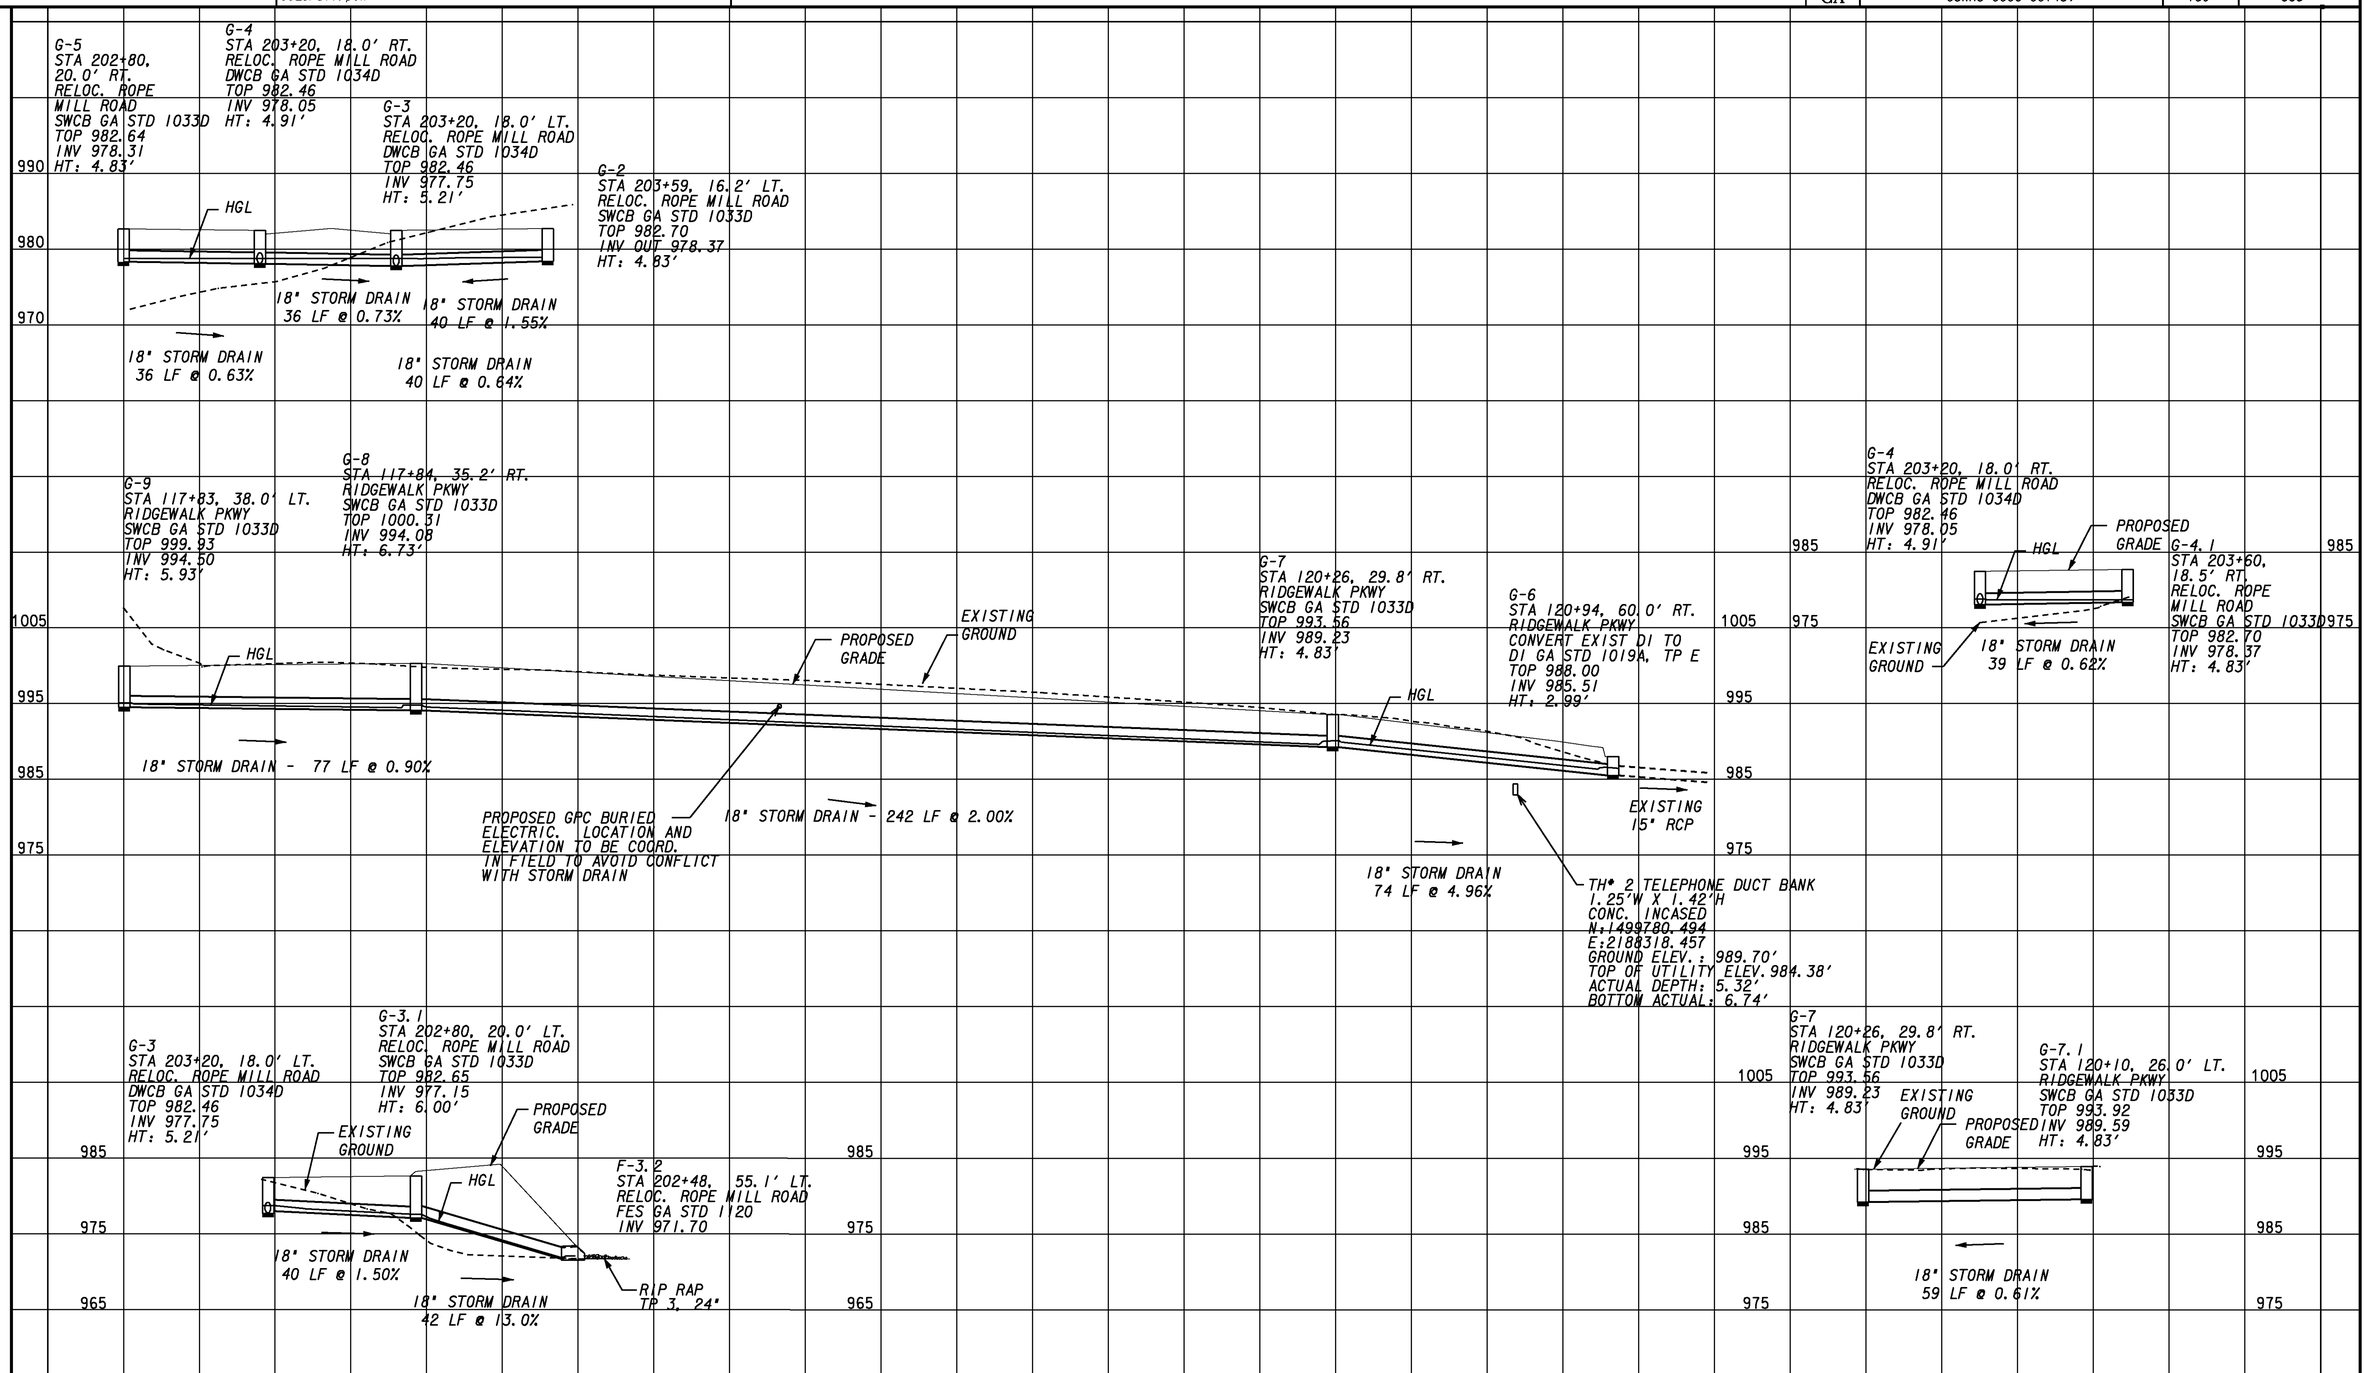

THE LPA GROUP
TRANSPORTATION CONSULTANTS
3595 ENGINEERING DRIVE
NORCROSS, GEORGIA 30092
(770) 263-9118

HORZ. 1" = 20'
VERT. 1" = 10'

REVISION DATES

STATE OF GEORGIA
DEPARTMENT OF TRANSPORTATION
OFFICE: INNOVATIVE PROGRAM DELIVERY

DRAINAGE PROFILES
RIDGEWALK PARKWAY
RELOC. ROPE MILL ROAD

DRAWING No. 22-005

3/1/2007 SUXSEW