2/9/2009 11:12:13 AM
USER:kelvint
K:\1900\1916-500 Ridgewalk Interchange over I-575 SUE\SUE\DGN\006043UT12.dgn

COUNTY	PROJECT NUMBER	SHEET NO.	TOTAL SHEETS
CHEROKEE	CSNHS-0006-00(043)	196	48

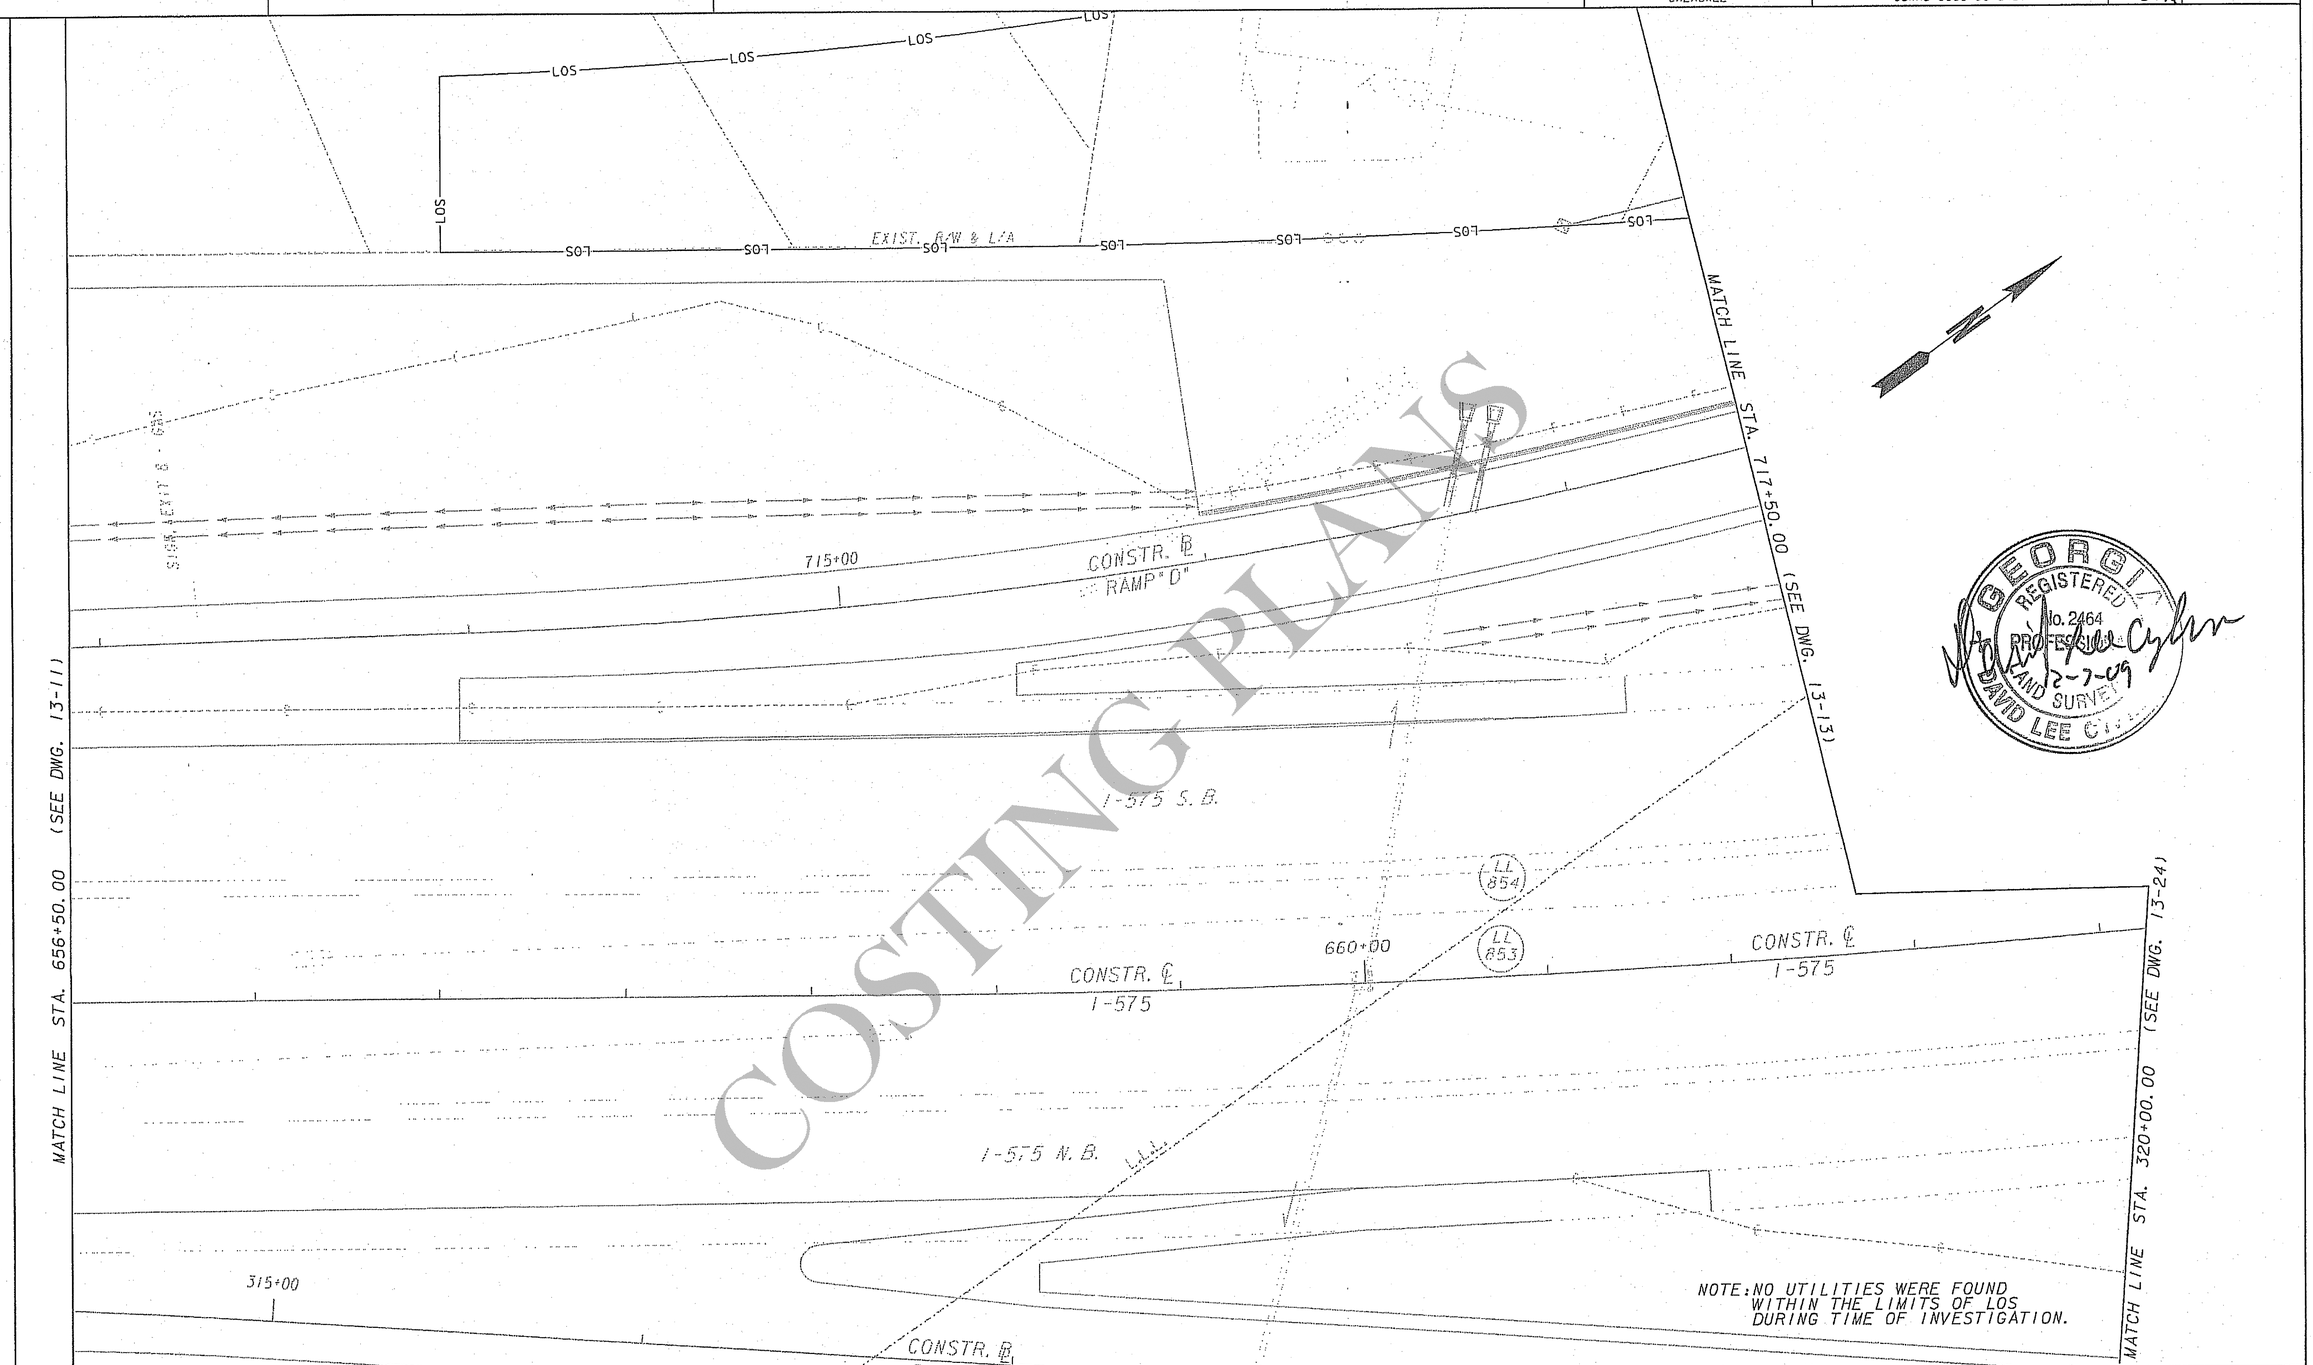

COSTING PLANS

street SMARTS
3160 Main Street
Suite 100
Duluth, GA 30096
phone: 770-813-0882
fax: 770-813-0688

SCALE IN FEET
0 20 40 80

REVISION DATES

STATE OF GEORGIA
DEPARTMENT OF TRANSPORTATION
OFFICE: UTILITIES, JUN BIRNKAMMER, EIT

UTILITY PLANS

SUBSURFACE UTILITY ENGINEERING
RIDGEWALK PARKWAY INTERCHANGE
PI# 0006043 UTILITIES

DRAWING No. 24-12

GPLN