AS-BUILT PLANS 12/12/12

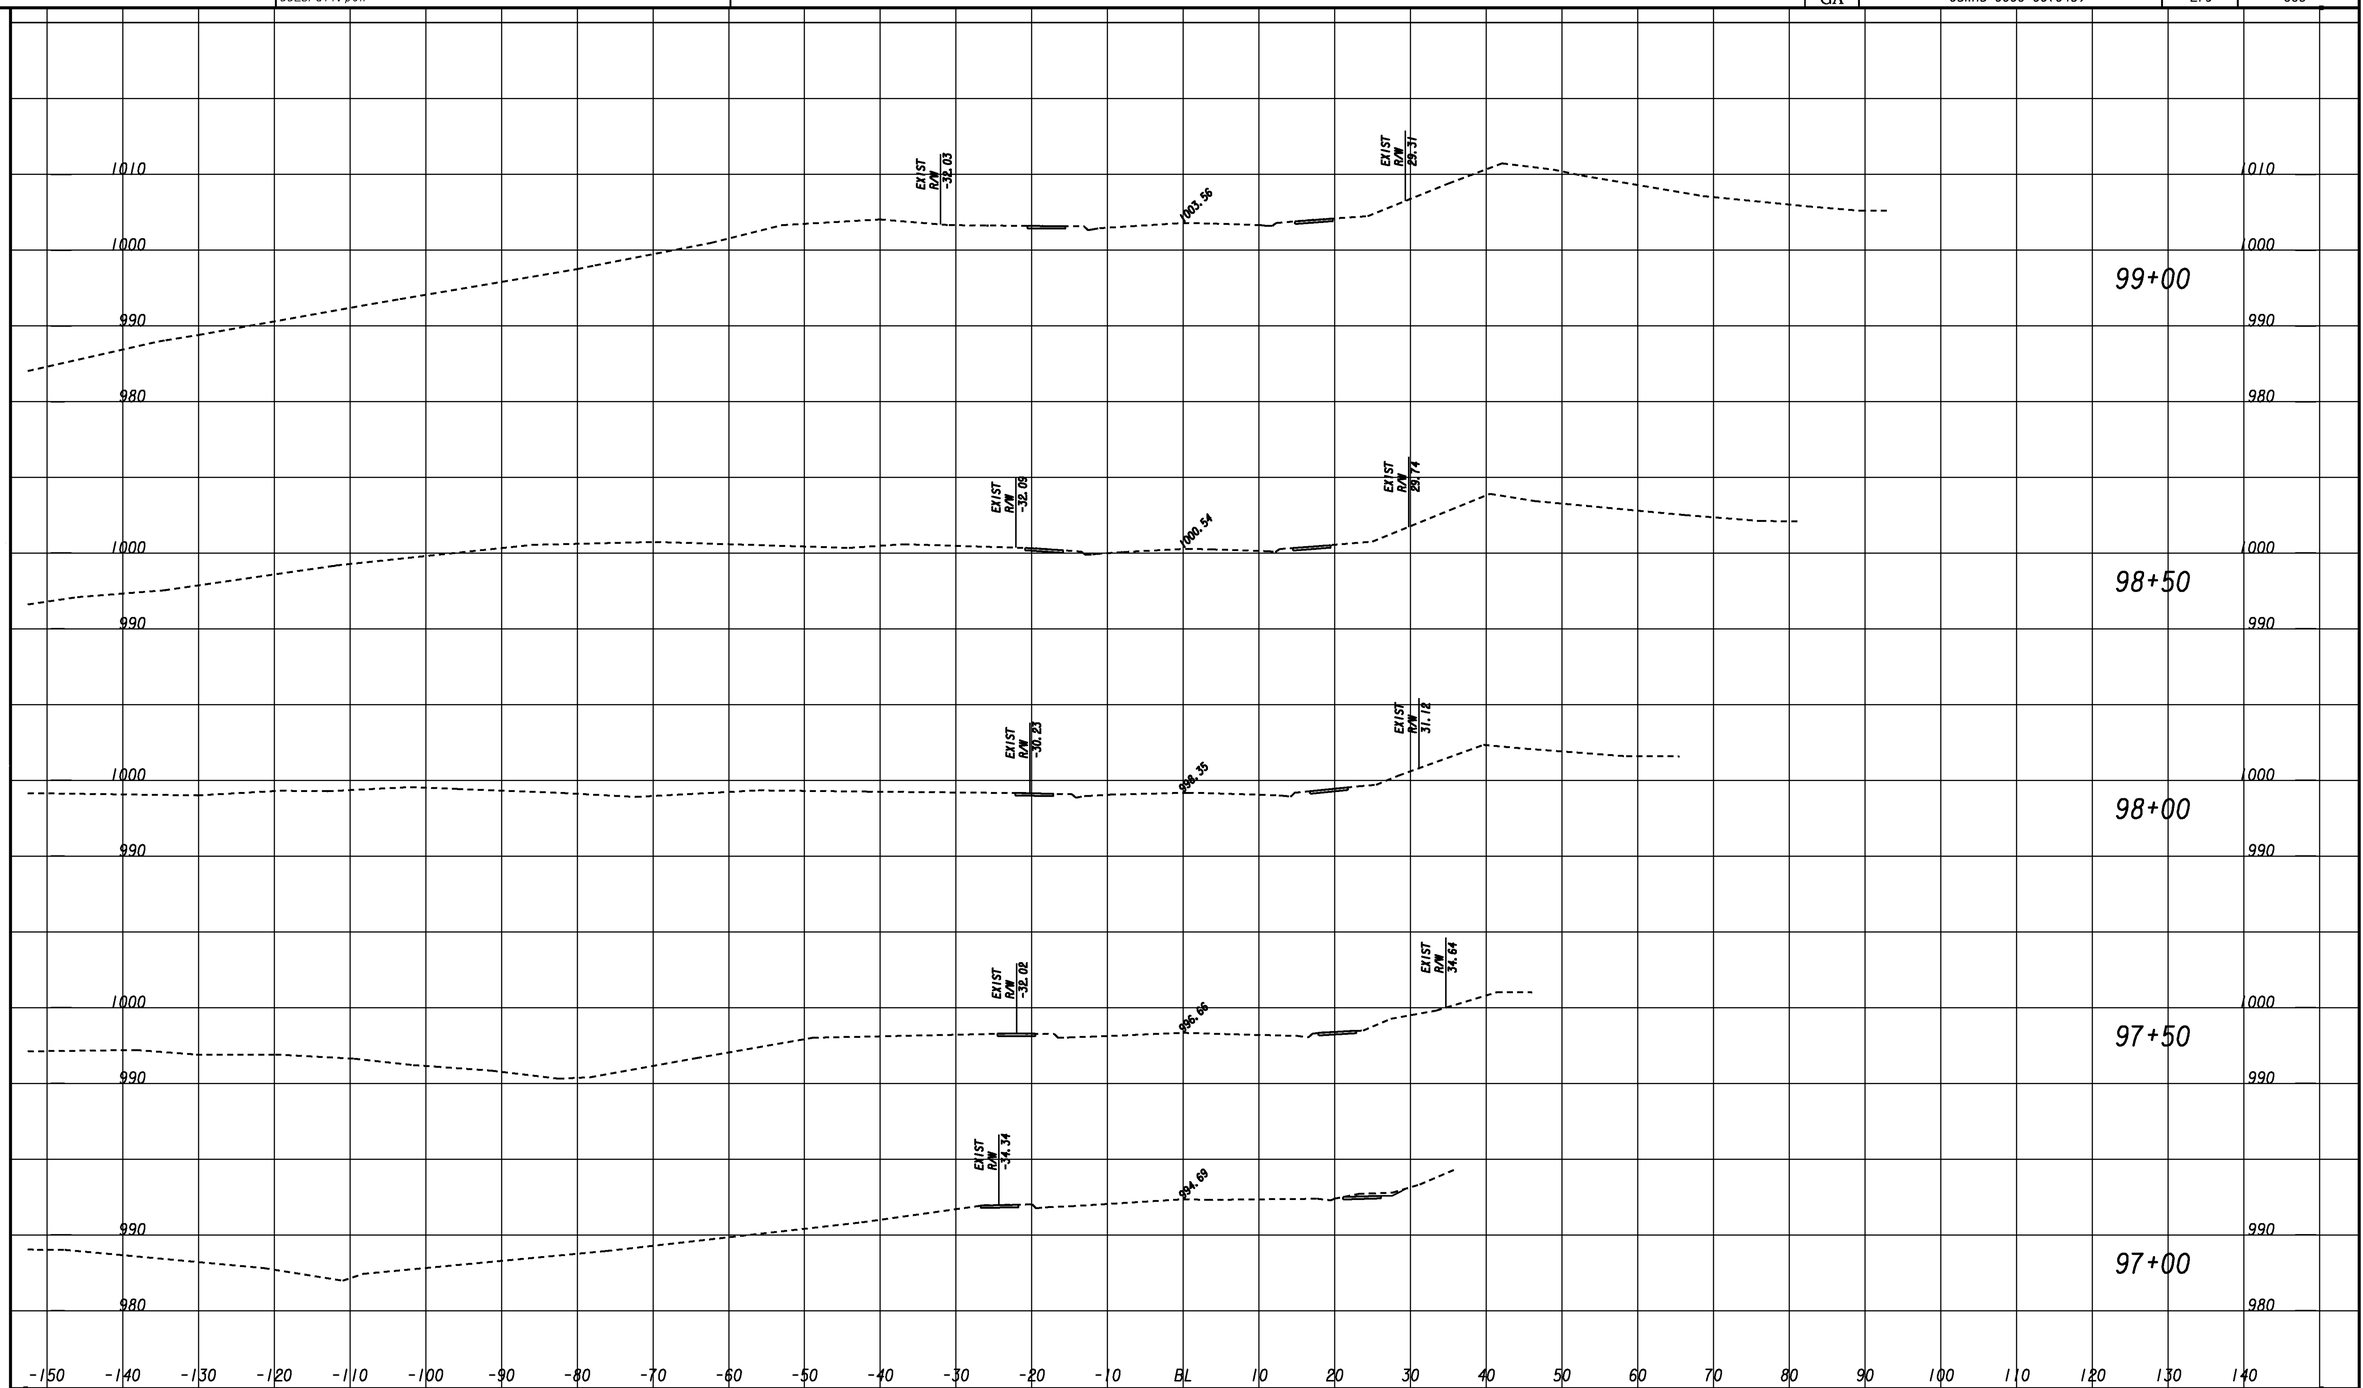

SCALE 1 inch = 10 feet Vert.
SCALE 1 inch = 10 feet Horiz.

THE LPA GROUP
TRANSPORTATION CONSULTANTS
3595 ENGINEERING DRIVE
NORCROSS, GEORGIA 30092
(770) 263-9118

REVISION DATES

STATE OF GEORGIA
DEPARTMENT OF TRANSPORTATION
OFFICE: INNOVATIVE PROGRAM DELIVERY

CROSS SECTIONS

RIDGEWALK PARKWAY

DRAWING No. 23-088