AS-BUILT PLANS 12/12/12

DETAILS & CLEARANCE DIAGRAM FOR OVERHEAD SIGNS

STRUCTURAL SUPPORT # T0088

STA. 626+62, I-575 SB

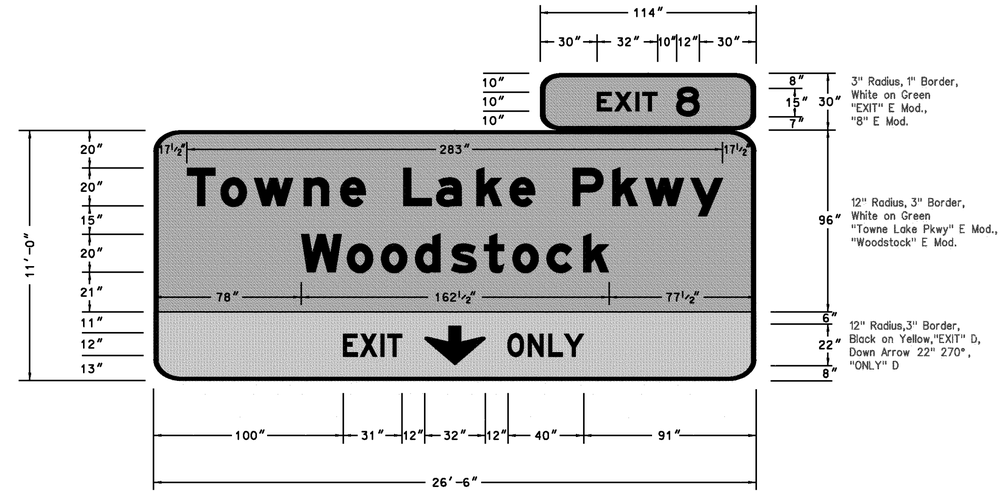

SPECIAL #103
SIGN TEMPLATE 16

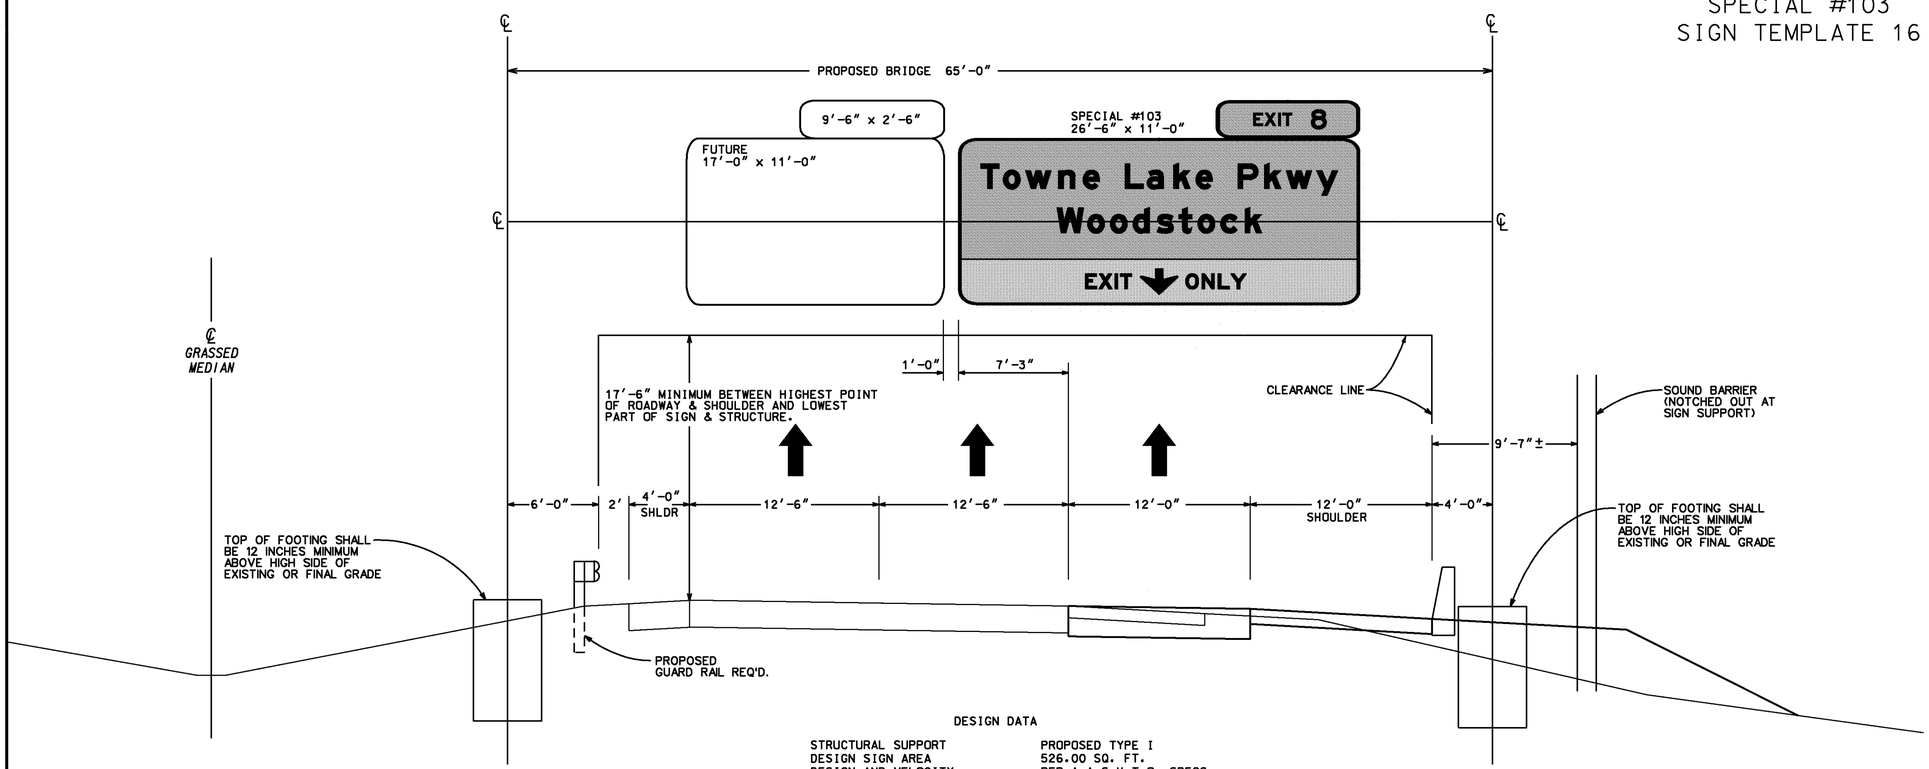

DESIGN DATA

STRUCTURAL SUPPORT	PROPOSED TYPE I
DESIGN SIGN AREA	526.00 SQ. FT.
DESIGN AND VELOCITY	PER A.A.S.H.T.O. SPECS.
HEIGHT ABOVE GENERAL GROUND ELEVATION	15' - 30'
STRUCTURE LENGTH	65'-0"

LOOKING SOUTH

NOTE:
ALL EXTRUDED ALUMINUM SIGN PANELS SHALL HAVE SQUARE CORNERS. THE RADII INDICATED ON THE SIGN DETAILS ARE FOR THE BORDER MARKING ONLY.

THE LPA GROUP
TRANSPORTATION CONSULTANTS
3595 ENGINEERING DRIVE
NORCROSS, GEORGIA 30092
(770) 263-9118

REVISION DATES

STATE OF GEORGIA
DEPARTMENT OF TRANSPORTATION
OFFICE: INNOVATIVE PROGRAM DELIVERY

SIGNING AND MARKING PLANS

OVERHEAD SIGN #103
CLEARANCE DIAGRAM

DRAWING No. 26-043