Chad.Havens

AS-BUILT PLANS 12/12/12

DETAILS OF OVERHEAD STREET NAME SIGNS

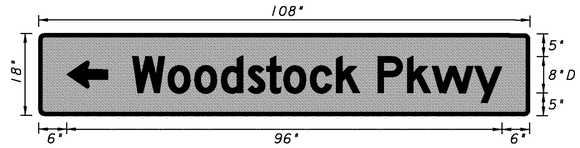

D-SPEC #1

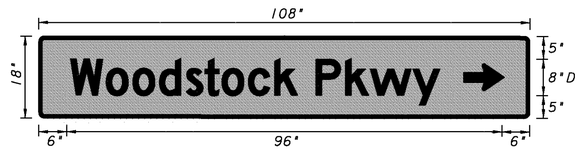

D-SPEC #2

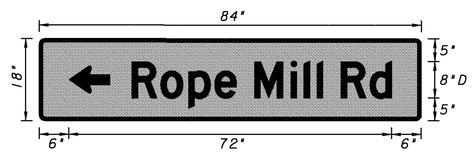

D-SPEC #3

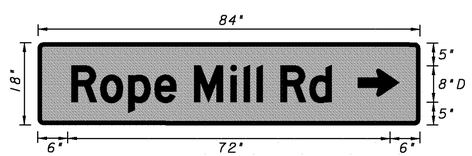

D-SPEC #4

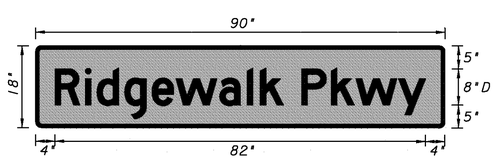

D-SPEC #5

SUMMARY OF QUANTITIES FOR OVERHEAD STREET NAME SIGNS - FOR INFORMATION ONLY

SIGNS - TYPE 2 MAT'L, REFL SHEETING TYPE 6				
LOCATION	CODE	SIZE	QUANTITY	SQUARE FEET
RIDGEWALK PARKWAY AT	D-SPEC #1	108" X 18"	1	13.5
WOODSTOCK PARKWAY/	D-SPEC #2	108" X 18"	1	13.5
ROPE MILL ROAD	D-SPEC #3	84" X 18"	1	10.5
	D-SPEC #4	84" X 18"	1	10.5
	D-SPEC #5	90" X 18"	2	22.5
TOTAL			6	70.5

GENERAL NOTES:

1. EACH SIGN SHALL CONTAIN A MINIMUM OF TWO (2) HANGERS OR BRACKETS.
2. SIGN LEGEND SHALL BE 8-IN. UPPER CASE & 6-IN. LOWER CASE SERIES "D" LETTERS, ALL ARROWS SHALL BE 6-IN. TALL & 9-IN. LONG
3. EACH SIGN SHALL CONTAIN 1/2-IN BORDERS AND 1 1/2-IN RADII.
4. EACH SIGN SHALL BE MADE OF ONE CONTINUOUS PIECE OF ALUMINUM.
5. SIGNS SHALL HAVE STANDARD REFLECTORIZED INTERSTATE GREEN BACKGROUND WITH WHITE REFLECTORIZED LEGENDS, BORDERS AND ARROWS.

MOUNTING DIMENSIONS			
H	A	B	C
12'	9'	1½'	36'
18'	15'	1½'	24'
24'	18'	1½'	18'
30'	24'	3'	12'

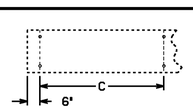

FOR MOUNTING TO MAST ARMS STRUCTURES.
(NOT TO SCALE)
NOTE: USE ASTRO MINI SIGN BRAC AND CLAMP OR EQUIVALENT

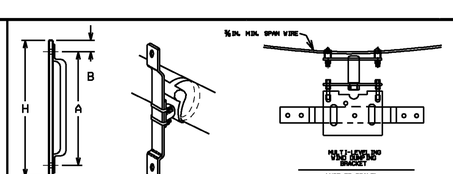

(NOT TO SCALE)

THE LPA GROUP
TRANSPORTATION CONSULTANTS
A UNIT OF MICHAEL BAKER CORPORATION
3595 ENGINEERING DRIVE
NORCROSS, GEORGIA 30092
(770) 263-9118

REVISION DATES		

STATE OF GEORGIA
DEPARTMENT OF TRANSPORTATION
OFFICE: INNOVATIVE PROGRAM DELIVERY

SIGNAL PLANS

DETAILS OF OVERHEAD STREET NAME SIGNS

DRAWING No. 27-002

1/5/2009 GPLN