STATE	PROJECT NUMBER	SHEET NO.	TOTAL SHEETS
GA.	CSNHS-0006-00(043)	409	668

AS-BUILT PLANS 12-12-2012

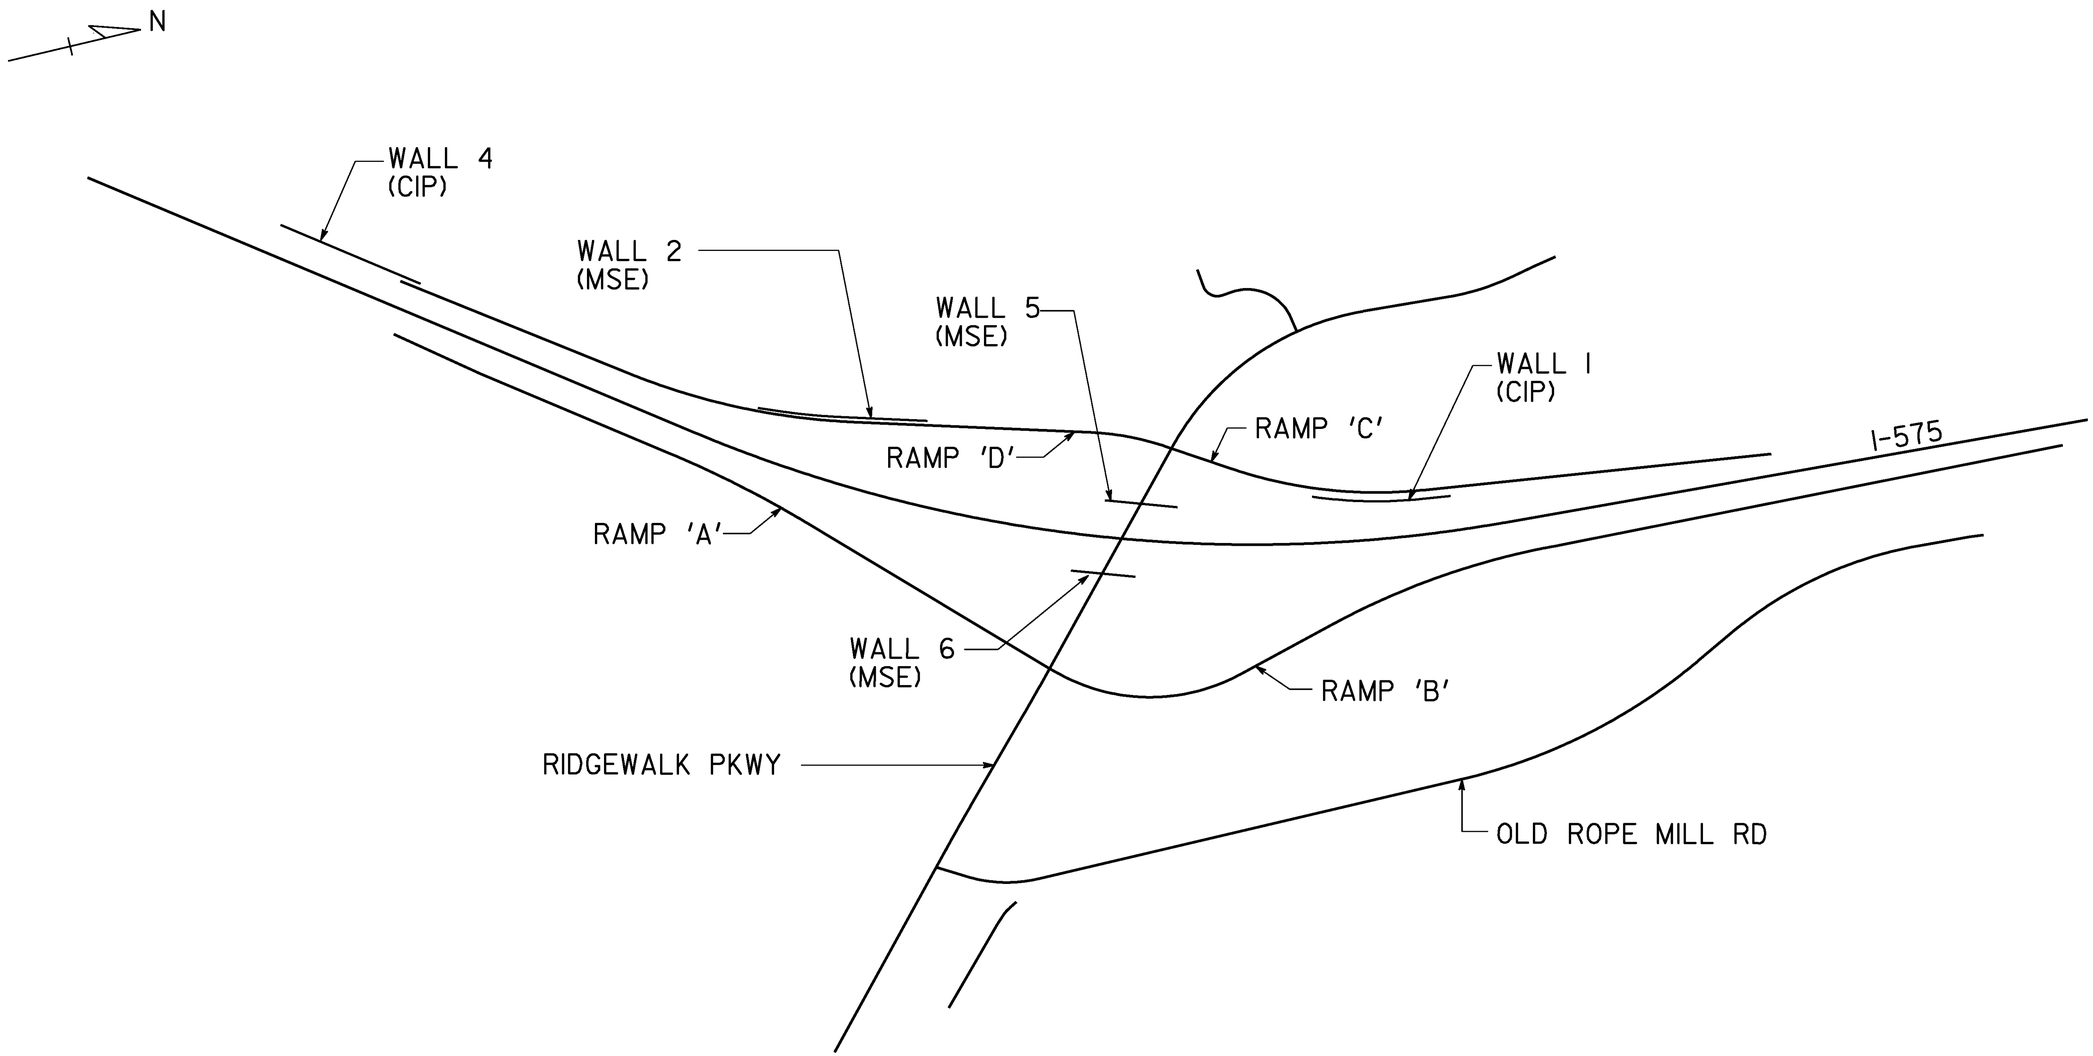

NOTE: WALL 3 REMOVED, NOT TO BE CONSTRUCTED.

THE LPA GROUP

THE LPA GROUP INCORPORATED
TRANSPORTATION CONSULTANTS
3595 ENGINEERING DRIVE
NORCROSS, GEORGIA 30092
(770) 263-9118

GEORGIA
DEPARTMENT OF TRANSPORTATION
PRECONSTRUCTION DIVISION-OFFICE OF BRIDGE DESIGN

WALL LOCATIONS

RIDGEWALK PARKWAY OVER I-575

CHEROKEE COUNTY CSHNS-0006-00(043)

NO SCALE DECEMBER 2010

DRAWING NO. 31-01

WALL SHEET 1 OF 1

REVISIONS	BY	DATE

DESIGNED BSB CHECKED ANZ REVIEWED WEI/WMD
DRAWN CJH DESIGN GROUP AWB APPROVED PVL

12/11/2012 2:42:20 PM R:\07400004\006043\DGN\As Builts\Structures\Walls\wallplan.dgn