STATE	PROJECT NUMBER	SHEET NO.	TOTAL SHEETS
GA.	CSNHS-0006-00(043)	410	668

AS-BUILT PLANS 12-12-2012

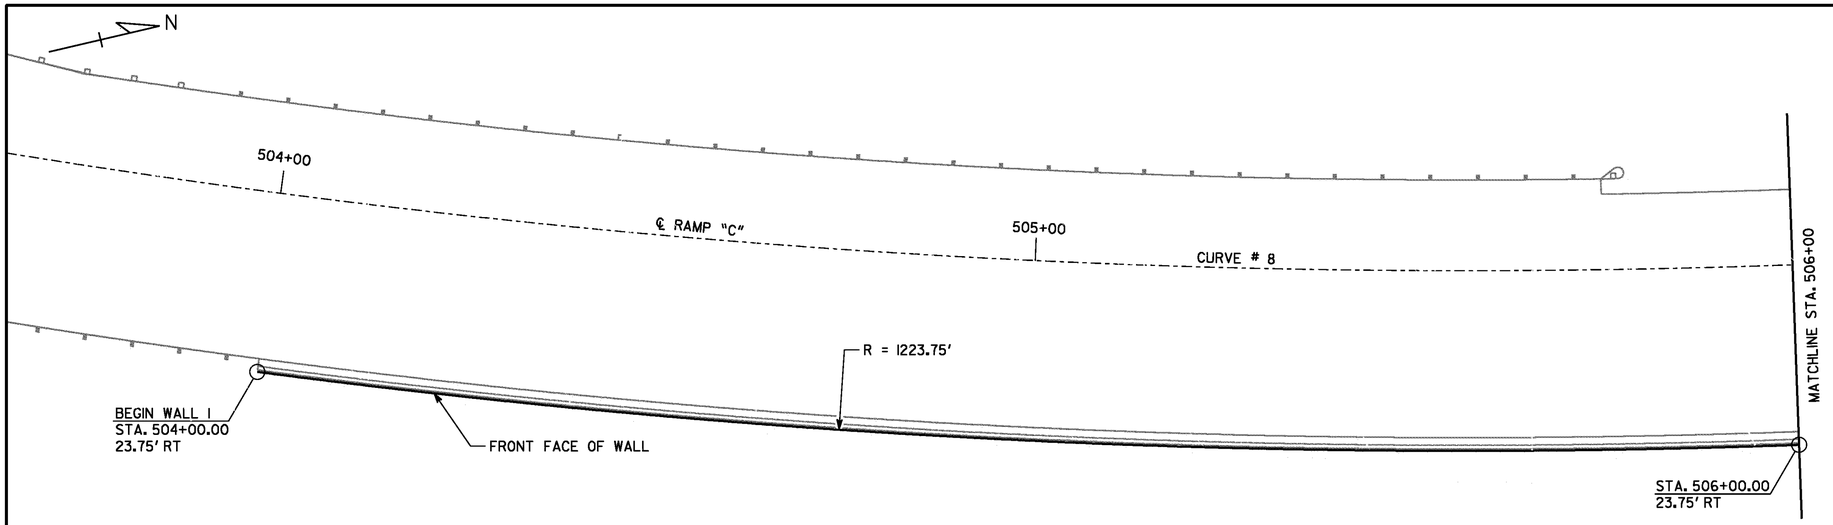

PLAN

SCALE: 1" = 10'-0"

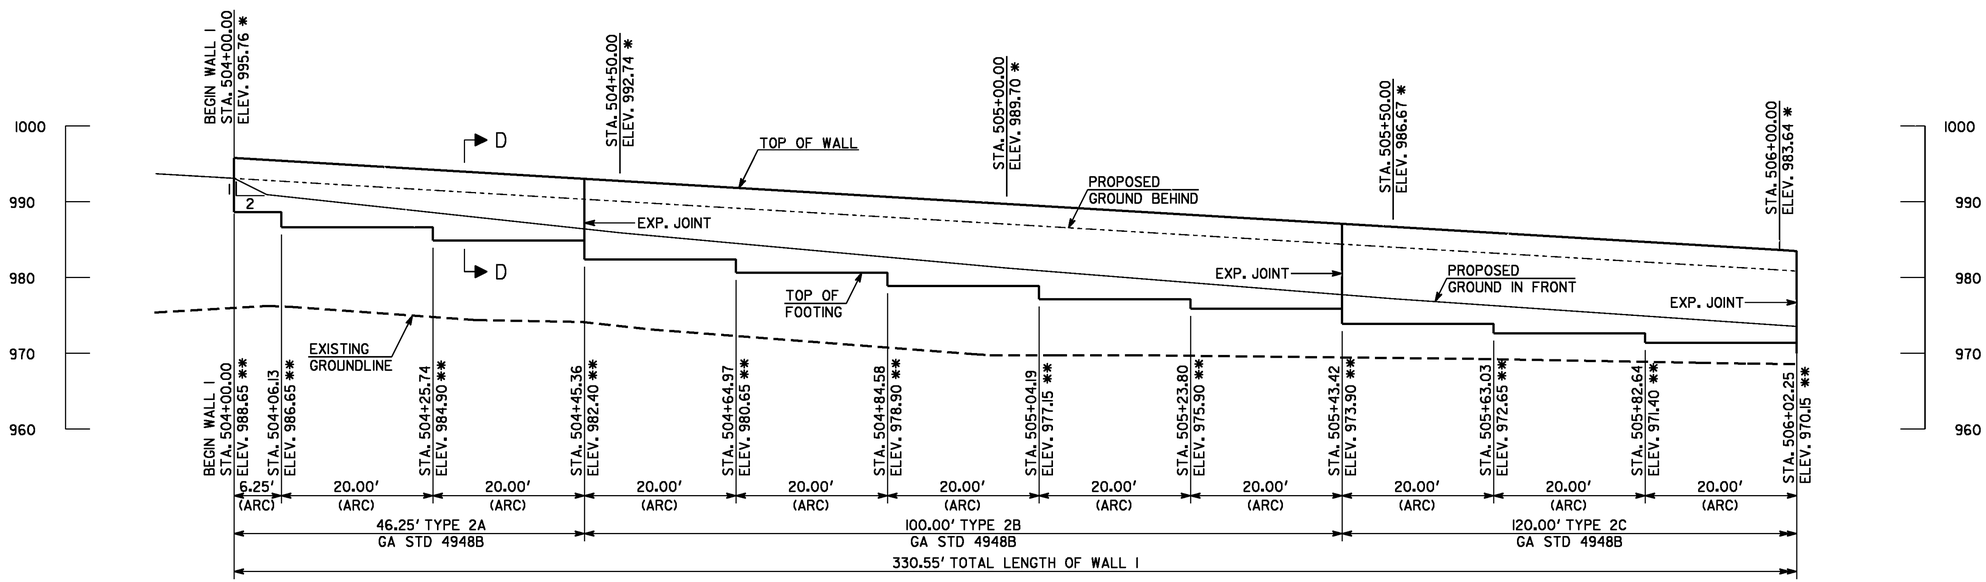

ELEVATION

SCALE: 1" = 10'-0"
LOOKING AT
FRONT FACE OF WALL

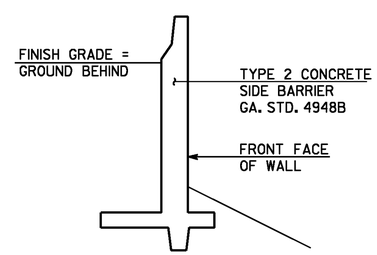

SECTION D-D

SCALE: NONE

GEORGIA STANDARDS

BAR BENDING DETAILS ---------- GA. STD. 3901 (8-69)
CONCRETE SIDE BARRIER, TYPE 2 ---------- GA. STD. 4948B (1-07)

SUMMARY OF QUANTITIES

PAY ITEM NUMBER	QUANTITY	UNIT	PAY ITEM
621-4021	46.25	LF	CONCRETE SIDE BARRIER, TYPE 2A
621-4022	164.30	LF	CONCRETE SIDE BARRIER, TYPE 2B
621-4023	120.00	LF	CONCRETE SIDE BARRIER, TYPE 2C

THIS IS A DESIGN BUILD PROJECT AND QUANTITIES ARE PROVIDED FOR INFORMATION ONLY.

NOTES:
1.* ELEVATION OF TOP OF WALL AT FRONT FACE TYP.
2.** ELEVATION AT TOP OF FOOTING, TYP.
(LOWER ELEVATION GIVEN AT STEPS.)

HORIZONTAL CURVE DATA

CURVE # 8
P.I. STA. 504+26.36
Δ = -24° 40' 33"
D = 4° 46' 29"
R = 1200.00'
T = 262.47'
L = 516.81'

THIS PLAN SET IS SEALED ONLY FOR THE AS-BUILT CONDITIONS DOCUMENTED THROUGH THE R.F.I. AND RED LINE PROCESS BY THE CONTRACTOR. THIS DOCUMENT WAS ORIGINALLY SEALED BY ALBERT W. BOWMAN, LICENSE NO. 24732 ON NOVEMBER 30,2010.

THIS MEDIA SHALL NOT BE CONSIDERED A CERTIFIED DOCUMENT AS TO THE ORIGINAL DOCUMENT BUT CERTIFIED ONLY AS TO THE REVISIONS.

GEORGIA REGISTERED NO. 24732 PROFESSIONAL ENGINEER ALBERT W. BOWMAN

DRAWING NO. 31-02
WALL SHEET 1 OF 2

WALL NO. 1

THE LPA GROUP

THE LPA GROUP INCORPORATED
TRANSPORTATION CONSULTANTS
3595 ENGINEERING DRIVE
NORCROSS, GEORGIA 30092
(770) 263-9118

GEORGIA
DEPARTMENT OF TRANSPORTATION
PRECONSTRUCTION DIVISION-OFFICE OF BRIDGE DESIGN

WALL PLAN AND ELEVATION
TYPE 2 SIDE BARRIER
RIDGEWALK PARKWAY OVER I-575

CHEROKEE COUNTY CSHNS-0006-00(043)

SCALE: AS SHOWN DECEMBER 2010

DESIGNED BSB CHECKED ANZ REVIEWED WEI/WMD
DRAWN CJH DESIGN GROUP AWB APPROVED PVL

REVISIONS DATE BY

12/13/2012 11:58:27 AM R:\07400004\006043\DGN\As Builts\Structures\Walls\W0101-PE.dgn