STATE	PROJECT NUMBER	SHEET NO.	TOTAL SHEETS
GA.	CSNHS-0006-00(043)	413	668

AS-BUILT PLANS 12-12-2012

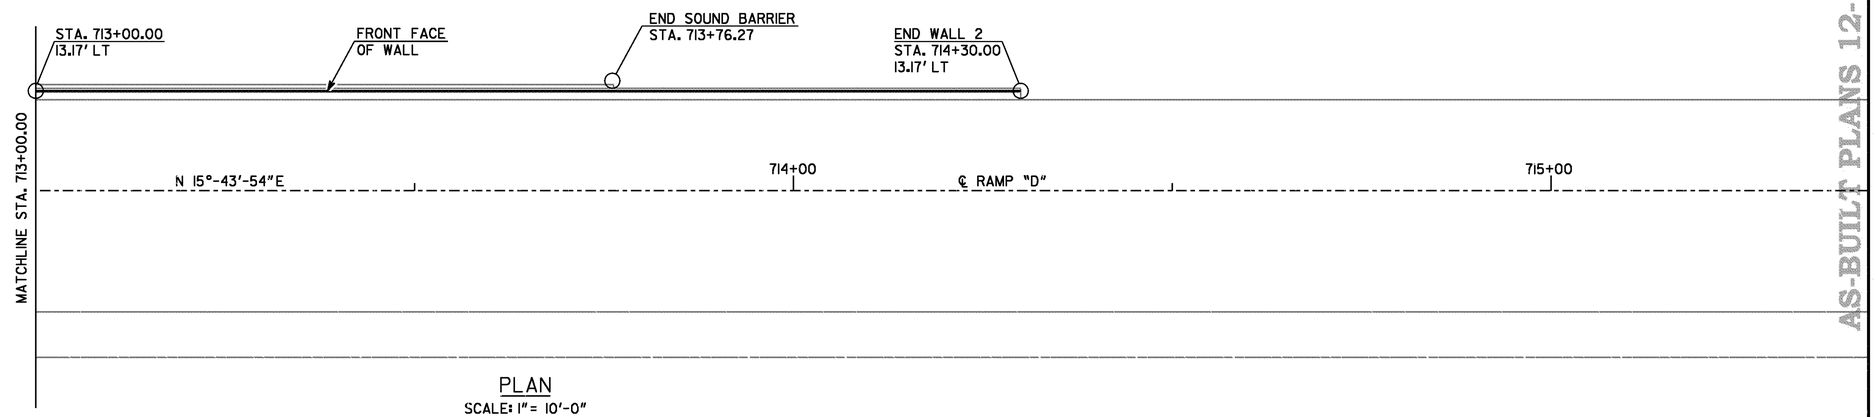

PLAN
SCALE: 1" = 10'-0"

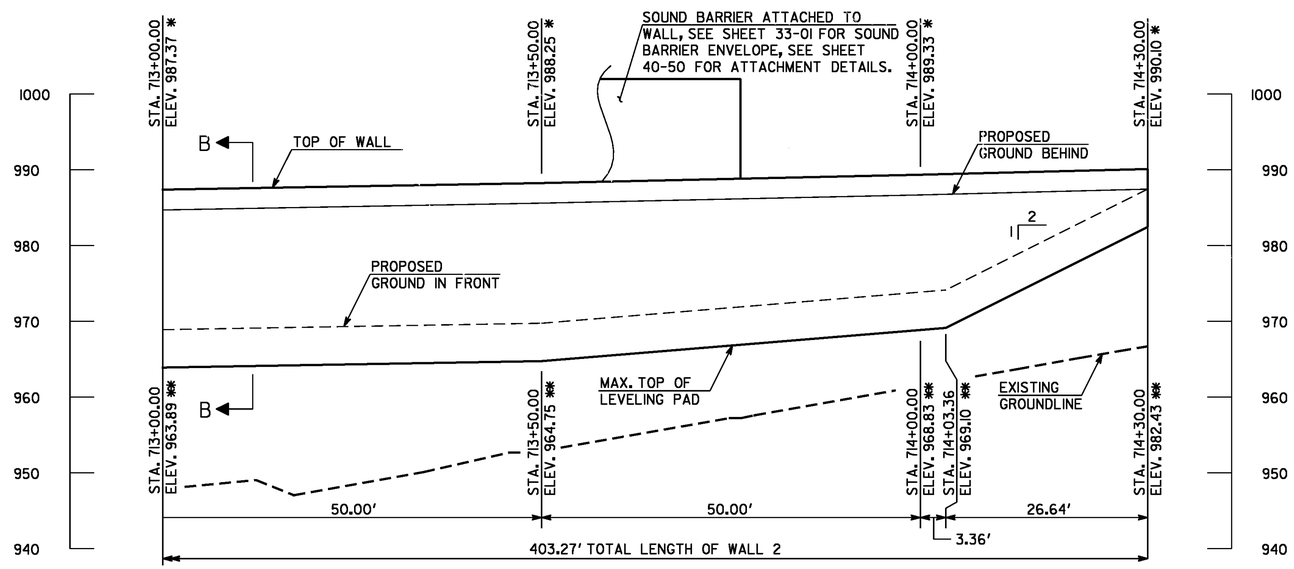

ELEVATION
SCALE: 1" = 10'-0"
LOOKING AT
BACK FACE OF WALL

NOTES:
1.* ELEVATION OF TOP OF WALL AT FRONT FACE TYP.
2.** MAXIMUM ELEVATION AT TOP OF LEVELING PAD, TYP.
3. FOR WALL SECTIONS SEE 31-10

WALL NO. 2

THE LPA GROUP

THE LPA GROUP INCORPORATED
TRANSPORTATION CONSULTANTS
3595 ENGINEERING DRIVE
NORCROSS, GEORGIA 30092
(770) 263-9118

GEORGIA
DEPARTMENT OF TRANSPORTATION
PRECONSTRUCTION DIVISION-OFFICE OF BRIDGE DESIGN

WALL PLAN AND ELEVATION - MSE
RIDGEWALK PARKWAY OVER I-575
CHEROKEE COUNTY CSHNS-0006-00(043)

REVISIONS	BY	DATE

DRAWING NO. 31-05
WALL SHEET 2 OF 2

SCALE: AS SHOWN DECEMBER 2010

DESIGNED BSB CHECKED ANZ REVIEWED WEI/WMD
DRAWN CJH DESIGN GROUP AWB APPROVED PVL

12/11/2012 2:42:24 PM R:\07400004\006043\DGN\As Builts\Structures\Walls\W02 02-PE.dgn