STATE	PROJECT NUMBER	SHEET NO.	TOTAL SHEETS
GA.	CSNHS-0006-00(043)	415	668

AS-BUILT PLANS 12-12-2012

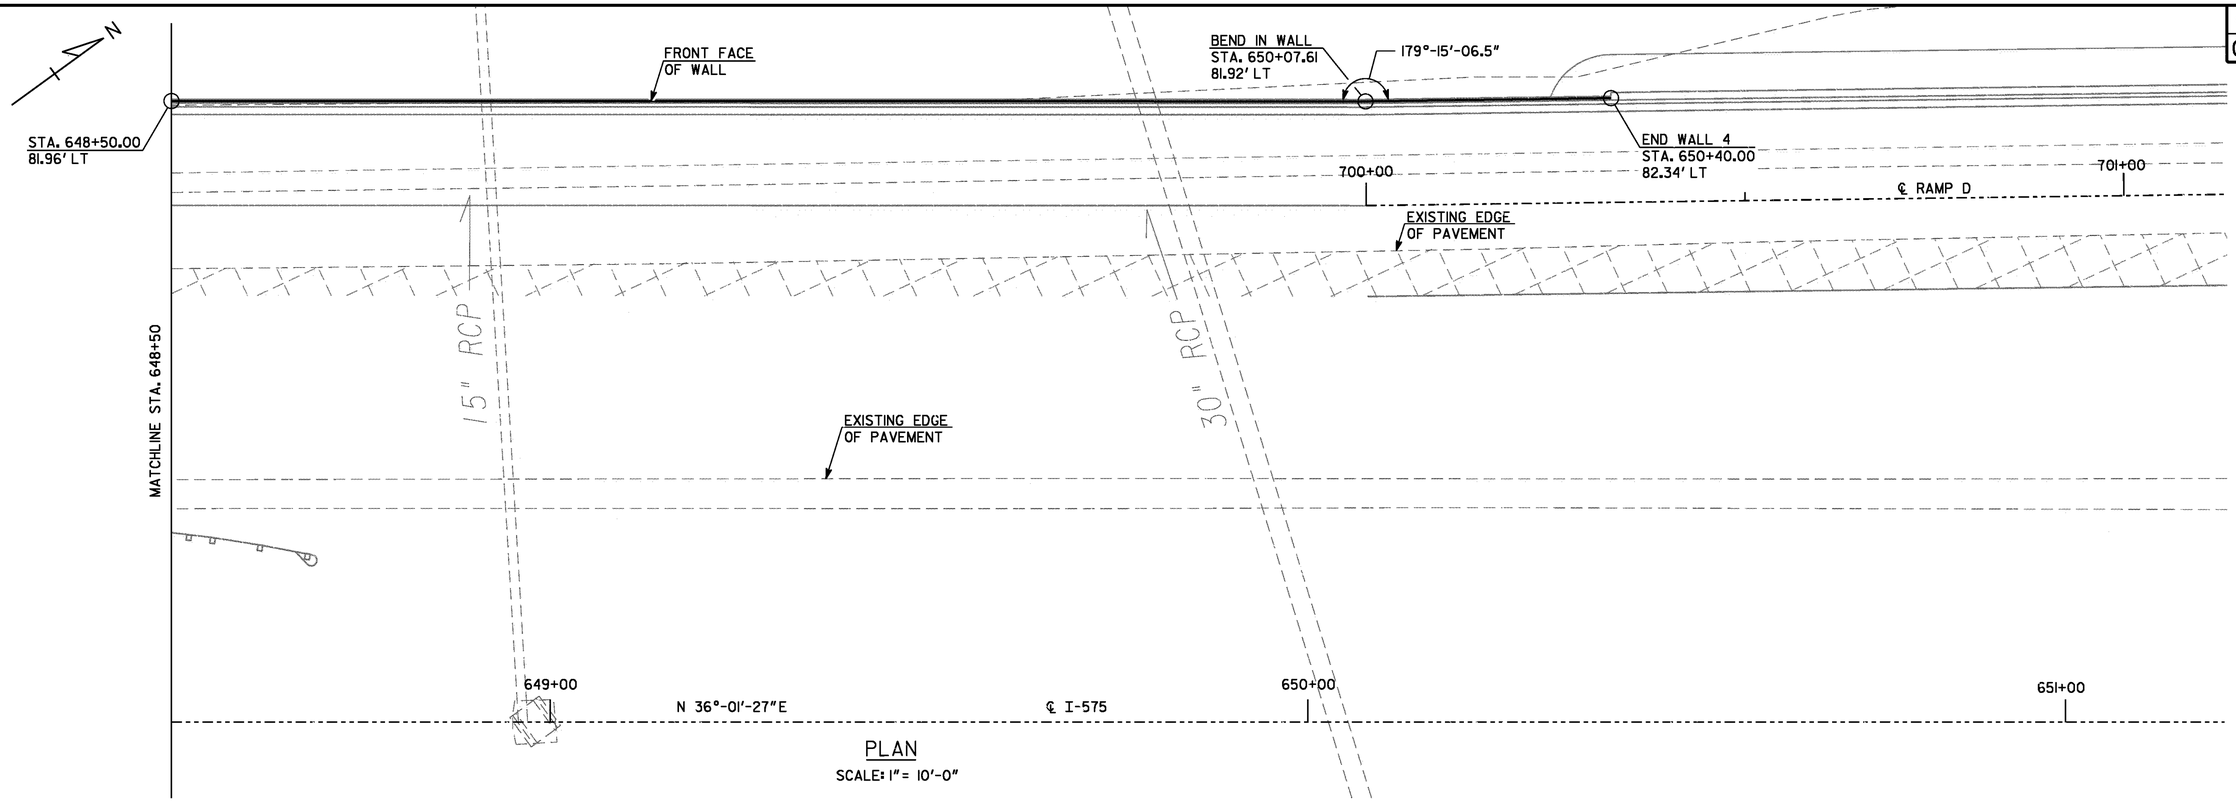

PLAN

SCALE: 1" = 10'-0"

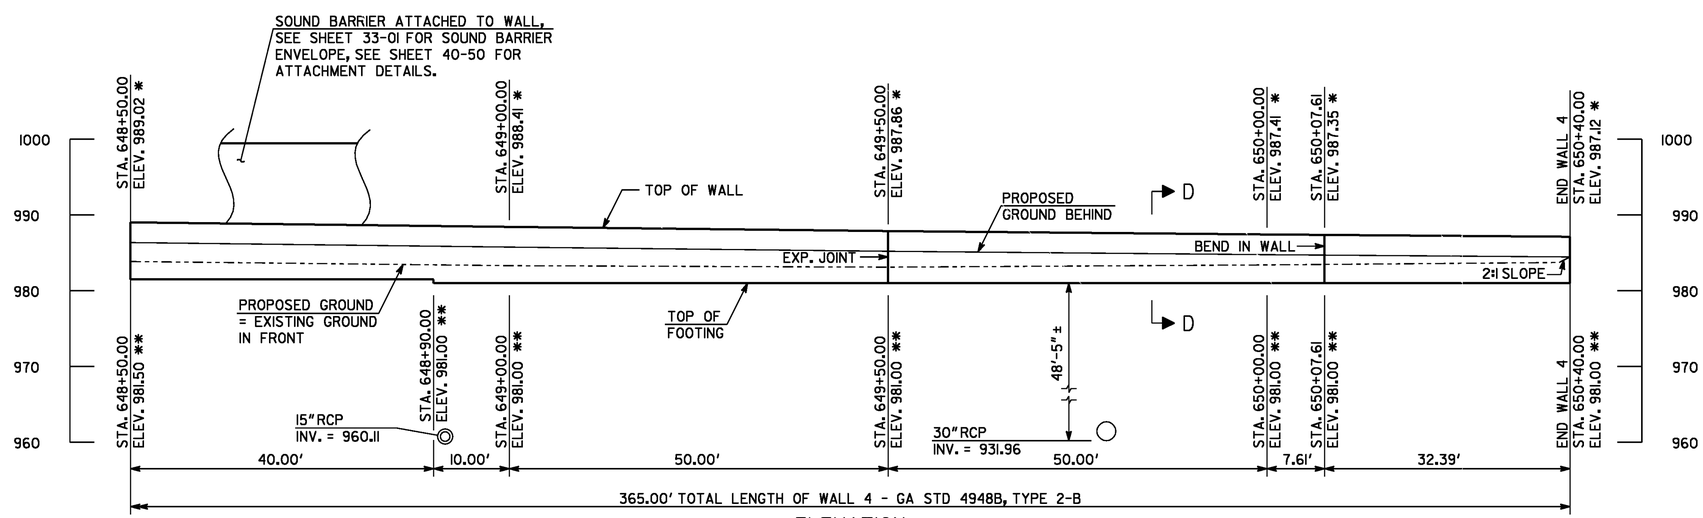

ELEVATION

SCALE: 1" = 10'-0"
LOOKING AT
BACK FACE OF WALL

NOTES:
1. * ELEVATION OF TOP OF WALL AT FRONT FACE TYP.
2. ** ELEVATION AT TOP OF FOOTING, TYP.
3. WALL 4 SHALL BE CONSTRUCTED ACCORDING TO GA DOT STD 4948B, BUT ENTIRE WALL SHALL BE TYPE 2-B AND LIMITED TO A MAX HEIGHT OF 7'-0" TO ALLOW FOR ATTACHMENT OF SOUND BARRIER.
4. FOR WALL SECTION SEE 31-07

WALL NO. 4

THE LPA GROUP

THE LPA GROUP INCORPORATED
TRANSPORTATION CONSULTANTS
3595 ENGINEERING DRIVE
NORCROSS, GEORGIA 30092
(770) 263-9118

GEORGIA
DEPARTMENT OF TRANSPORTATION
PRECONSTRUCTION DIVISION-OFFICE OF BRIDGE DESIGN

WALL PLAN AND ELEVATION
TYPE 2 SIDE BARRIER
RIDGEWALK PARKWAY OVER I-575

CHEROKEE COUNTY CSHNS-0006-00(043)

SCALE: AS SHOWN DECEMBER 2010

DRAWING NO. 31-07
WALL SHEET 2 OF 2

REVISIONS | DATE | BY

DESIGNED BSB | CHECKED ANZ | REVIEWED WEI/WMD
DRAWN CJH | DESIGN GROUP AWB | APPROVED PVL

12/11/2012 2:42:27 PM R:\07400004\006043\DGN\As Builts\Structures\Walls\W04 02-PE.dgn