AS-BUILT PLANS 12/12/12

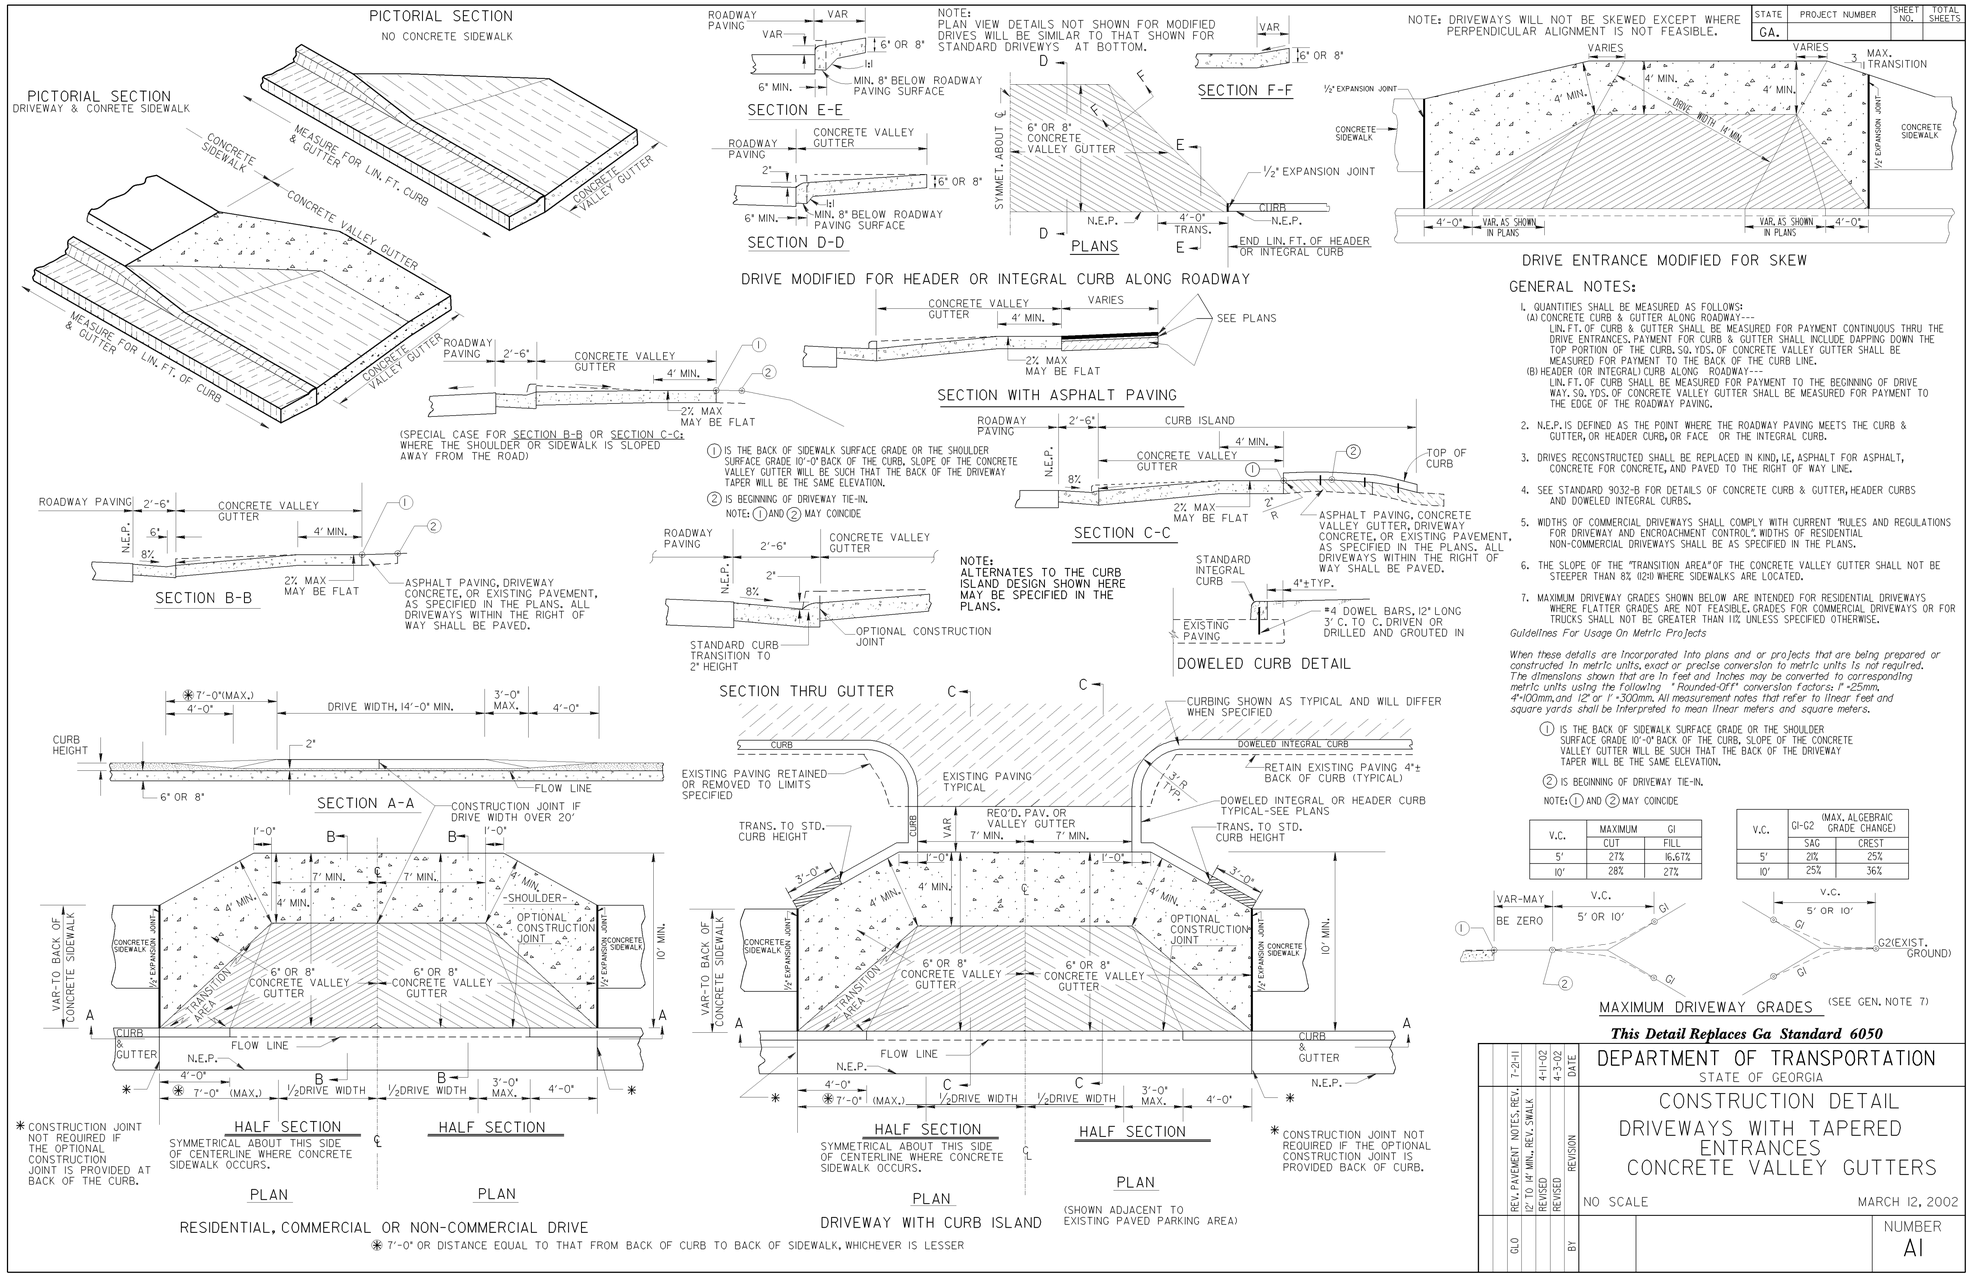

7/22/2011 2:16:33 PM \\GDOT-DSN1\GOPLOT\GCF\GO_Xfp8000.gcf gowens V:\GARY\revised A-1, A-2\A-1.prf

THE LPA GROUP
TRANSPORTATION CONSULTANTS
3595 ENGINEERING DRIVE
NORCROSS, GEORGIA 30092
(770) 263-9118

REVISION DATES		

STATE OF GEORGIA
DEPARTMENT OF TRANSPORTATION
OFFICE: INNOVATIVE PROGRAM DELIVERY
CONSTRUCTION DETAILS

DRAWING No. 40-003

3/1/2007 GPLN