AS-BUILT PLANS 12/12/12

STATE	PROJECT NUMBER	SHEET NO.	TOTAL SHEETS
GA.			

4' PAVED SHOULDER WITH 16" MILLED RUMBLE STRIPS

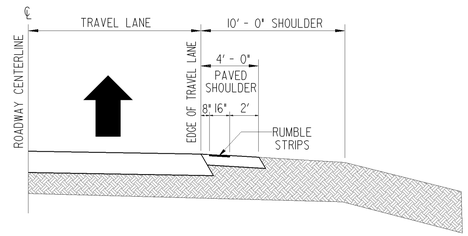

6' - 6" PAVED SHOULDER WITH 16" MILLED RUMBLE STRIPS

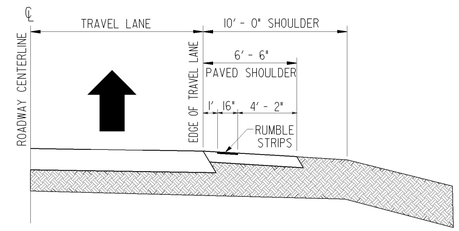

PEM, 6' - 6" PAVED SHOULDER WITH 16" MILLED RUMBLE STRIPS

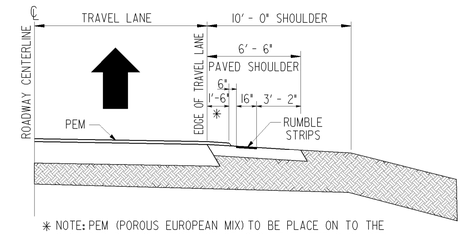

* NOTE: PEM (POROUS EUROPEAN MIX) TO BE PLACE ON TO THE SHOULDER PAVING A DISTANCE OF 12" ON THE LEFT SHOULDER AND 18" ON THE RIGHT SHOULDER.

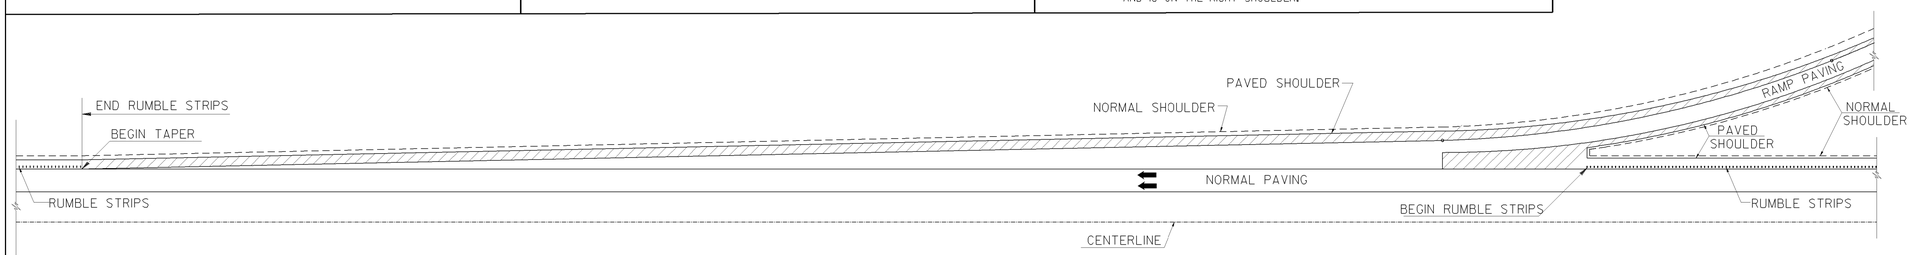

ENTRANCE RAMP

MILLED RUMBLE STRIP DETAILS

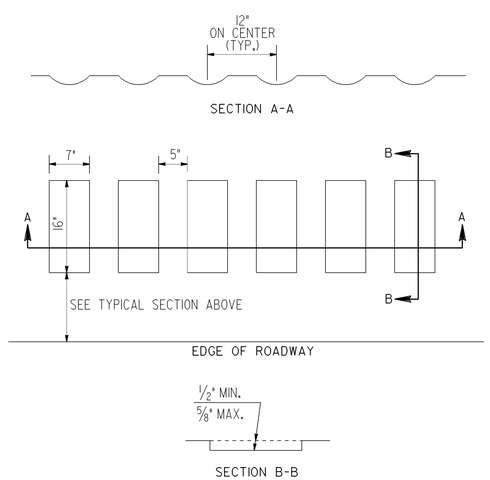

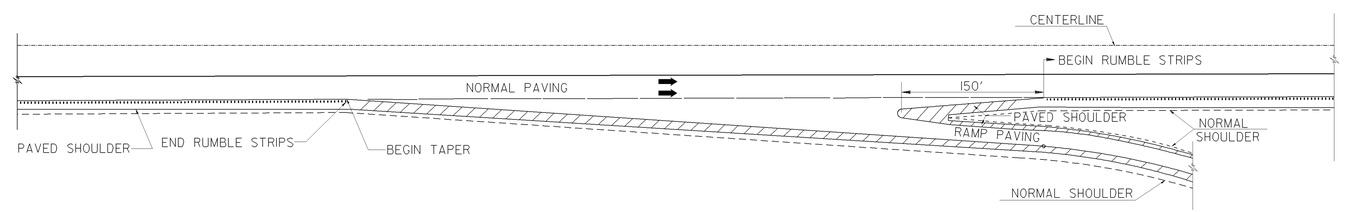

EXIT RAMP

BASIS OF PAYMENT:
INDENTATION RUMBLE STRIPS - GROUND-IN-PLACE (CONTINUOUS) ____GLM

DATE	REVISION	BY

DEPARTMENT OF TRANSPORTATION
STATE OF GEORGIA

CONSTRUCTION DETAIL
CONTINUOUS INDENTATION RUMBLE STRIPS - GROUND-IN-PLACE
INTERSTATE

NO SCALE — MARCH, 2010

NUMBER S-9

THE LPA GROUP
TRANSPORTATION CONSULTANTS
3595 ENGINEERING DRIVE
NORCROSS, GEORGIA 30092
(770) 263-9118

REVISION DATES

STATE OF GEORGIA
DEPARTMENT OF TRANSPORTATION
OFFICE: INNOVATIVE PROGRAM DELIVERY
CONSTRUCTION DETAILS

DRAWING No. 40-017