AS-BUILT PLANS 12/12/12

| STATE | PROJECT NUMBER | SHEET NO. | TOTAL SHEETS |
|---|---|---|---|
| GA. | | | |




M3-1




MB3-1 & MG3-1

| DIMENSIONS (INCHES) | | | | | | | | | | | |
|---|---|---|---|---|---|---|---|---|---|---|---|
| SIGN | A | B | C | D | E | F | G | H | J | K | L |
| BIKE | 12 | 4 | - | ¼ | 1 | 2D | 2¼D | 1 | ¾ | 4¼ | 4¼ |
| MIN & STD | 24 | 12 | ⅜ | ⅝ | 2¾ | 6C | 7C | 3¼ | 1½ | 10¼ | 10¼ |
| SPECIAL | 30 | 15 | ⅜ | ⅝ | 3¼ | 8C | 9C | 3¾ | 1½ | 12⅝ | 12⅝ |

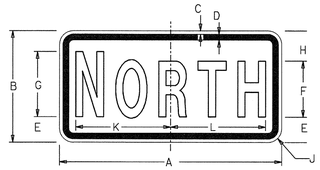


M3-2

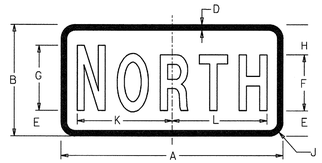


MB3-2 & MG3-2

| DIMENSIONS (INCHES) | | | | | | | | | | | |
|---|---|---|---|---|---|---|---|---|---|---|---|
| SIGN | A | B | C | D | E | F | G | H | J | K | L |
| BIKE | 12 | 4 | - | ¼ | 1 | 2D | 2¼D | 1 | ¾ | 3⅜ | 3⅜ |
| MIN & STD | 24 | 12 | ⅜ | ⅝ | 2¾ | 6C | 7C | 3¼ | 1½ | 7⅞ | 8¾ |
| SPECIAL | 30 | 15 | ⅜ | ⅝ | 3¼ | 8C | 9C | 3¾ | 1½ | 10⅜ | 11⅛ |

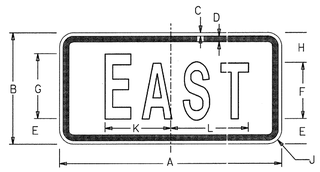


M3-3

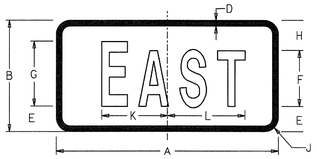


MB3-3 & MG3-3

| DIMENSIONS (INCHES) | | | | | | | | | | | |
|---|---|---|---|---|---|---|---|---|---|---|---|
| SIGN | A | B | C | D | E | F | G | H | J | K | L |
| BIKE | 12 | 4 | - | ¼ | 1 | 2D | 2¼D | 1 | ¾ | 4¼ | 4¼ |
| MIN & STD | 24 | 12 | ⅜ | ⅝ | 2¾ | 6C | 7C | 3¼ | 1½ | 10¼ | 9⅝ |
| SPECIAL | 30 | 15 | ⅜ | ⅝ | 3¼ | 8C | 9C | 3¾ | 1½ | 12⅝ | 12½ |

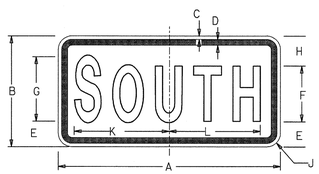


M3-4

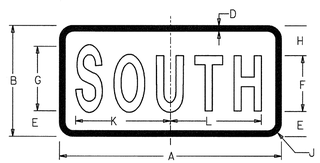


MB3-4 & MG3-4

| DIMENSIONS (INCHES) | | | | | | | | | | | |
|---|---|---|---|---|---|---|---|---|---|---|---|
| SIGN | A | B | C | D | E | F | G | H | J | K | L |
| BIKE | 12 | 4 | - | ¼ | 1 | 2D | 2¼D | 1 | ¾ | 3½ | 3½ |
| MIN & STD | 24 | 12 | ⅜ | ⅝ | 2¾ | 6C | 7C | 3¼ | 1½ | 8¾ | 8¾ |
| SPECIAL | 30 | 15 | ⅜ | ⅝ | 3¼ | 8C | 9C | 3¾ | 1½ | 10⅜ | 11⅛ |

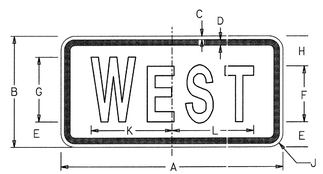GENERAL NOTES:

1. M3 (CONVENTIONAL ROADWAYS) SIGNS SHALL HAVE BLACK LEGENDS AND BORDERS ON WHITE REFLECTORIZED BACKGROUNDS.
2. MB3 (INTERSTATE HIGHWAYS) SIGNS SHALL HAVE WHITE REFLECTORIZED LEGENDS AND BORDERS ON BLUE REFLECTORIZED BACKGROUNDS.
3. MG3 (BIKE LANES) SIGNS SHALL HAVE WHITE REFLECTORIZED LEGENDS AND BORDERS ON GREEN REFLECTORIZED BACKGROUNDS.
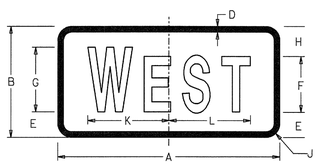
| DATE | REVISIONS |
|---|---|
| | |

GEORGIA DEPARTMENT OF TRANSPORTATION
OFFICE OF TRAFFIC SAFETY & DESIGN

DETAILS OF CARDINAL DIRECTION SIGNS

NO SCALE — JANUARY 2000

PCBDT8

T-4

THE LPA GROUP
TRANSPORTATION CONSULTANTS
3595 ENGINEERING DRIVE
NORCROSS, GEORGIA 30092
(770) 263-9118

REVISION DATES

STATE OF GEORGIA
DEPARTMENT OF TRANSPORTATION
OFFICE: INNOVATIVE PROGRAM DELIVERY
CONSTRUCTION DETAILS

DRAWING No. 40-022

3/1/2007 GPLN