10/3/2006 10:40:43 AM \\GDOT-DGN1\GOPLOT\OCF\go_tiff_output.gcf gowens M:\GARY\Revised 9003\9003.prf GO-RO6

STATE	PROJECT NUMBER	SHEET NO.	TOTAL SHEETS
GA.			

DETAILS OF RIGHT OF WAY MARKERS

NOTE: R/W MARKERS MAY BE EITHER CONCRETE OR GRANITE. ALL MARKERS SHALL BE PLACED AS DIRECTED BY THE ENGINEER.

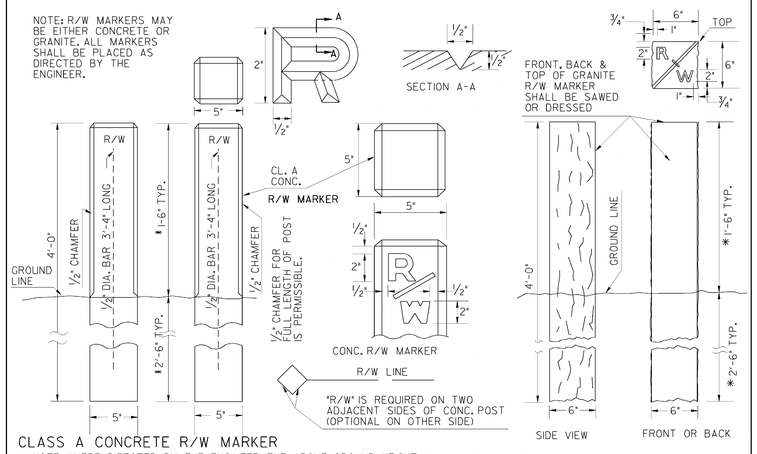

CLASS A CONCRETE R/W MARKER

* NOTE: WHERE DIRECTED BY THE ENGINEER, THE ABOVE GROUND HEIGHT OF ANY R/W MARKER SHALL BE REDUCED BY INCREASING THE DEPTH AS NEEDED WITH NO ADDITIONAL PAYMENT.

(ALTERNATE) GRANITE R/W MARKER

G.L.O.	REDRAWN TO MATCH METRIC	4-10-06
	GA. STD. 9003	
G.J.P.	REDRAWN	6-30-98
R.M.U.	REV. F.A.P. - SP. POST ALT.	9-26-90
R.M.U.	VAR. H.T. R/W MARKER	10-11-88
R.M.U.	ADD GRANITE R/W M.	5-24-85
BY	REVISION	DATE

DEPARTMENT OF TRANSPORTATION
STATE OF GEORGIA

STANDARD
DETAILS OF MARKERS
FEDERAL AID AND STATE
RIGHT OF WAY MARKERS

NO SCALE — REV. & REDR. DEC., 1981

DES. ____ DRW. R.M.U. TRA. G.M.E. CHK. R.K.C.

(SUBMITTED) STATE ROAD & AIRPORT DESIGN ENGINEER

(APPROVED) CHIEF ENGINEER

NUMBER 9003

10/3/2006 10:40:43 AM \\GDOT-DGN1\GOPLOT\OCF\go_tiff_output.gcf gowens M:\GARY\Revised 9003\9003.prf

AS-BUILT PLANS 12/12/12

3/1/2007 GPLN

THE LPA GROUP
TRANSPORTATION CONSULTANTS
A UNIT OF MICHAEL BAKER CORPORATION
3595 ENGINEERING DRIVE
NORCROSS, GEORGIA 30092
(770) 263-9118

REVISION DATES		

STATE OF GEORGIA
DEPARTMENT OF TRANSPORTATION
OFFICE: INNOVATIVE PROGRAM DELIVERY
GEORGIA STANDARDS

DRAWING No. 41-036