AS-BUILT PLANS 12/12/12

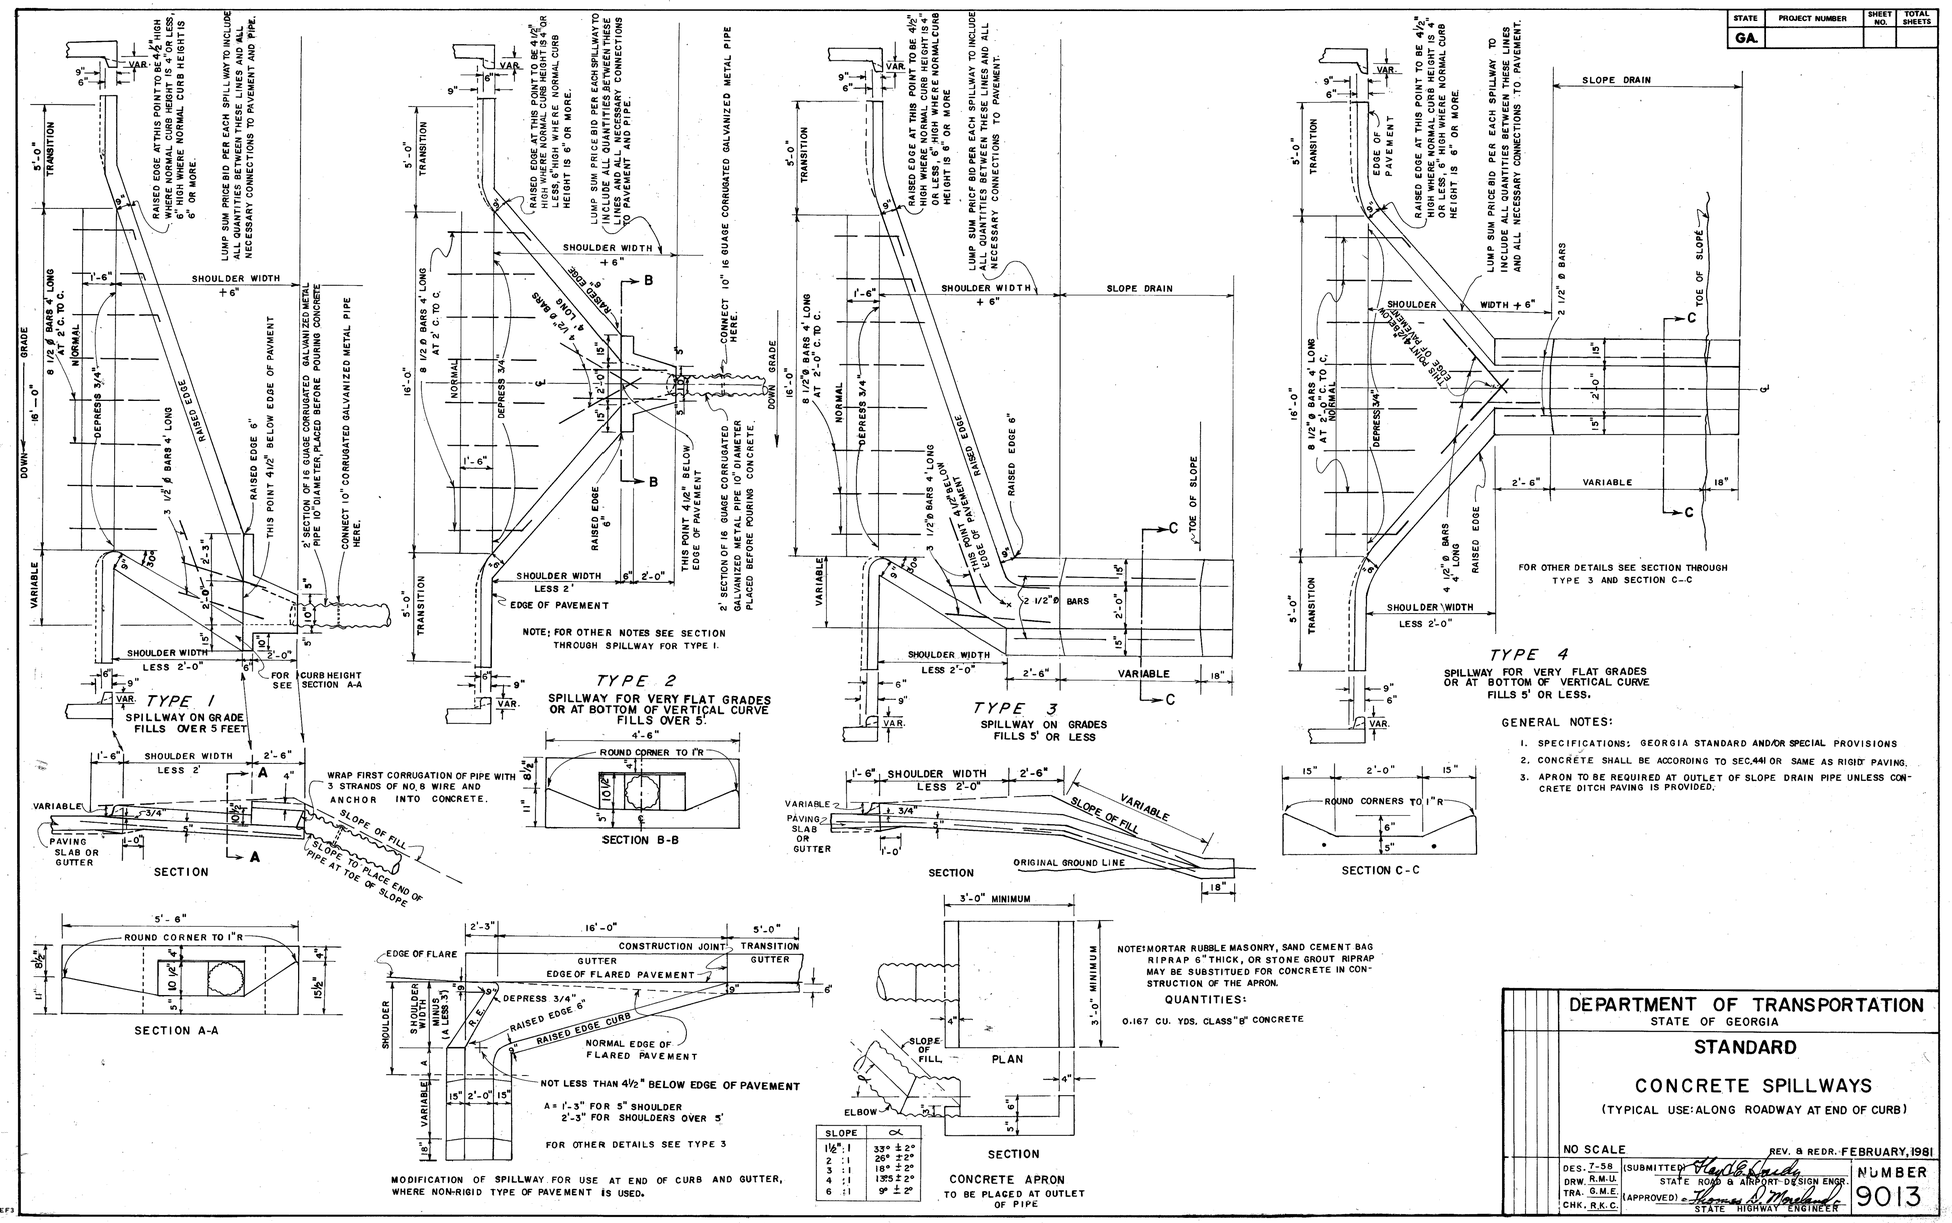

SLOPE	∝
1½:1	33° ± 2°
2 :1	26° ± 2°
3 :1	18° ± 2°
4 :1	13.25 ± 2°
6 :1	9° ± 2°

THE LPA GROUP
TRANSPORTATION CONSULTANTS
A UNIT OF MICHAEL BAKER CORPORATION
3595 ENGINEERING DRIVE
NORCROSS, GEORGIA 30092
(770) 263-9118

REVISION DATES

STATE OF GEORGIA
DEPARTMENT OF TRANSPORTATION
OFFICE: INNOVATIVE PROGRAM DELIVERY
GEORGIA STANDARDS

DRAWING No. 41-037

3/1/2007 GPLN