AS-BUILT PLANS 12/12/12

1/20/2006 10:38:53 AM \\GDOT-DSN1\GOPLOT\QCF\go_tiff_output.qcf gowens M:\GARY\revised d-21\D-21.prf GO-RD6

STATE	PROJECT NUMBER	SHEET NO.	TOTAL SHEETS
GA.			

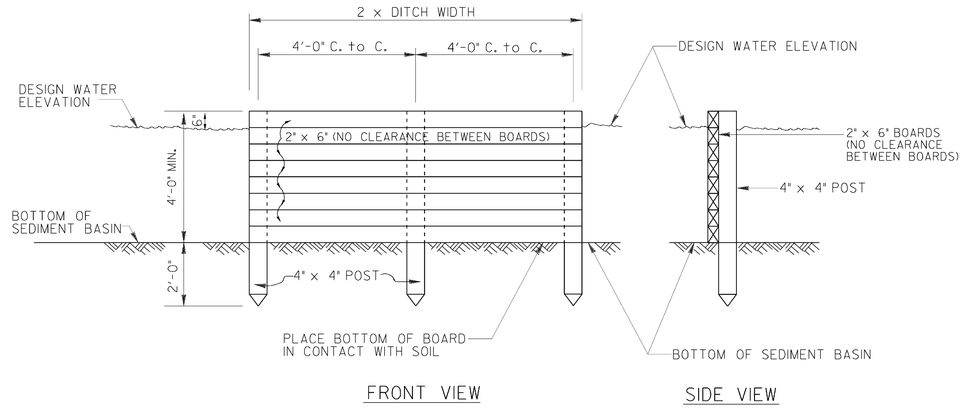

INLET BAFFLE

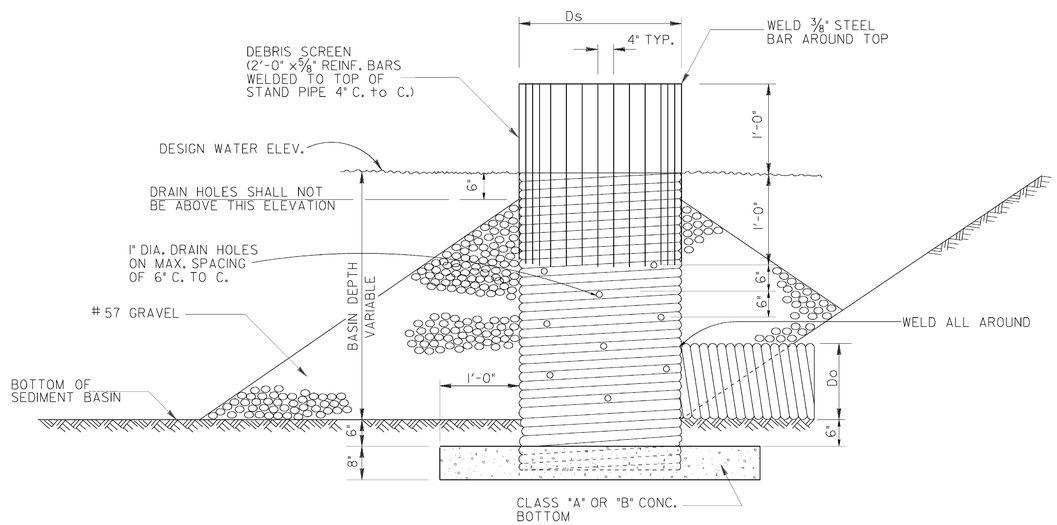

PRIMARY SPILLWAY
FOR
SEDIMENT BASIN TYPE-I

USES:

PRIMARY SPILLWAYS, TYPE-I, ARE TO BE USED WITH SEDIMENT BASINS, TYPE-I. (SEE SEPARATE SHEET).

G.L.O.	REVISED INLET BAFFLE AND PRIMARY SPILLWAY	1-20-06
J.M.W.	REVISED SPILLWAY FILTER	2-17-95
J.M.W.	ADDED "USES" GUIDE	5-14-93
R.M.U.	GEN. REVISION	6-2-89
J.M.W.	DELETED TYPE 2	4-6-89
J.M.W.	REVISED SEDIMENT	11-19-73
BY	REVISION	DATE

DEPARTMENT OF TRANSPORTATION
STATE OF GEORGIA

INLET BAFFLE
PRIMARY SPILLWAY TYPE - I

J.M.W.
J.L.P.

NUMBER
D-21

1/20/2006 10:38:53 AM \\GDOT-DSN1\GOPLOT\QCF\go_tiff_output.qcf gowens M:\GARY\revised d-21\D-21.prf

THE LPA GROUP
TRANSPORTATION CONSULTANTS
3595 ENGINEERING DRIVE
NORCROSS, GEORGIA 30092
(770) 263-9118

REVISION DATES

STATE OF GEORGIA
DEPARTMENT OF TRANSPORTATION
OFFICE: INNOVATIVE PROGRAM DELIVERY

EROSION CONTROL CONSTRUCTION DETAILS

DRAWING No.
56-004

3/1/2007 GPLN