AS-BUILT PLANS 12/12/12

STATE	PROJECT NUMBER	SHEET NO.	TOTAL SHEETS
GA.			

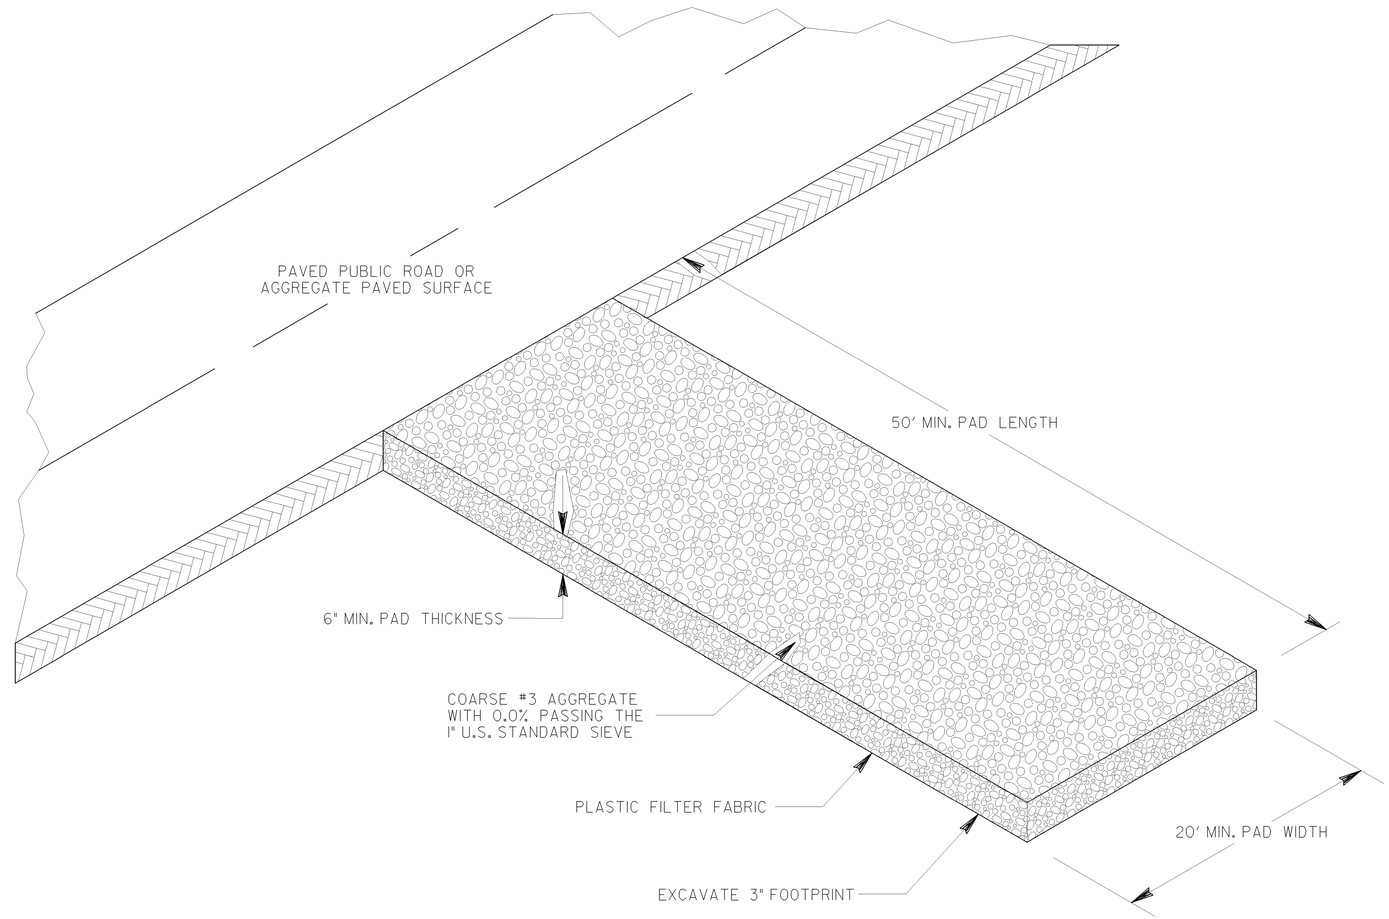

NOTES:
1) STONE AGGREGATE SHALL BE KEPT LOOSE OR SCARIFIED WHEN AGGREGATE BECOMES CONSOLIDATED.
2) CONSTRUCTION EXITS ARE NOT REQUIRED FOR DIRT PUBLIC ROADS.

MAINTENANCE

THE EXIT SHALL BE MAINTAINED IN A CONDITION WHICH WILL PREVENT TRACKING OR FLOW OF MUD ONTO PUBLIC RIGHTS-OF-WAY. THIS MAY REQUIRE PERIODIC TOP DRESSING WITH COARSE #3 AGGREGATE, AS CONDITIONS DEMAND, AND REPAIR AND/OR CLEANOUT OF ANY STRUCTURES TO TRAP SEDIMENT. ALL MUD AND DEBRIS SPILLED, DROPPED, WASHED, OR TRACKED FROM VEHICLES OR SITE ONTO ROADWAYS OR INTO STORM DRAINS MUST BE REMOVED IMMEDIATELY.

PAY ITEM: 163-0300__CONSTRUCTION EXIT___EACH

1-19-11 DATE	DEPARTMENT OF TRANSPORTATION STATE OF GEORGIA	
REV. CONSTR. EXIT LABELS REVISION	CONSTRUCTION DETAILS CONSTRUCTION EXIT	
	NO SCALE	FEBRUARY 2001
TPC BY		NUMBER D-41

1/18/2011 8:15:10 AM \\GDOT-DSN\GOPLOT\QCF\GO_Klp8000.qcf gowens V:\GARY\Rev. Construction Details\D-41\D-41.prf

THE LPA GROUP
TRANSPORTATION CONSULTANTS
3595 ENGINEERING DRIVE
NORCROSS, GEORGIA 30092
(770) 263-9118

REVISION DATES		

STATE OF GEORGIA
DEPARTMENT OF TRANSPORTATION
OFFICE: INNOVATIVE PROGRAM DELIVERY

EROSION CONTROL CONSTRUCTION DETAILS

DRAWING No. 56-011

3/1/2007 GPLN