


State	Project Number	Sheet No.	Total Sheets
GA	CSNHS-0006-00(043)	---	---

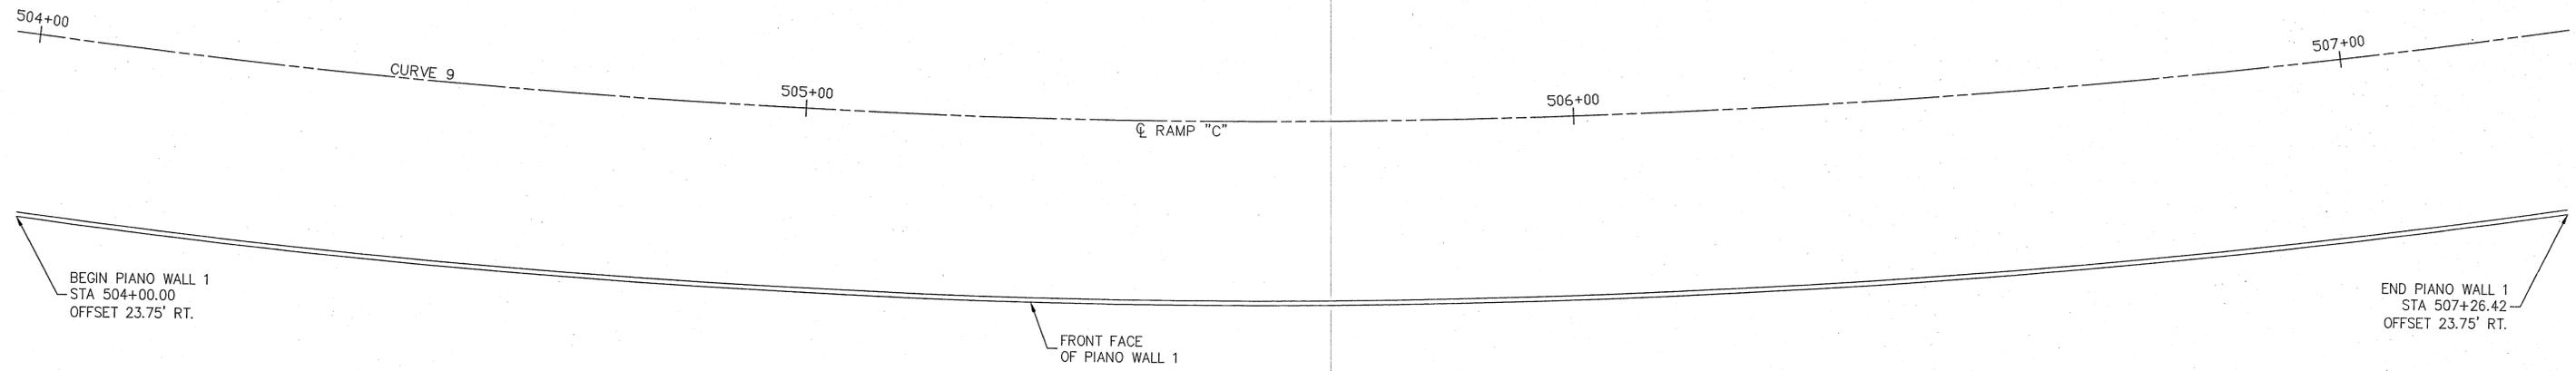

PIANO WALL 1 PLAN VIEW
SCALE : 1" = 10'

CURVE #8

PI STA. = 504+26.36
 $\Delta = 24^\circ 40' 33''$
 $D = 4' 46' 29''$
 $R = 1200.00'$
 $T = 262.47'$
 $L = 516.81'$

- NOTES:**
- OFFSETS ARE TO FRONT FACE OF WALL.
 - FOR WALL ELEVATIONS, SEE SHT. 3.
 - FOR TYPICAL SECTION, SEE SHT. 4.
 - FOR PIANO WALL DETAILS, SEE SHTS. 5-8.

DATE: **MAR 0 1 2011**
 Approved in general. Details not checked. This approval shall not relieve the Contractor of any responsibility for conformity with the contract Plans and Specifications.
 Georgia DOT
 Office of Bridge Design
 By: *[Signature]*

GEORGIA DEPARTMENT OF TRANSPORTATION HIGHWAY DIVISION - BRIDGE DESIGN	
RIDGEWALK PARKWAY OVER I-575 CHEROKEE COUNTY	
REINFORCED EARTH RETAINING WALL	
PIANO WALL 1 PLAN VIEW	
DESIGNED <u>vg</u>	TRACED _____
DRAWN <u>vg</u>	CHECKED <u>[Signature]</u>
REVIEWED _____	APPROVED _____

FINAL FOR REVIEW
2/22/11



"REINFORCED EARTH" is the registered trademark of The Reinforced Earth Company.



WALL SHEET
OF _____

This drawing contains information proprietary to The Reinforced Earth Company, and is being furnished for the use of THE GEORGIA DEPT. OF TRANSPORTATION only in connection with this project, and the information contained is not to be transmitted to any other organization unless specifically authorized in writing by The Reinforced Earth Company. The Reinforced Earth Company is exclusive licensee in the United States under patents issued to Henri Vidal, and the furnishing of this drawing does not constitute an expressed or implied license under the Vidal patents.