STATE	PROJECT NUMBER	SHEET NO.	TOTAL SHEETS
GA	CSNHS-0006-00(043)	1	25

DEPARTMENT OF TRANSPORTATION
STATE OF GEORGIA

RIGHT OF WAY OF PROPOSED
RIDGEWALK PARKWAY OVER I-575
CHEROKEE COUNTY

FEDERAL AID PROJECT

CSNHS-0006-00(043)

FEDERAL ROUTE No.: 575
STATE ROUTE No.: 5
P.I. No.: 0006043

AS-BUILT PLANS
12/12/12

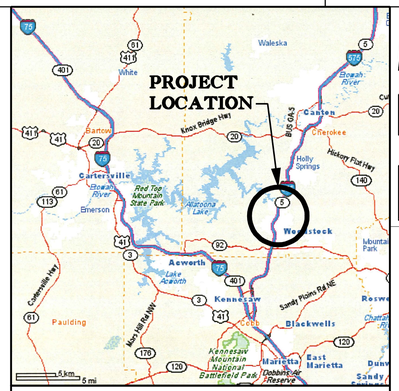

LOCATION SKETCH

NOTE: THE CO-ORDINATES LISTED ARE WEST ZONE GRID CO-ORDINATES BASED ON THE GA. STATE PLANE CO-ORDINATE SYSTEM OF
HORIZONTAL DATUM : NAD 83/94 HARN
VERTICAL DATUM : NAVD 88

MID-POINT COORDINATES
STATION= 645+66.90
N: 1498363.6670
E: 2186369.6530

PROJECT DESIGNATION : FULL OVERSIGHT
PDP CLASSIFICATION : MAJOR
FUNCTIONAL CLASSIFICATION : PRINCIPAL ARTERIAL

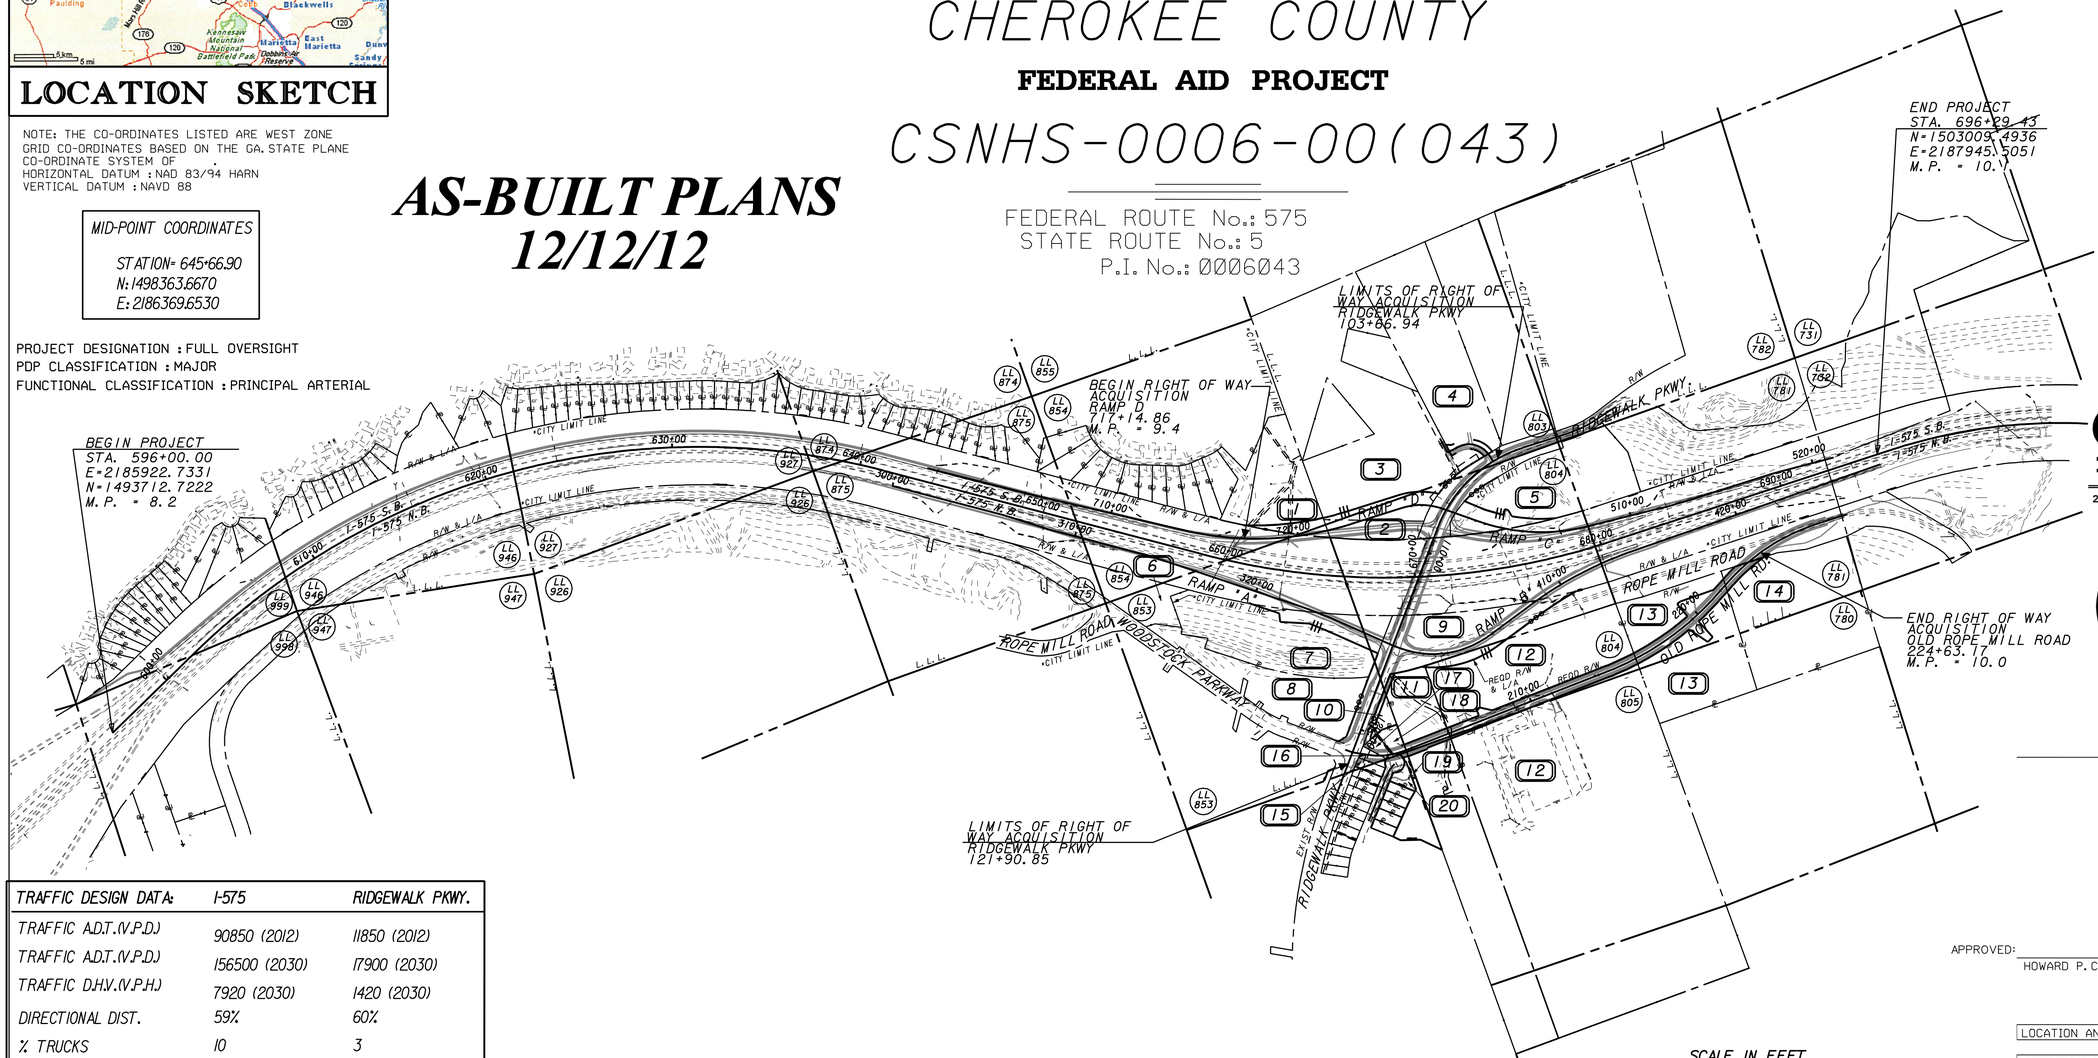

TRAFFIC DESIGN DATA:	I-575	RIDGEWALK PKWY.
TRAFFIC A.D.T.(V.P.D.)	90850 (2012)	11850 (2012)
TRAFFIC A.D.T.(V.P.D.)	156500 (2030)	17900 (2030)
TRAFFIC D.H.V.(V.P.H.)	7920 (2030)	1420 (2030)
DIRECTIONAL DIST.	59%	60%
% TRUCKS	10	3
24 HR.TRUCKS %	7	3
SPEED DESIGN (MPH)	75	45

CSNHS-0006-00(043)
CHEROKEE COUNTY

NOTE :
ALL REFERENCES IN THIS DOCUMENT,WHICH INCLUDES ALL PAPERS,WRITINGS, DOCUMENTS,DRAWINGS,OR PHOTOGRAPHS USED,OR TO BE USED IN CONNECTION WITH THIS DOCUMENT,TO "STATE HIGHWAY DEPARTMENT OF GEORGIA ","STATE HIGHWAY DEPARTMENT ",GEORGIA STATE HIGHWAY DEPARTMENT ","HIGHWAY DEPARTMENT ",OR "DEPARTMENT "WHEN THE CONTEXT THEREOF MEANS THE STATE HIGHWAY DEPARTMENT OF GEORGIA,AND SHALL BE DEEMED TO MEAN THE DEPARTMENT OF TRANSPORTATION.

LENGTH OF RIGHT OF WAY PROJECT	COUNTY NO. 057
	MILES
NET LENGTH OF RIGHT OF WAY	0.343
NET LENGTH OF BRIDGES	0.074
NET LENGTH OF EXCEPTIONS	0.000
GROSS LENGTH OF RIGHT OF WAY	0.417

SCALE IN FEET
0 400 800 1600

THIS PROJECT IS LOCATED 100% IN CHEROKEE COUNTY AND CONGRESSIONAL DISTRICT 6 .
LAND DISTRICT 15
GMD 890
• - CITY OF WOODSTOCK

CONVENTIONAL SIGNS

STATE OR COUNTY LINE
CITY LIMIT LINE
LAND LOT LINE
PROPERTY LINE
SURVEY OR BASE LINE
RIGHT OF WAY LINE
- EXISTING
- REQUIRED
- LIMIT OF ACCESS
- REQD R/W & LIMIT OF ACCESS
- R/W MARKERS

FENCE
RAILROAD
POWER LINE
TELEPHONE LINE
POWER POLES
TELEPHONE OR TELEGRAPH POLES

THE LPA GROUP
TRANSPORTATION CONSULTANTS
A UNIT OF MICHAEL BAKER CORPORATION
3595 ENGINEERING DRIVE
NORCROSS, GEORGIA 30092
(770) 263-9118

CROY ENGINEERING
Engineers Planners Surveyors
200 NORTH COBB PARKWAY, BLDG. 400, SUITE 413
MARIETTA, GA 30062
PHONE: (770) 971-5407 FAX: (770) 971-0620

GEORGIA REGISTERED No. 029656 PROFESSIONAL ENGINEER GREGORY D. TEAGUE

THIS PLAN SET IS SEALED ONLY FOR THE AS-BUILT CONDITIONS DOCUMENTED THROUGH THE R.F.I. AND RED LINE PROCESS BY THE CONTRACTOR. THIS DOCUMENT WAS ORIGINALLY SEALED BY GREGORY D. TEAGUE, LICENSE NO. 029656 ON MAY 5,2009.

THIS MEDIA SHALL NOT BE CONSIDERED A CERTIFIED DOCUMENT AS TO THE ORIGINAL DOCUMENT BUT CERTIFIED ONLY AS TO THE REVISIONS.

PLANS PREPARED BY:
GREGORY D. TEAGUE, P.E.
PROJECT MANAGER

UNDER THE SUPERVISION OF
DARRYL D. VANMETER, P.E.
OFFICE OF INNOVATIVE PROGRAM DELIVERY

APPROVED:
HOWARD P. COPELAND , STATE RIGHT OF WAY ADMINISTRATOR DATE

LOCATION AND DESIGN APPROVAL DATE: 06-01-2009

PLANS COMPLETED DATE: 05-28-2009

REVISIONS:
11/09/09 SHEETS 1,5,6,25
01/04/10 SHEETS 1,9,13,15,17,18,21-23
02/18/10 SHEETS 1,17,18 & 23
05/26/10 SHEETS 1, 7, 14, 24, 25
07/29/10 SHEETS 1, 14, 15, 21, 25