State	Project Number	Sheet No.	Total Sheets
GA	CSNHS-0006-00(043)	__	__

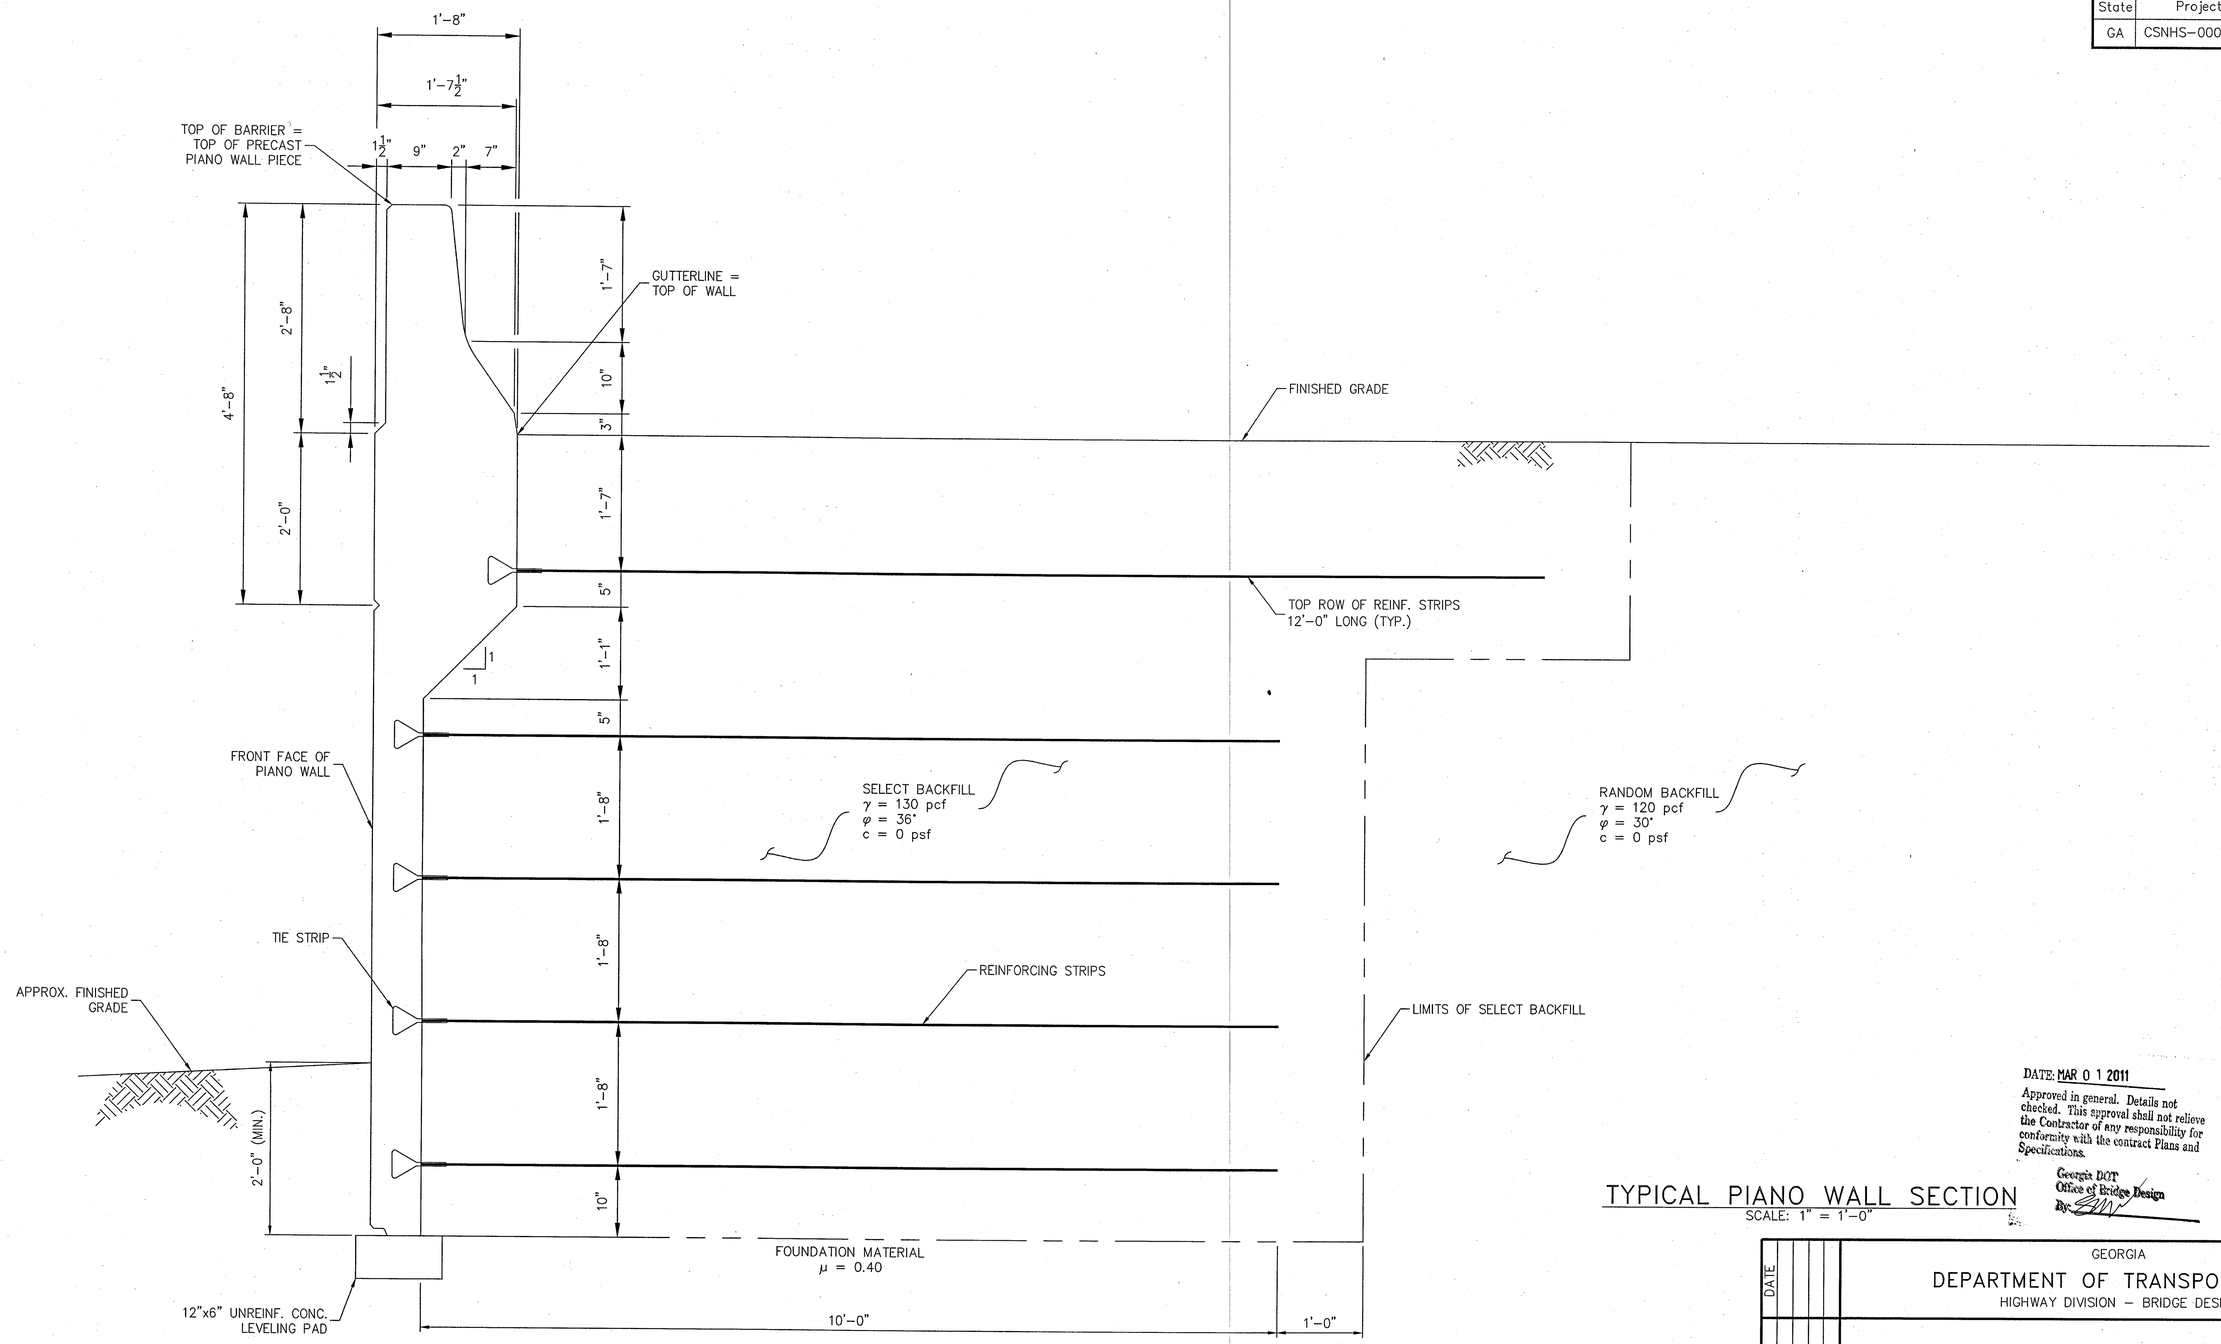

DATE: MAR 0 1 2011

Approved in general. Details not checked. This approval shall not relieve the Contractor of any responsibility for conformity with the contract Plans and Specifications.

Georgia DOT
Office of Bridge Design
By:

TYPICAL PIANO WALL SECTION

SCALE: 1" = 1'-0"

This drawing contains information proprietary to The Reinforced Earth Company, and is being furnished for the use of THE GEORGIA DEPT. OF TRANSPORTATION only in connection with this project, and the information contained is not to be transmitted to any other organization unless specifically authorized in writing by The Reinforced Earth Company. The Reinforced Earth Company is exclusive licensee in the United States under patents issued to Henri Vidal, and the furnishing of this drawing does not constitute an expressed or implied license under the Vidal patents.

FINAL FOR REVIEW
2/22/11

REINFORCED EARTH®
25 Technology Parkway South, Suite 100, Norcross, GA 30092, (770) 242-9415

"REINFORCED EARTH" is the registered trademark of The Reinforced Earth Company.

GEORGIA REGISTERED No. 10711 PROFESSIONAL ENGINEER 2/22/11 FRANK W. FORDHAM

WALL SHEET OF

DATE	REVISIONS	BY

GEORGIA
DEPARTMENT OF TRANSPORTATION
HIGHWAY DIVISION – BRIDGE DESIGN

RIDGEWALK PARKWAY OVER I-575
CHEROKEE COUNTY

REINFORCED EARTH RETAINING WALL

TYPICAL SECTION

DESIGNED VG	TRACED	REVIEWED
DRAWN VG	CHECKED FWF	APPROVED

Z:\GEORGIA\14479 – Ridgewalk Pkwy Over I-575 – SQR – E\Piano Wall\14479, 04 – Typical Sections.dwg