



TIE STRIP LOCATION DETAIL
(BACK FACE)

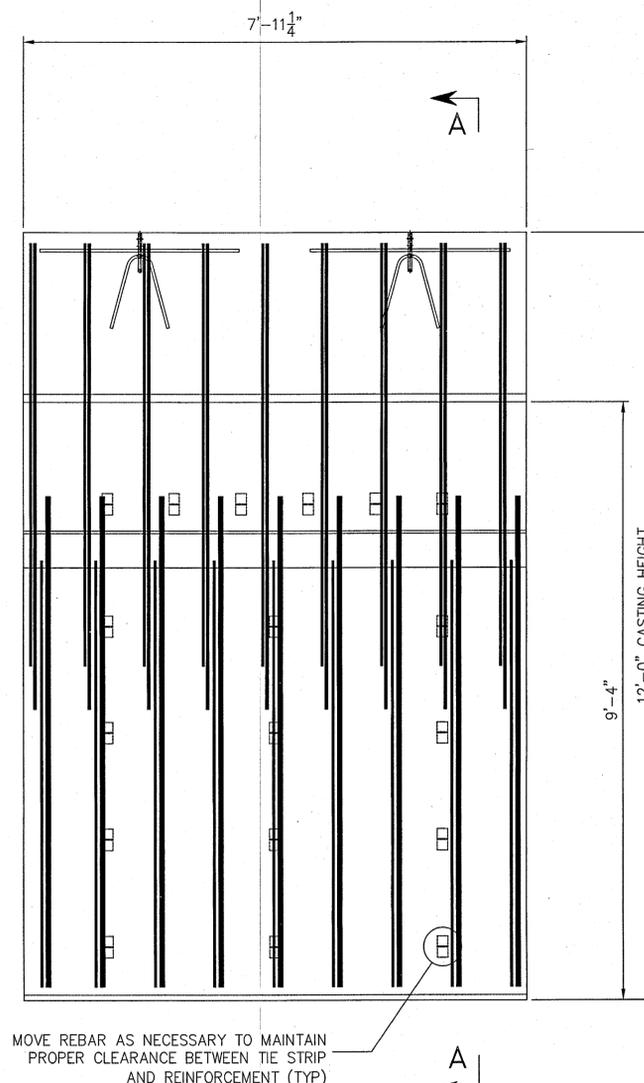

REINFORCEMENT DETAIL
(BACK FACE)

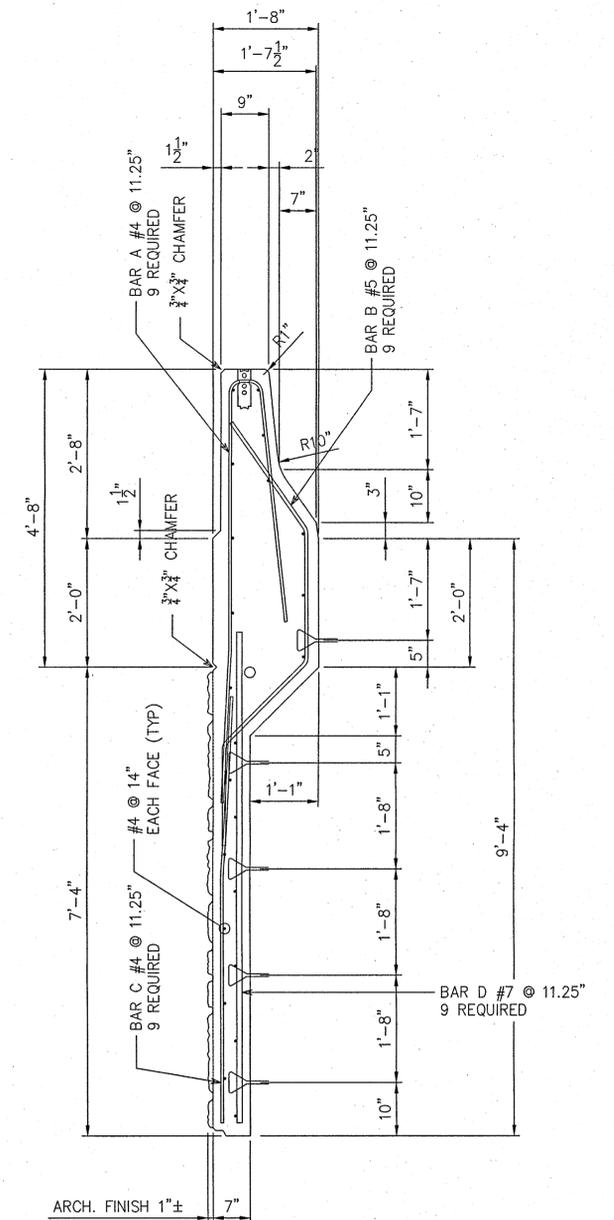

TYPICAL PANEL SECTION A-A

NOTES:
- FOR BAR BENDING DETAILS, SEE SHT. 7.


DATE: MAR 01 2011
Approved in general. Details not checked. This approval shall not relieve the Contractor of any responsibility for conformity with the contract Plans and Specifications.
Georgia DOT
Office of Bridge Design
By: [Signature]

This drawing contains information proprietary to The Reinforced Earth Company, and is being furnished for the use of THE GEORGIA DEPT. OF TRANSPORTATION only in connection with this project, and the information contained is not to be transmitted to any other organization unless specifically authorized in writing by The Reinforced Earth Company. The Reinforced Earth Company is exclusive licensee in the United States under patents issued to Henri Vidal, and the furnishing of this drawing does not constitute an expressed or implied license under the Vidal patents.

FINAL FOR REVIEW
2/22/11



"REINFORCED EARTH" is the registered trademark of The Reinforced Earth Company.

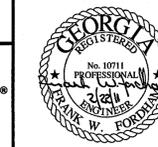

WALL SHEET
OF

GEORGIA DEPARTMENT OF TRANSPORTATION HIGHWAY DIVISION - BRIDGE DESIGN		RIDGEWALK PARKWAY OVER I-575 CHEROKEE COUNTY		REINFORCED EARTH RETAINING WALL		PIANO WALL PANEL 112B ₂₄ DETAILS	
DESIGNED	Vg	TRACED		REVIEWED			
DRAWN	2220	CHECKED	FME	APPROVED			