STATE	PROJECT NUMBER	SHEET NO.	TOTAL SHEETS
GA	CSNHS-0006-00(043)	11	25

AS-BUILT PLANS 12-12-2012

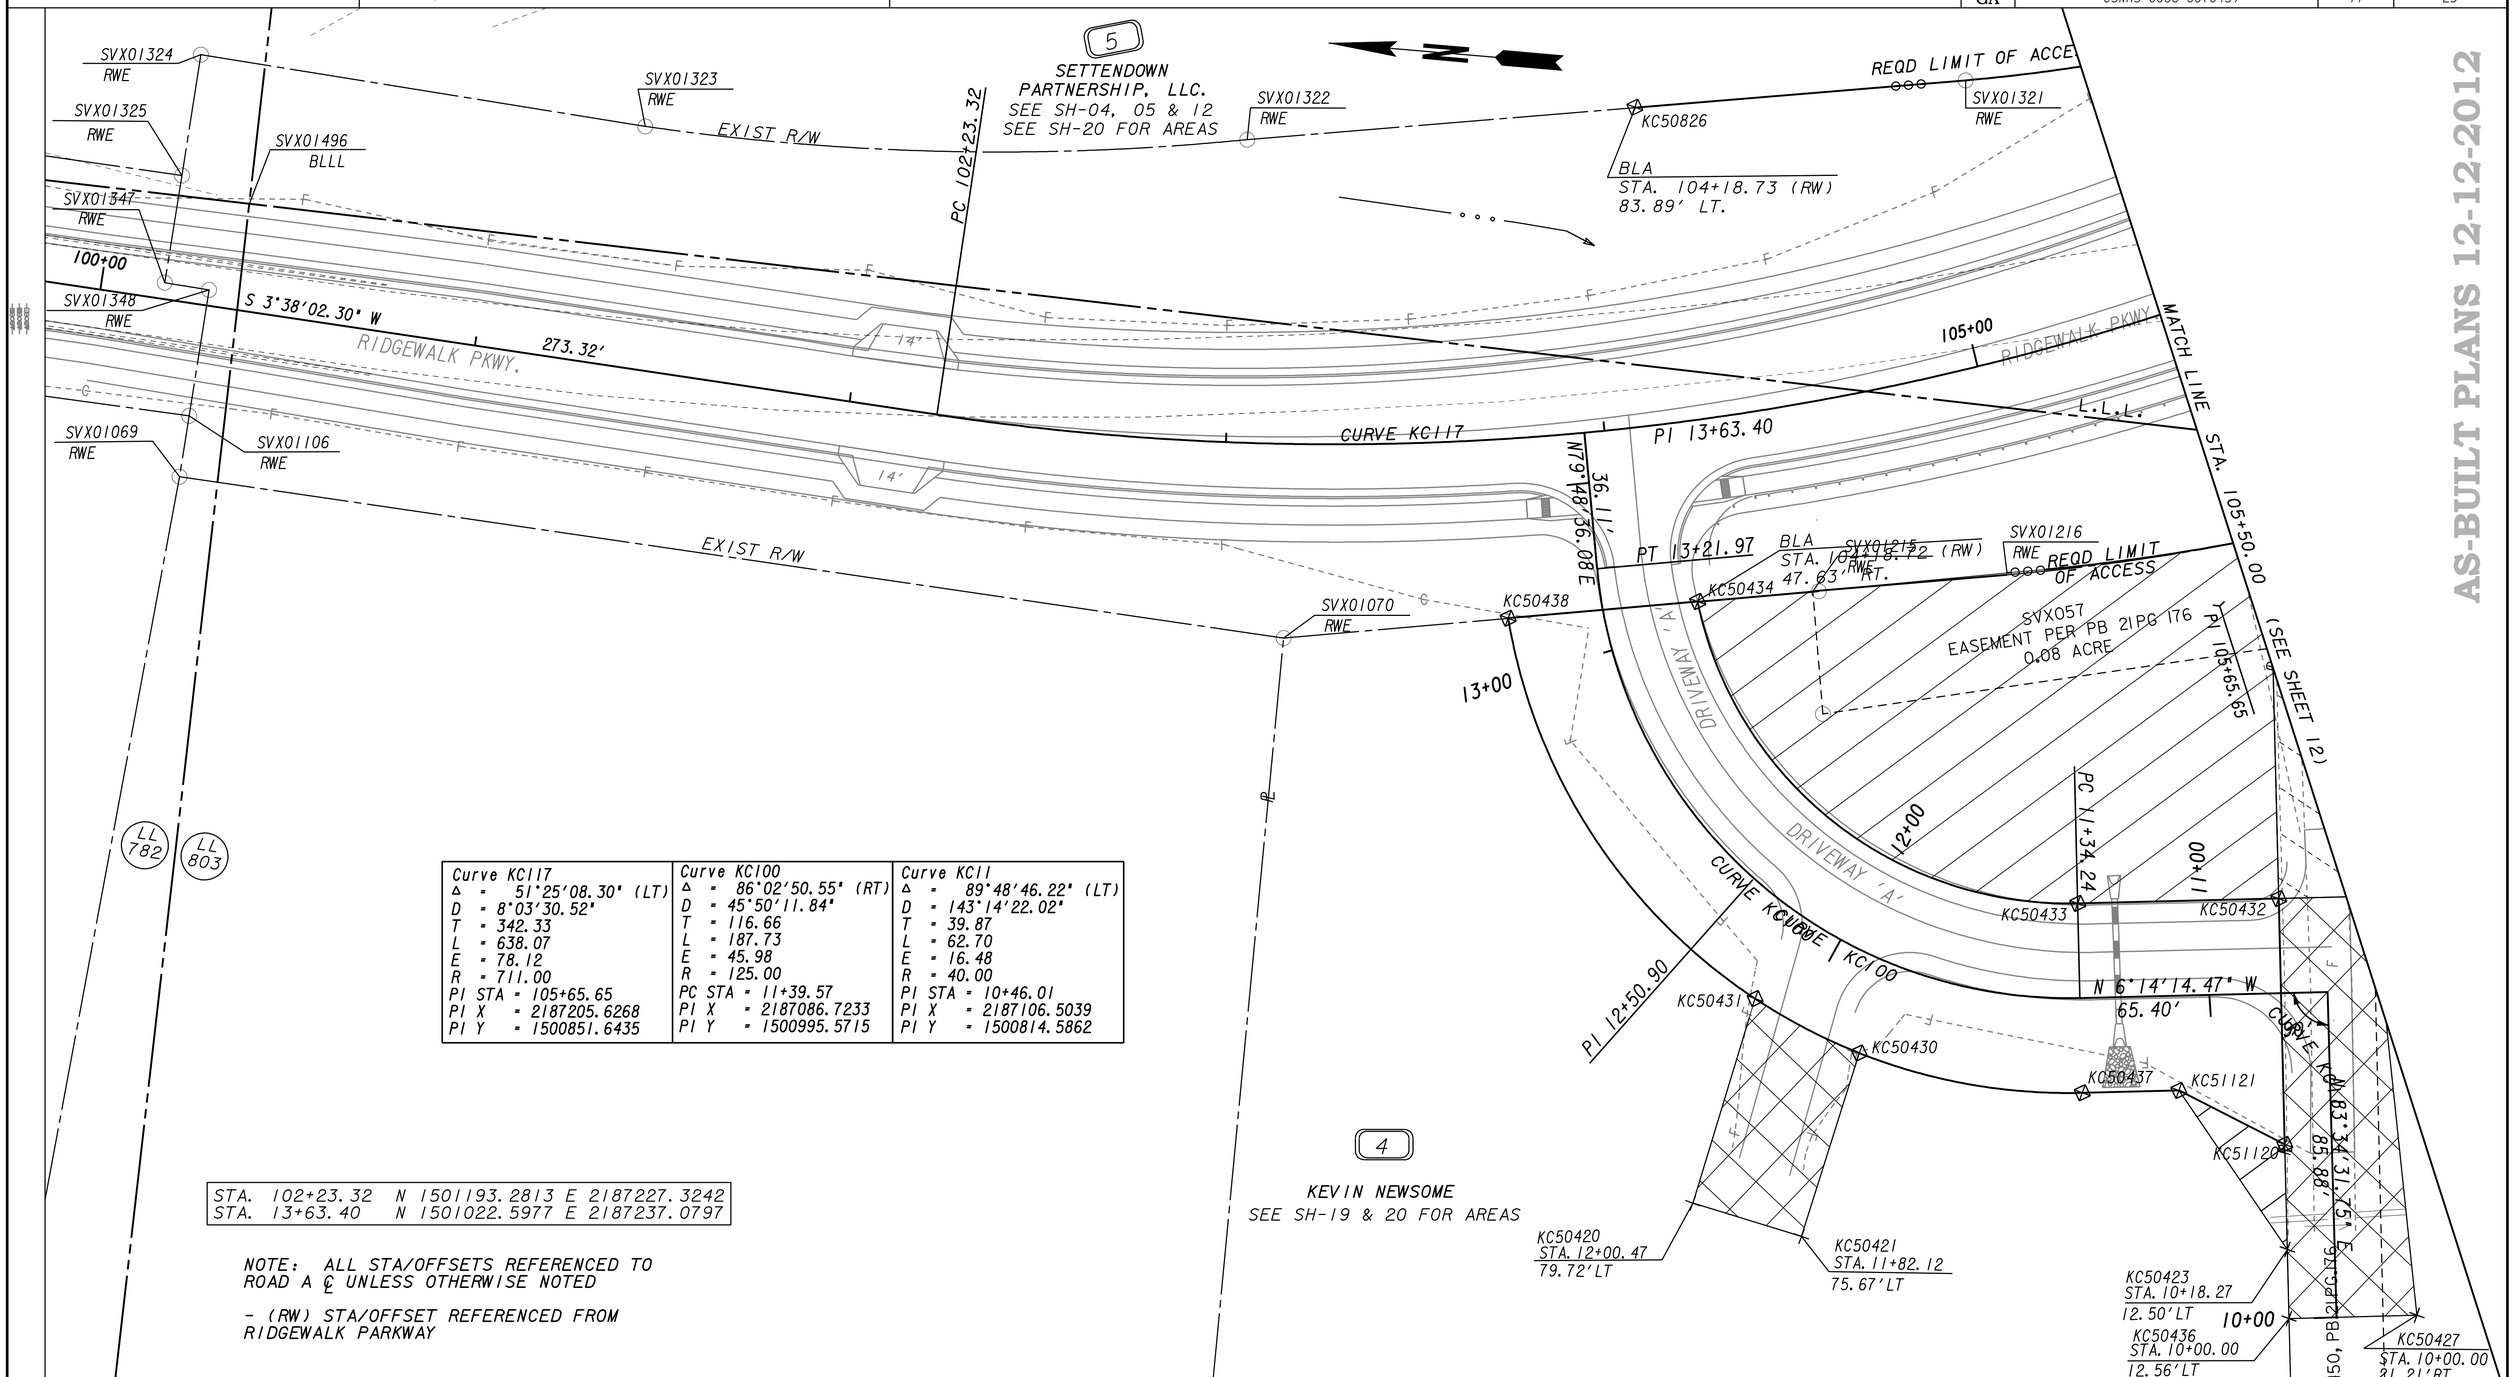

Curve KC117	Curve KC100	Curve KC11
Δ = 51°25'08.30" (LT)	Δ = 86°02'50.55" (RT)	Δ = 89°48'46.22" (LT)
D = 8°03'30.52"	D = 45°50'11.84"	D = 143°14'22.02"
T = 342.33	T = 116.66	T = 39.87
L = 638.07	L = 187.73	L = 62.70
E = 78.12	E = 45.98	E = 16.48
R = 711.00	R = 125.00	R = 40.00
PI STA = 105+65.65	PC STA = 11+39.57	PI STA = 10+46.01
PI X = 2187205.6268	PI X = 2187086.7233	PI X = 2187106.5039
PI Y = 1500851.6435	PI Y = 1500995.5715	PI Y = 1500814.5862

STA. 102+23.32 N 1501193.2813 E 2187227.3242
STA. 13+63.40 N 1501022.5977 E 2187237.0797

NOTE: ALL STA/OFFSETS REFERENCED TO ROAD A ℄ UNLESS OTHERWISE NOTED

- (RW) STA/OFFSET REFERENCED FROM RIDGEWALK PARKWAY

4

KEVIN NEWSOME
SEE SH-19 & 20 FOR AREAS

PROPERTY AND EXISTING R/W LINE
REQUIRED R/W LINE
CONSTRUCTION LIMITS
EASEMENT FOR CONSTR & MAINTENANCE OF SLOPES
EASEMENT FOR CONSTR OF SLOPES
EASEMENT FOR CONSTR OF DRIVES

BEGIN LIMIT OF ACCESS.....BLA
END LIMIT OF ACCESS.....ELA
LIMIT OF ACCESS
REQ'D R/W & LIMIT OF ACCESS

SCALE IN FEET
0 20 40 80

THE LPA GROUP
TRANSPORTATION CONSULTANTS
3595 ENGINEERING DRIVE
NORCROSS, GEORGIA 30092
(770) 263-9118

DATE	REVISIONS	DATE	REVISIONS

STATE OF GEORGIA
DEPARTMENT OF TRANSPORTATION

RIGHT OF WAY MAP

PROJECT NO: CSNHS-0006-00(043
COUNTY: CHEROKEE
LAND LOT NO: 803
LAND DISTRICT: 15
GMD 890
DATE 09-30-08 SH 11 OF 25