State	Project Number	Sheet No.	Total Sheets
GA	CSHNS-0006-00 (043)	__	__

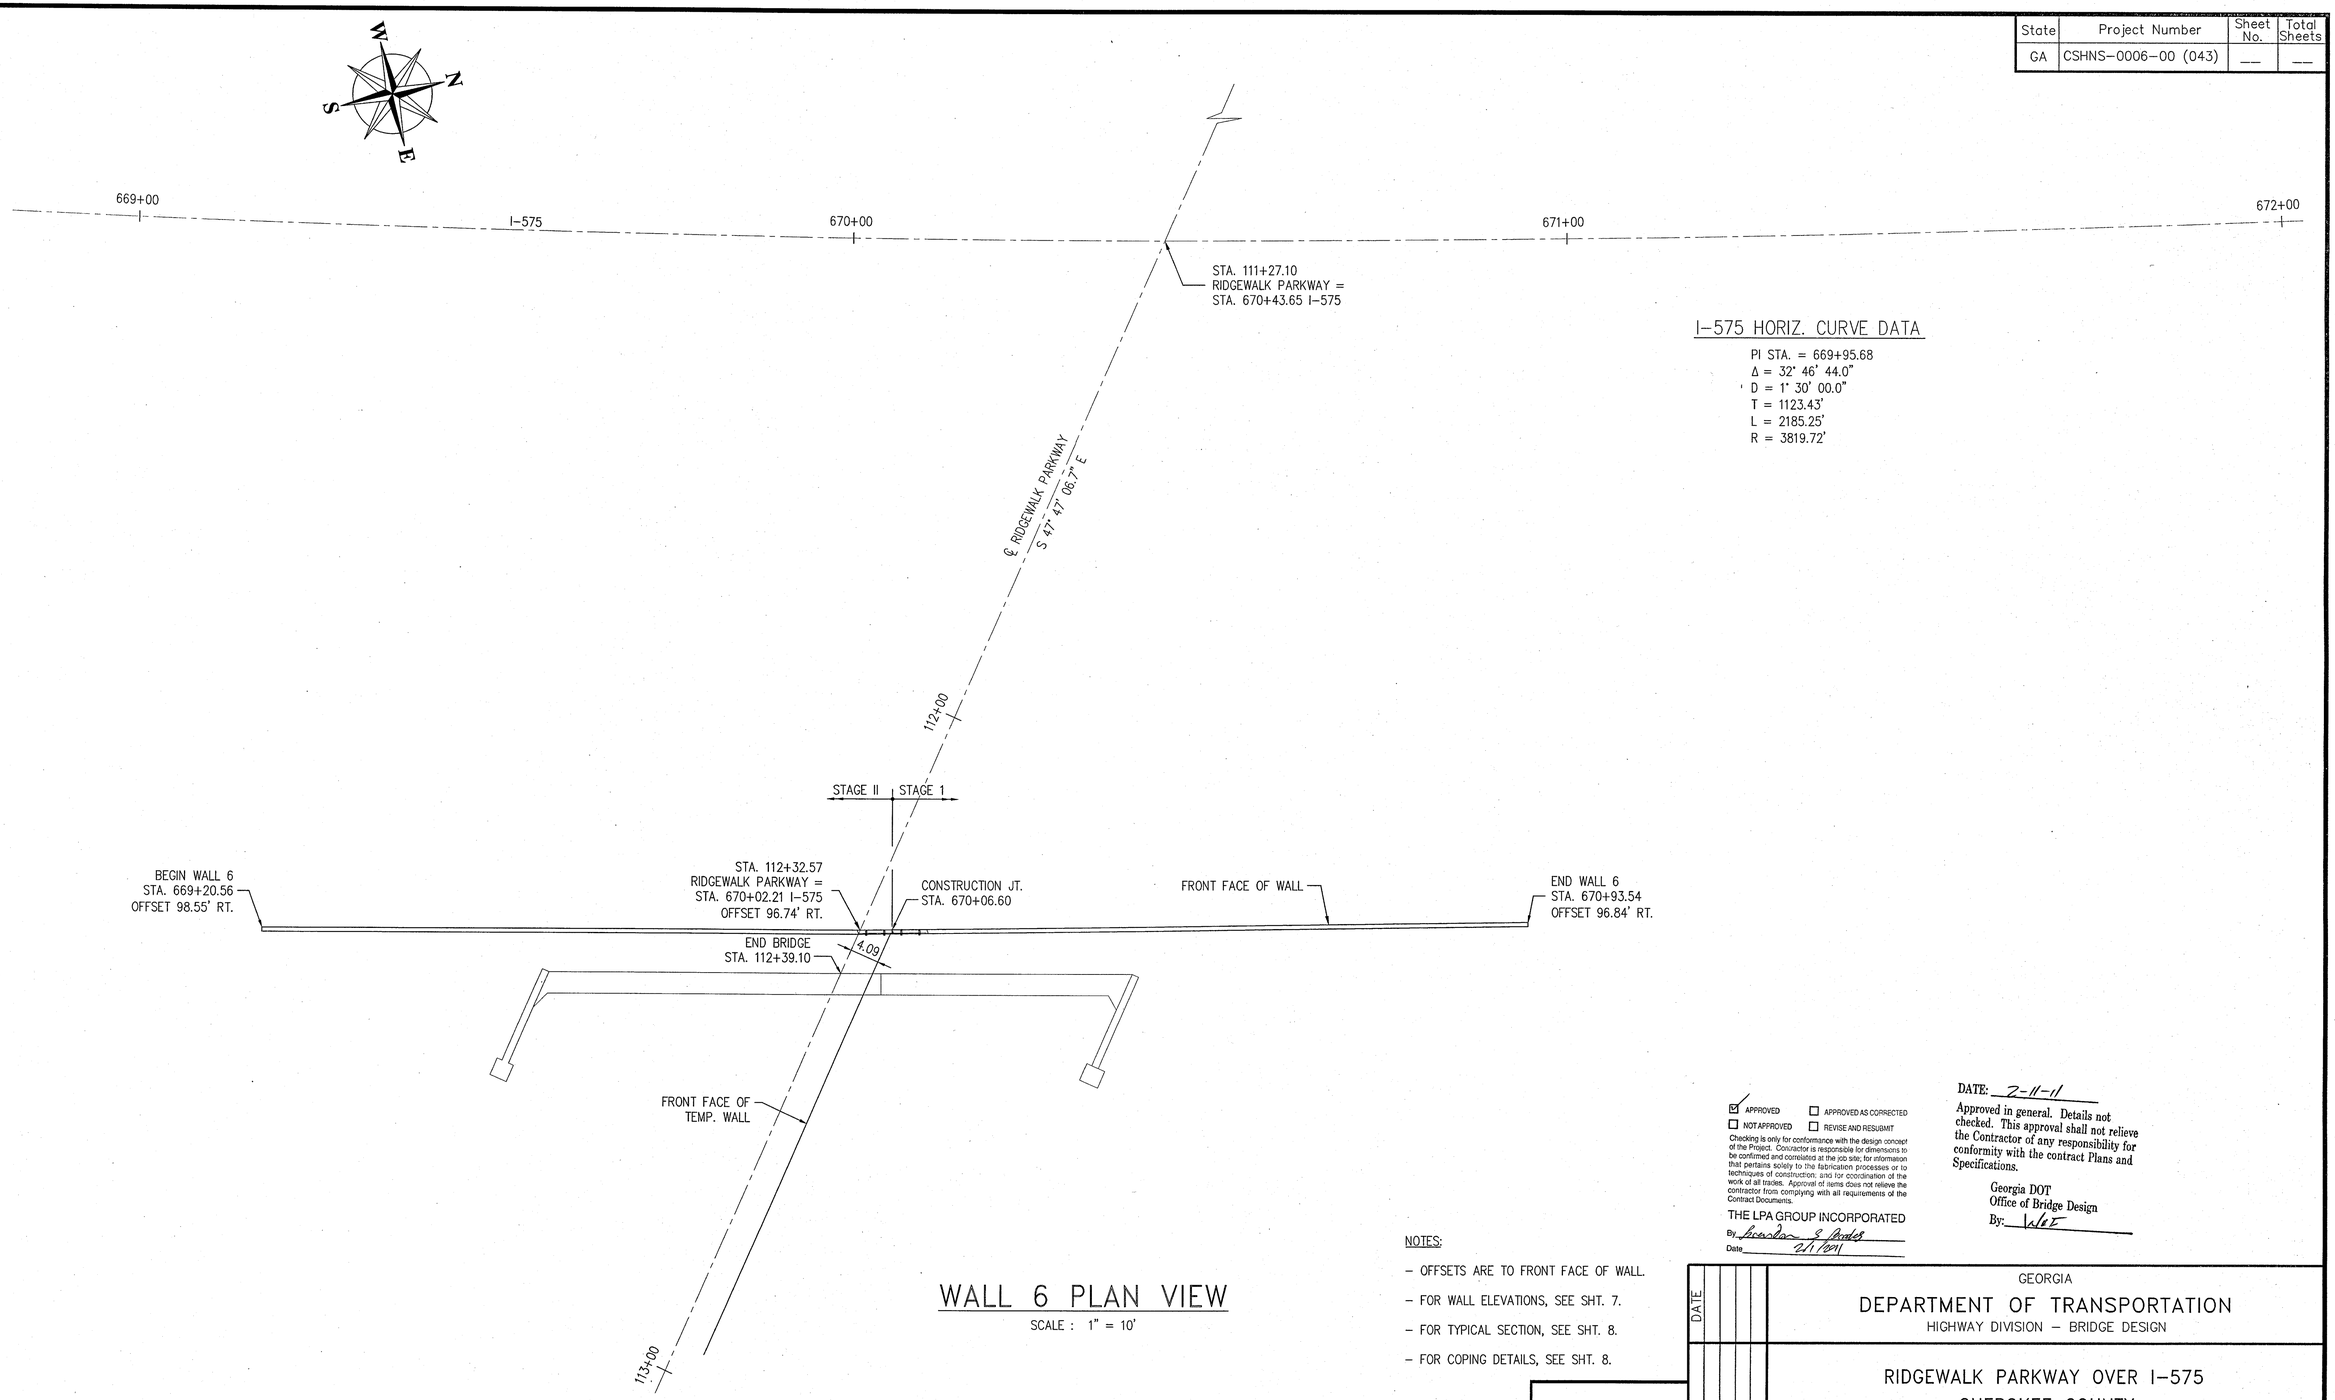

I-575 HORIZ. CURVE DATA

PI STA. = 669+95.68
Δ = 32° 46' 44.0"
D = 1° 30' 00.0"
T = 1123.43'
L = 2185.25'
R = 3819.72'

WALL 6 PLAN VIEW

SCALE : 1" = 10'

NOTES:

- OFFSETS ARE TO FRONT FACE OF WALL.
- FOR WALL ELEVATIONS, SEE SHT. 7.
- FOR TYPICAL SECTION, SEE SHT. 8.
- FOR COPING DETAILS, SEE SHT. 8.

☑ APPROVED ☐ APPROVED AS CORRECTED
☐ NOT APPROVED ☐ REVISE AND RESUBMIT

Checking is only for conformance with the design concept of the Project. Contractor is responsible for dimensions to be confirmed and correlated at the job site; for information that pertains solelly to the fabrication processes or to techniques of construction; and for coordination of the work of all trades. Approval of items does not relieve the contractor from complying with all requirements of the Contract Documents.

THE LPA GROUP INCORPORATED
By: Brandon E. Brooks
Date: 2/1/2011

DATE: 2-11-11
Approved in general. Details not checked. This approval shall not relieve the Contractor of any responsibility for conformity with the contract Plans and Specifications.

Georgia DOT
Office of Bridge Design
By: WET

This drawing contains information proprietary to The Reinforced Earth Company, and is being furnished for the use of THE GEORGIA DEPT. OF TRANSPORTATION only in connection with this project, and the information contained is not to be transmitted to any other organization unless specifically authorized in writing by The Reinforced Earth Company. The Reinforced Earth Company is exclusive licensee in the United States under patents issued to Henri Vidal, and the furnishing of this drawing does not constitute an expressed or implied license under the Vidal patents.

FINAL FOR REVIEW
JAN. 20, 2011

PROJECT STATUS

REINFORCED EARTH®
25 Technology Parkway South, Suite 100, Norcross, GA 30092, (770) 242-9415

"REINFORCED EARTH" is the registered trademark of The Reinforced Earth Company.

GEORGIA REGISTERED No. 10711 PROFESSIONAL ENGINEER FRANK W. FORDHAM

WALL SHEET
OF

REVISIONS	BY	DATE

GEORGIA
DEPARTMENT OF TRANSPORTATION
HIGHWAY DIVISION – BRIDGE DESIGN

RIDGEWALK PARKWAY OVER I-575
CHEROKEE COUNTY

REINFORCED EARTH RETAINING WALL

WALL 6 PLAN VIEW

DESIGNED VG
DRAWN LOP
TRACED
CHECKED FWF
REVIEWED
APPROVED

Z:\GEORGIA\14479 – Ridgewalk Pkwy Over I-575 – SQR – E\14479, 06 – Wall 6 Plan.dwg