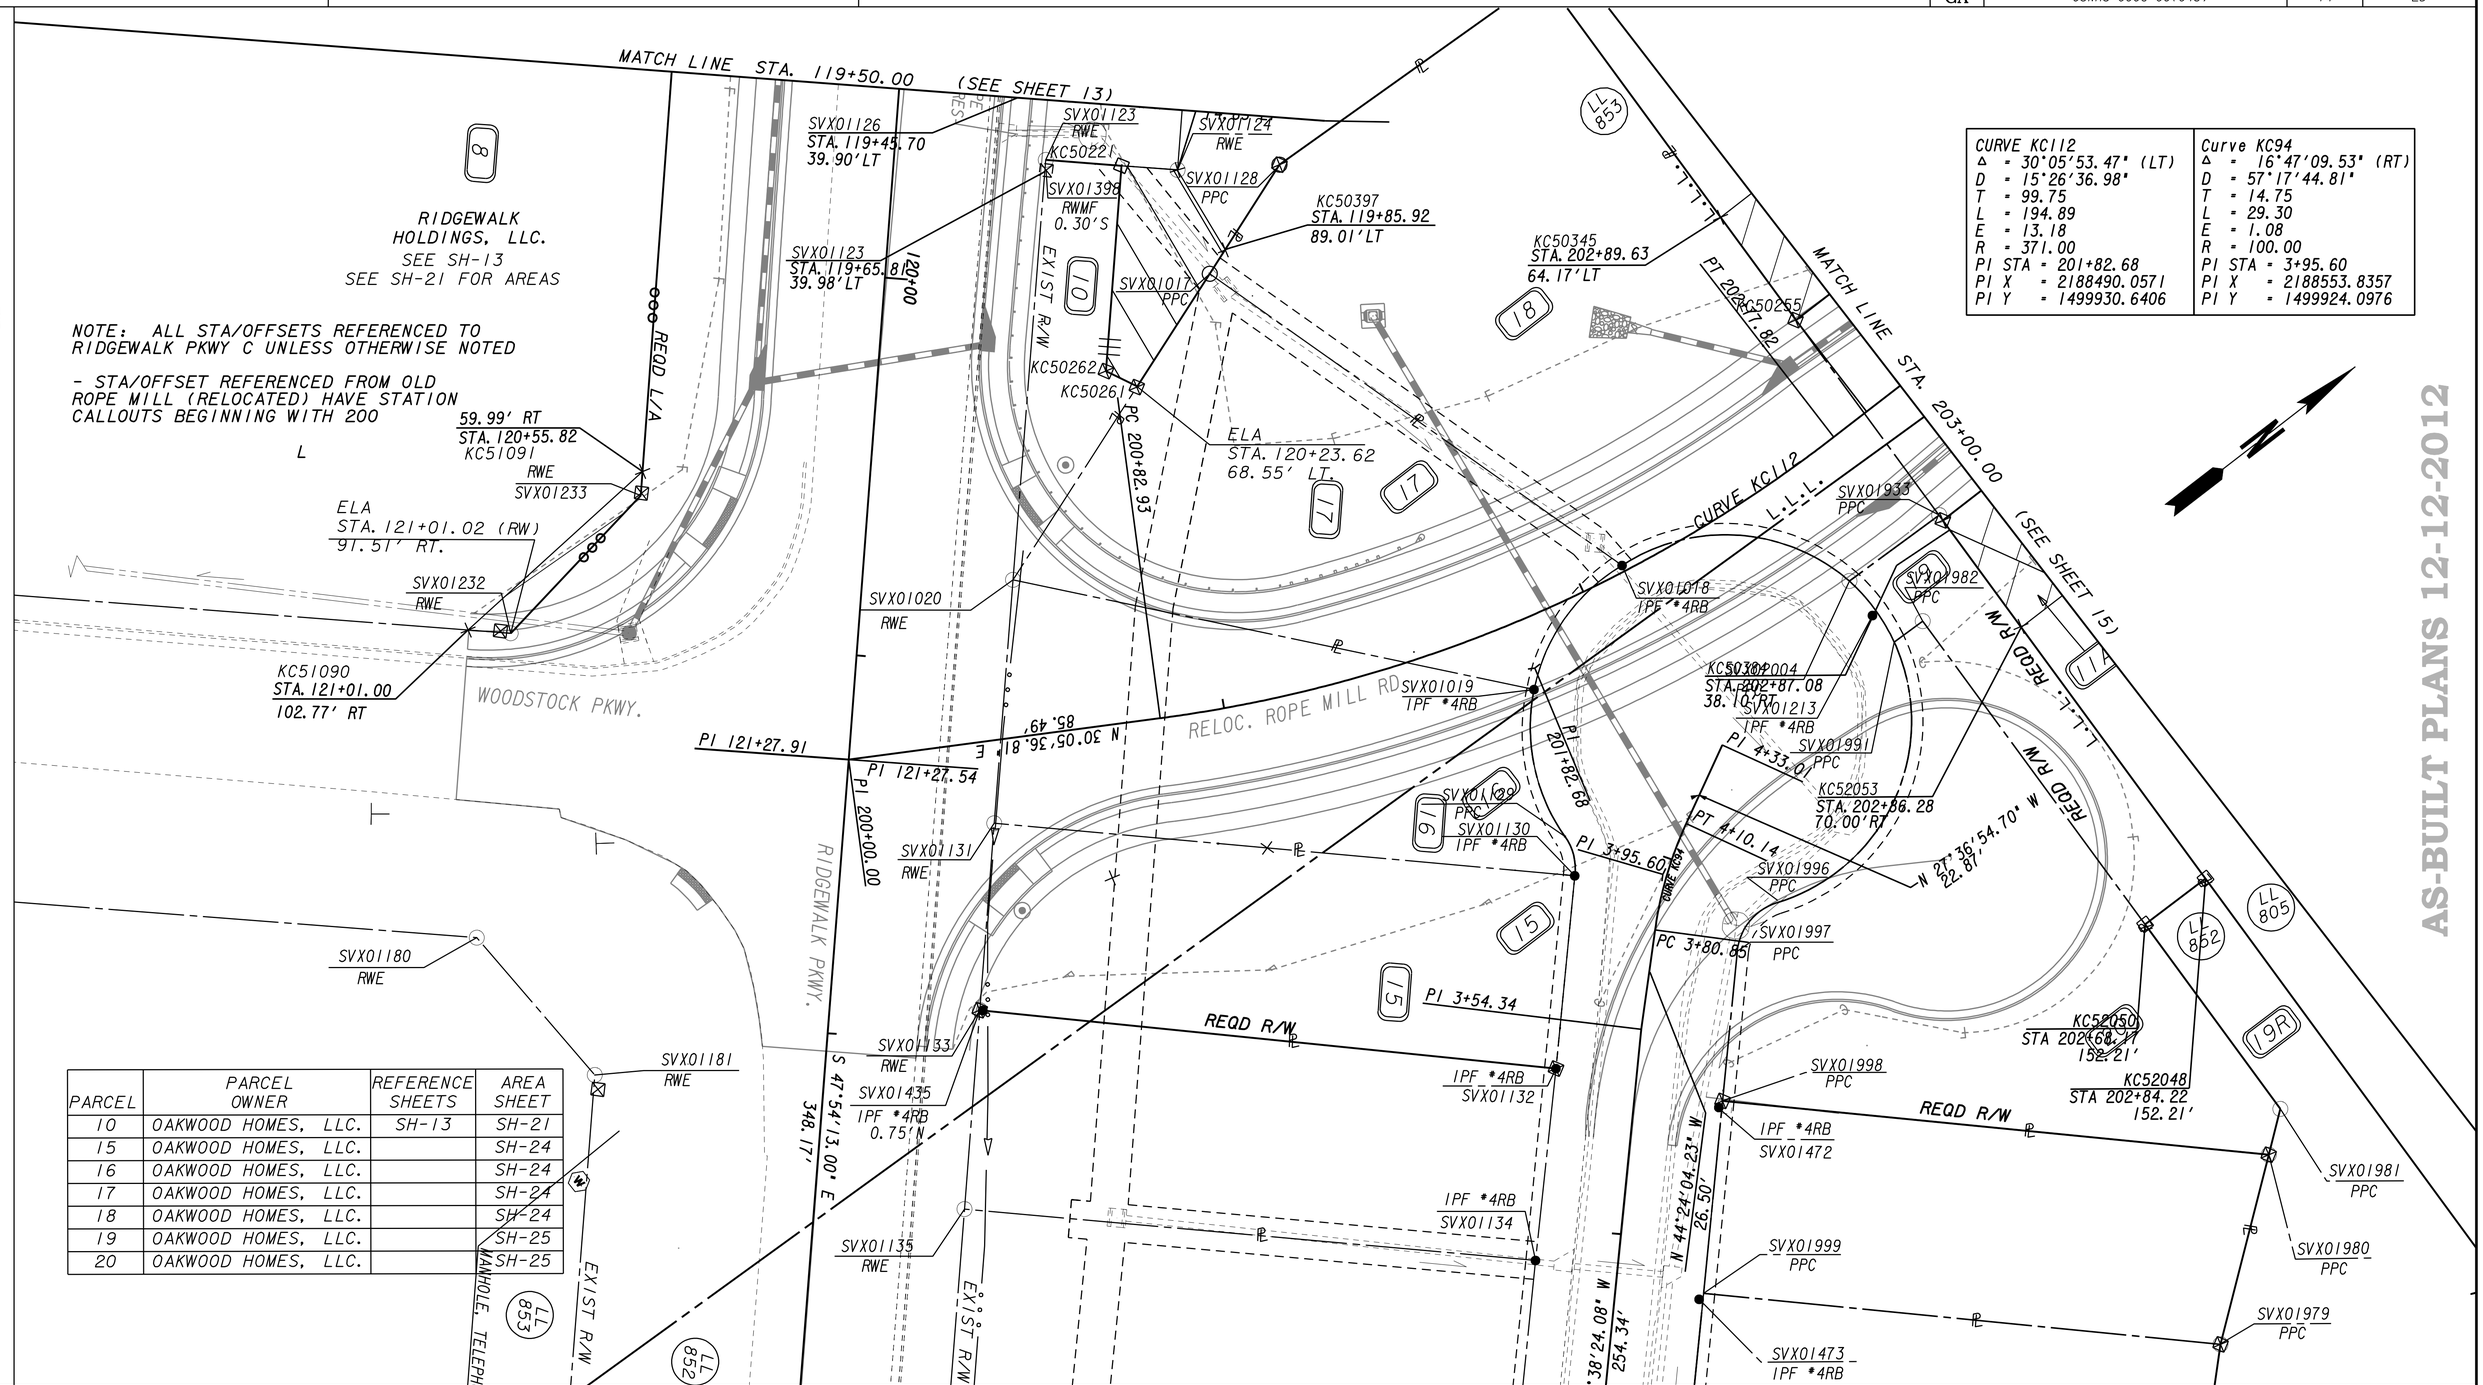

CURVE KC112	Curve KC94
Δ = 30°05'53.47" (LT)	Δ = 16°47'09.53" (RT)
D = 15°26'36.98"	D = 57°17'44.81"
T = 99.75	T = 14.75
L = 194.89	L = 29.30
E = 13.18	E = 1.08
R = 371.00	R = 100.00
PI STA = 201+82.68	PI STA = 3+95.60
PI X = 2188490.0571	PI X = 2188553.8357
PI Y = 1499930.6406	PI Y = 1499924.0976

PARCEL	PARCEL OWNER	REFERENCE SHEETS	AREA SHEET
10	OAKWOOD HOMES, LLC.	SH-13	SH-21
15	OAKWOOD HOMES, LLC.		SH-24
16	OAKWOOD HOMES, LLC.		SH-24
17	OAKWOOD HOMES, LLC.		SH-24
18	OAKWOOD HOMES, LLC.		SH-24
19	OAKWOOD HOMES, LLC.		SH-25
20	OAKWOOD HOMES, LLC.		SH-25

AS-BUILT PLANS 12-12-2012

PROPERTY AND EXISTING R/W LINE
REQUIRED R/W LINE
CONSTRUCTION LIMITS
EASEMENT FOR CONSTR & MAINTENANCE OF SLOPES
EASEMENT FOR CONSTR OF SLOPES
EASEMENT FOR CONSTR OF DRIVES

BEGIN LIMIT OF ACCESS.....BLA
END LIMIT OF ACCESS.....ELA
LIMIT OF ACCESS
REQ'D R/W & LIMIT OF ACCESS

SCALE IN FEET
0 20 40 80

THE LPA GROUP TRANSPORTATION CONSULTANTS
3595 ENGINEERING DRIVE
NORCROSS, GEORGIA 30092
(770) 263-9118

DATE	REVISIONS	DATE	REVISIONS

STATE OF GEORGIA
DEPARTMENT OF TRANSPORTATION

RIGHT OF WAY MAP

PROJECT NO: CSNHS-0006-00(043
COUNTY: CHEROKEE
LAND LOT NO: 852, 853
LAND DISTRICT: 15
GMD 890
DATE 09-30-08 SH 14 OF 25