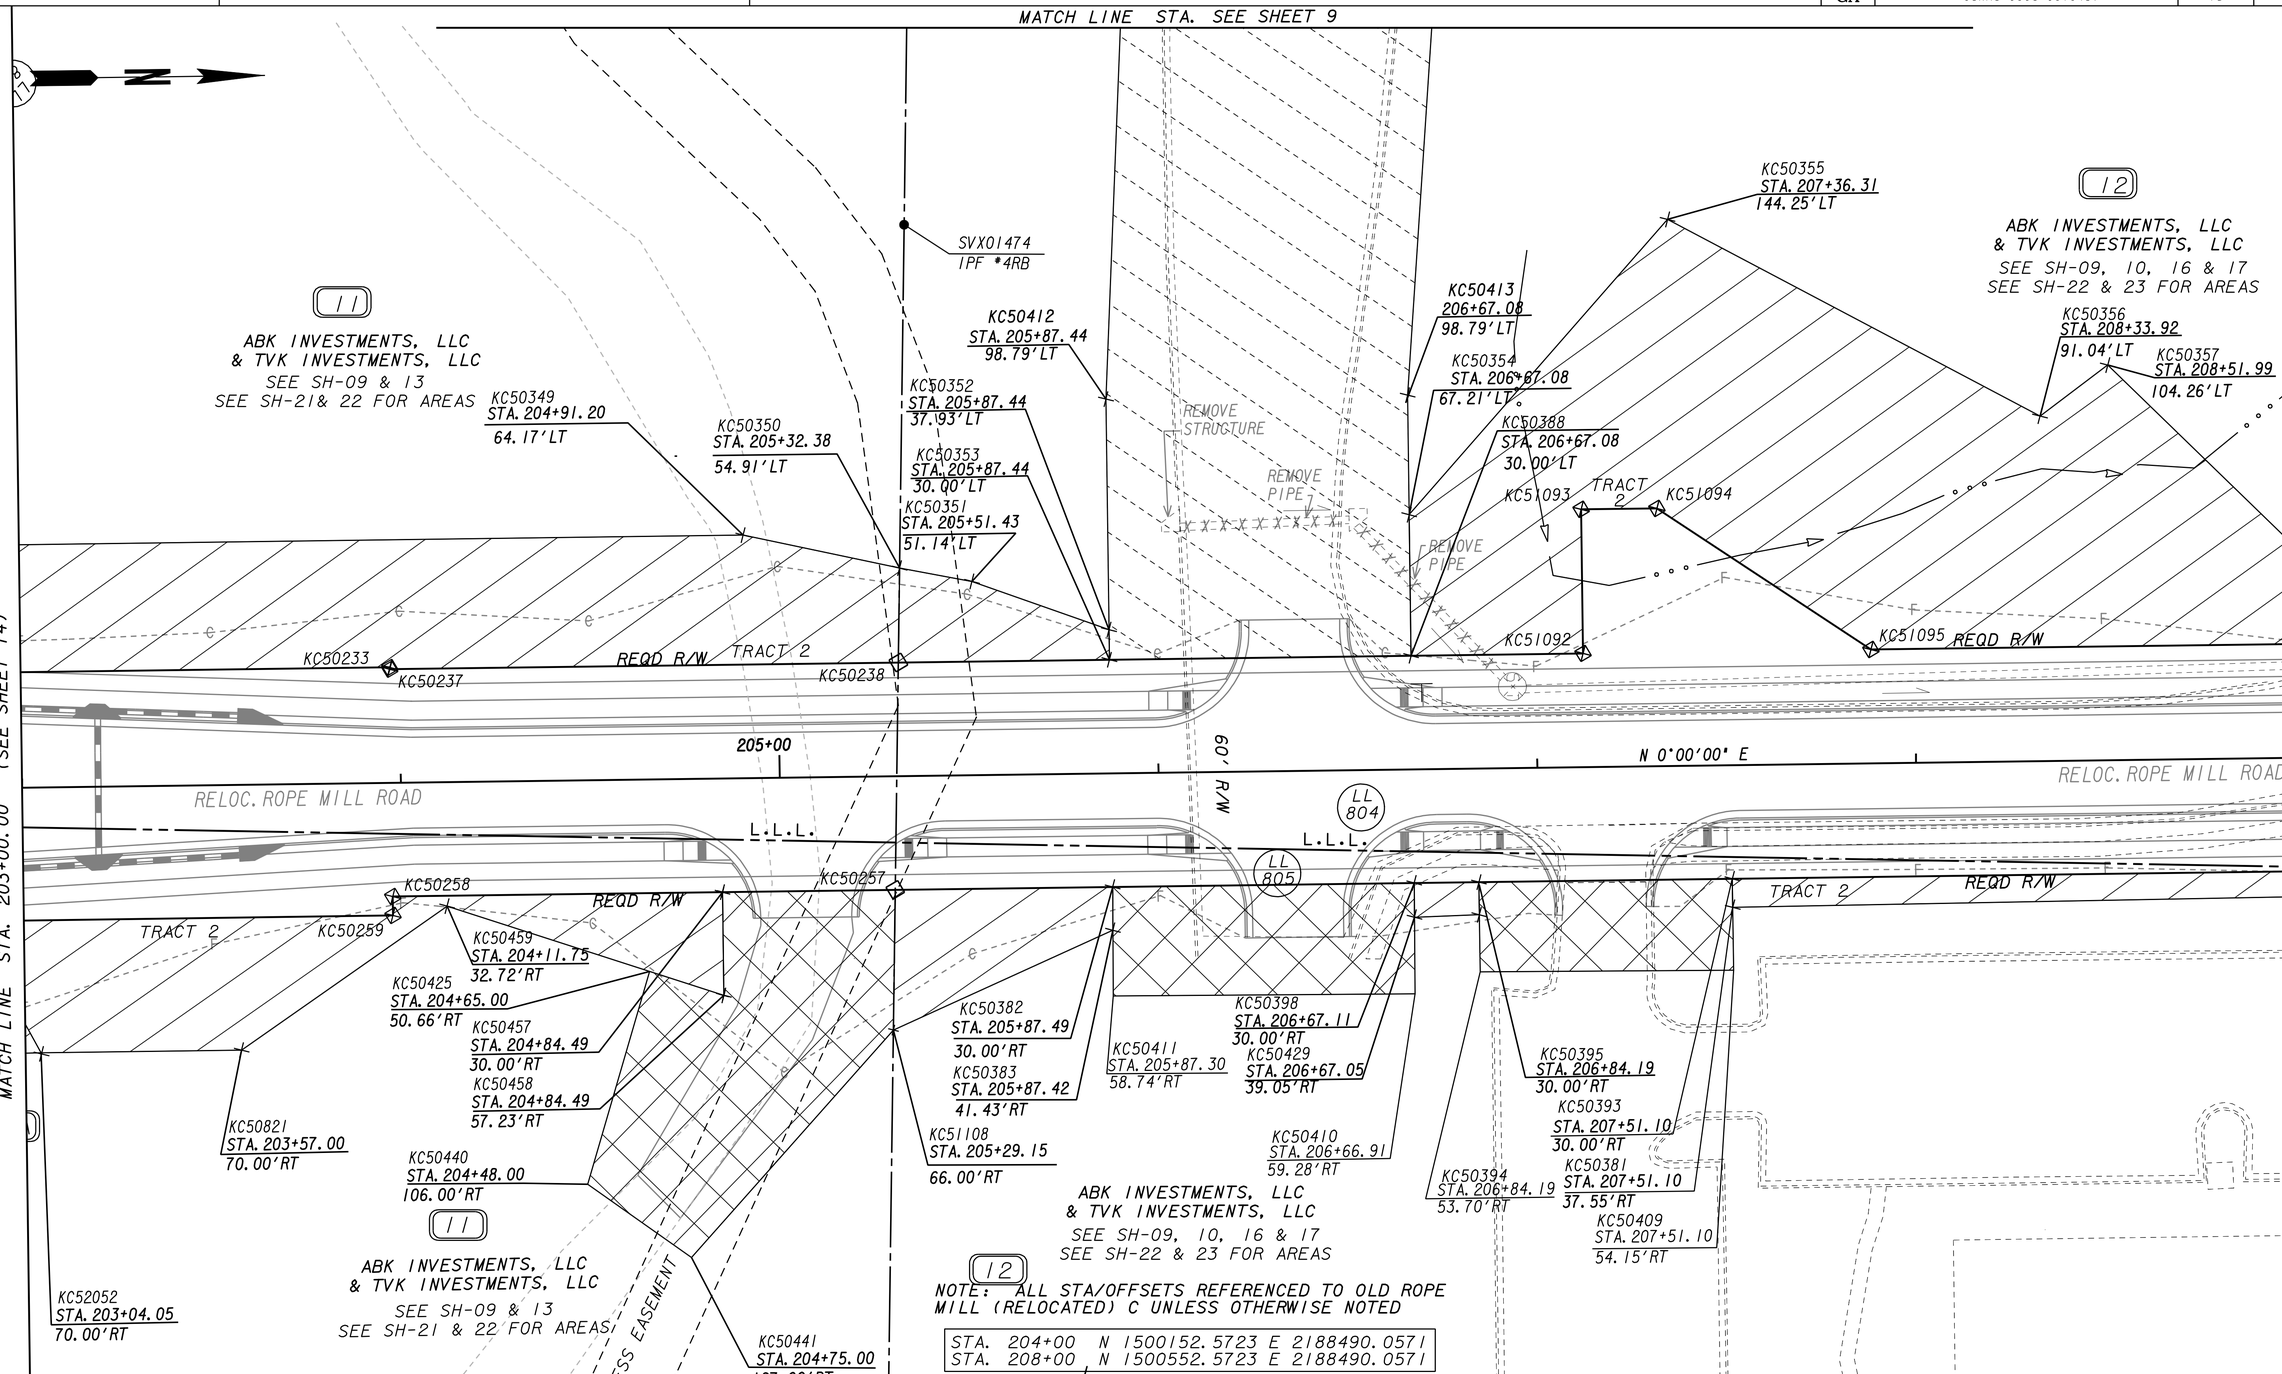

NOTE: ALL STA/OFFSETS REFERENCED TO OLD ROPE MILL (RELOCATED) C UNLESS OTHERWISE NOTED

STA. 204+00	N 1500152.5723 E 2188490.0571
STA. 208+00	N 1500552.5723 E 2188490.0571

AS-BUILT PLANS 12-12-2012

PROPERTY AND EXISTING R/W LINE
REQUIRED R/W LINE
CONSTRUCTION LIMITS
EASEMENT FOR CONSTR & MAINTENANCE OF SLOPES
EASEMENT FOR CONSTR OF SLOPES
EASEMENT FOR CONSTR OF DRIVES

BEGIN LIMIT OF ACCESS.....BLA
END LIMIT OF ACCESS.....ELA
LIMIT OF ACCESS
REQ'D R/W & LIMIT OF ACCESS

SCALE IN FEET
0 20 40 80

THE LPA GROUP
TRANSPORTATION CONSULTANTS
3595 ENGINEERING DRIVE
NORCROSS, GEORGIA 30092
(770) 263-9118

DATE	REVISIONS	DATE	REVISIONS
6-15-09	PAR 11 & 12 REVISED		
7-27-09	MODIFIED SHEET LAYOUT		
01-04-10	PAR 11 & 12 REVISED		

STATE OF GEORGIA
DEPARTMENT OF TRANSPORTATION

RIGHT OF WAY MAP

PROJECT NO: CSNHS-0006-00(043
COUNTY: CHEROKEE
LAND LOT NO: 804, 805
LAND DISTRICT: 15
GMD 890
DATE 09-30-08 SH 15 OF 25