STATE	PROJECT NUMBER	SHEET NO.	TOTAL SHEETS
GA	CSNHS-0006-00(043)	16	25

AS-BUILT PLANS 12-12-2012

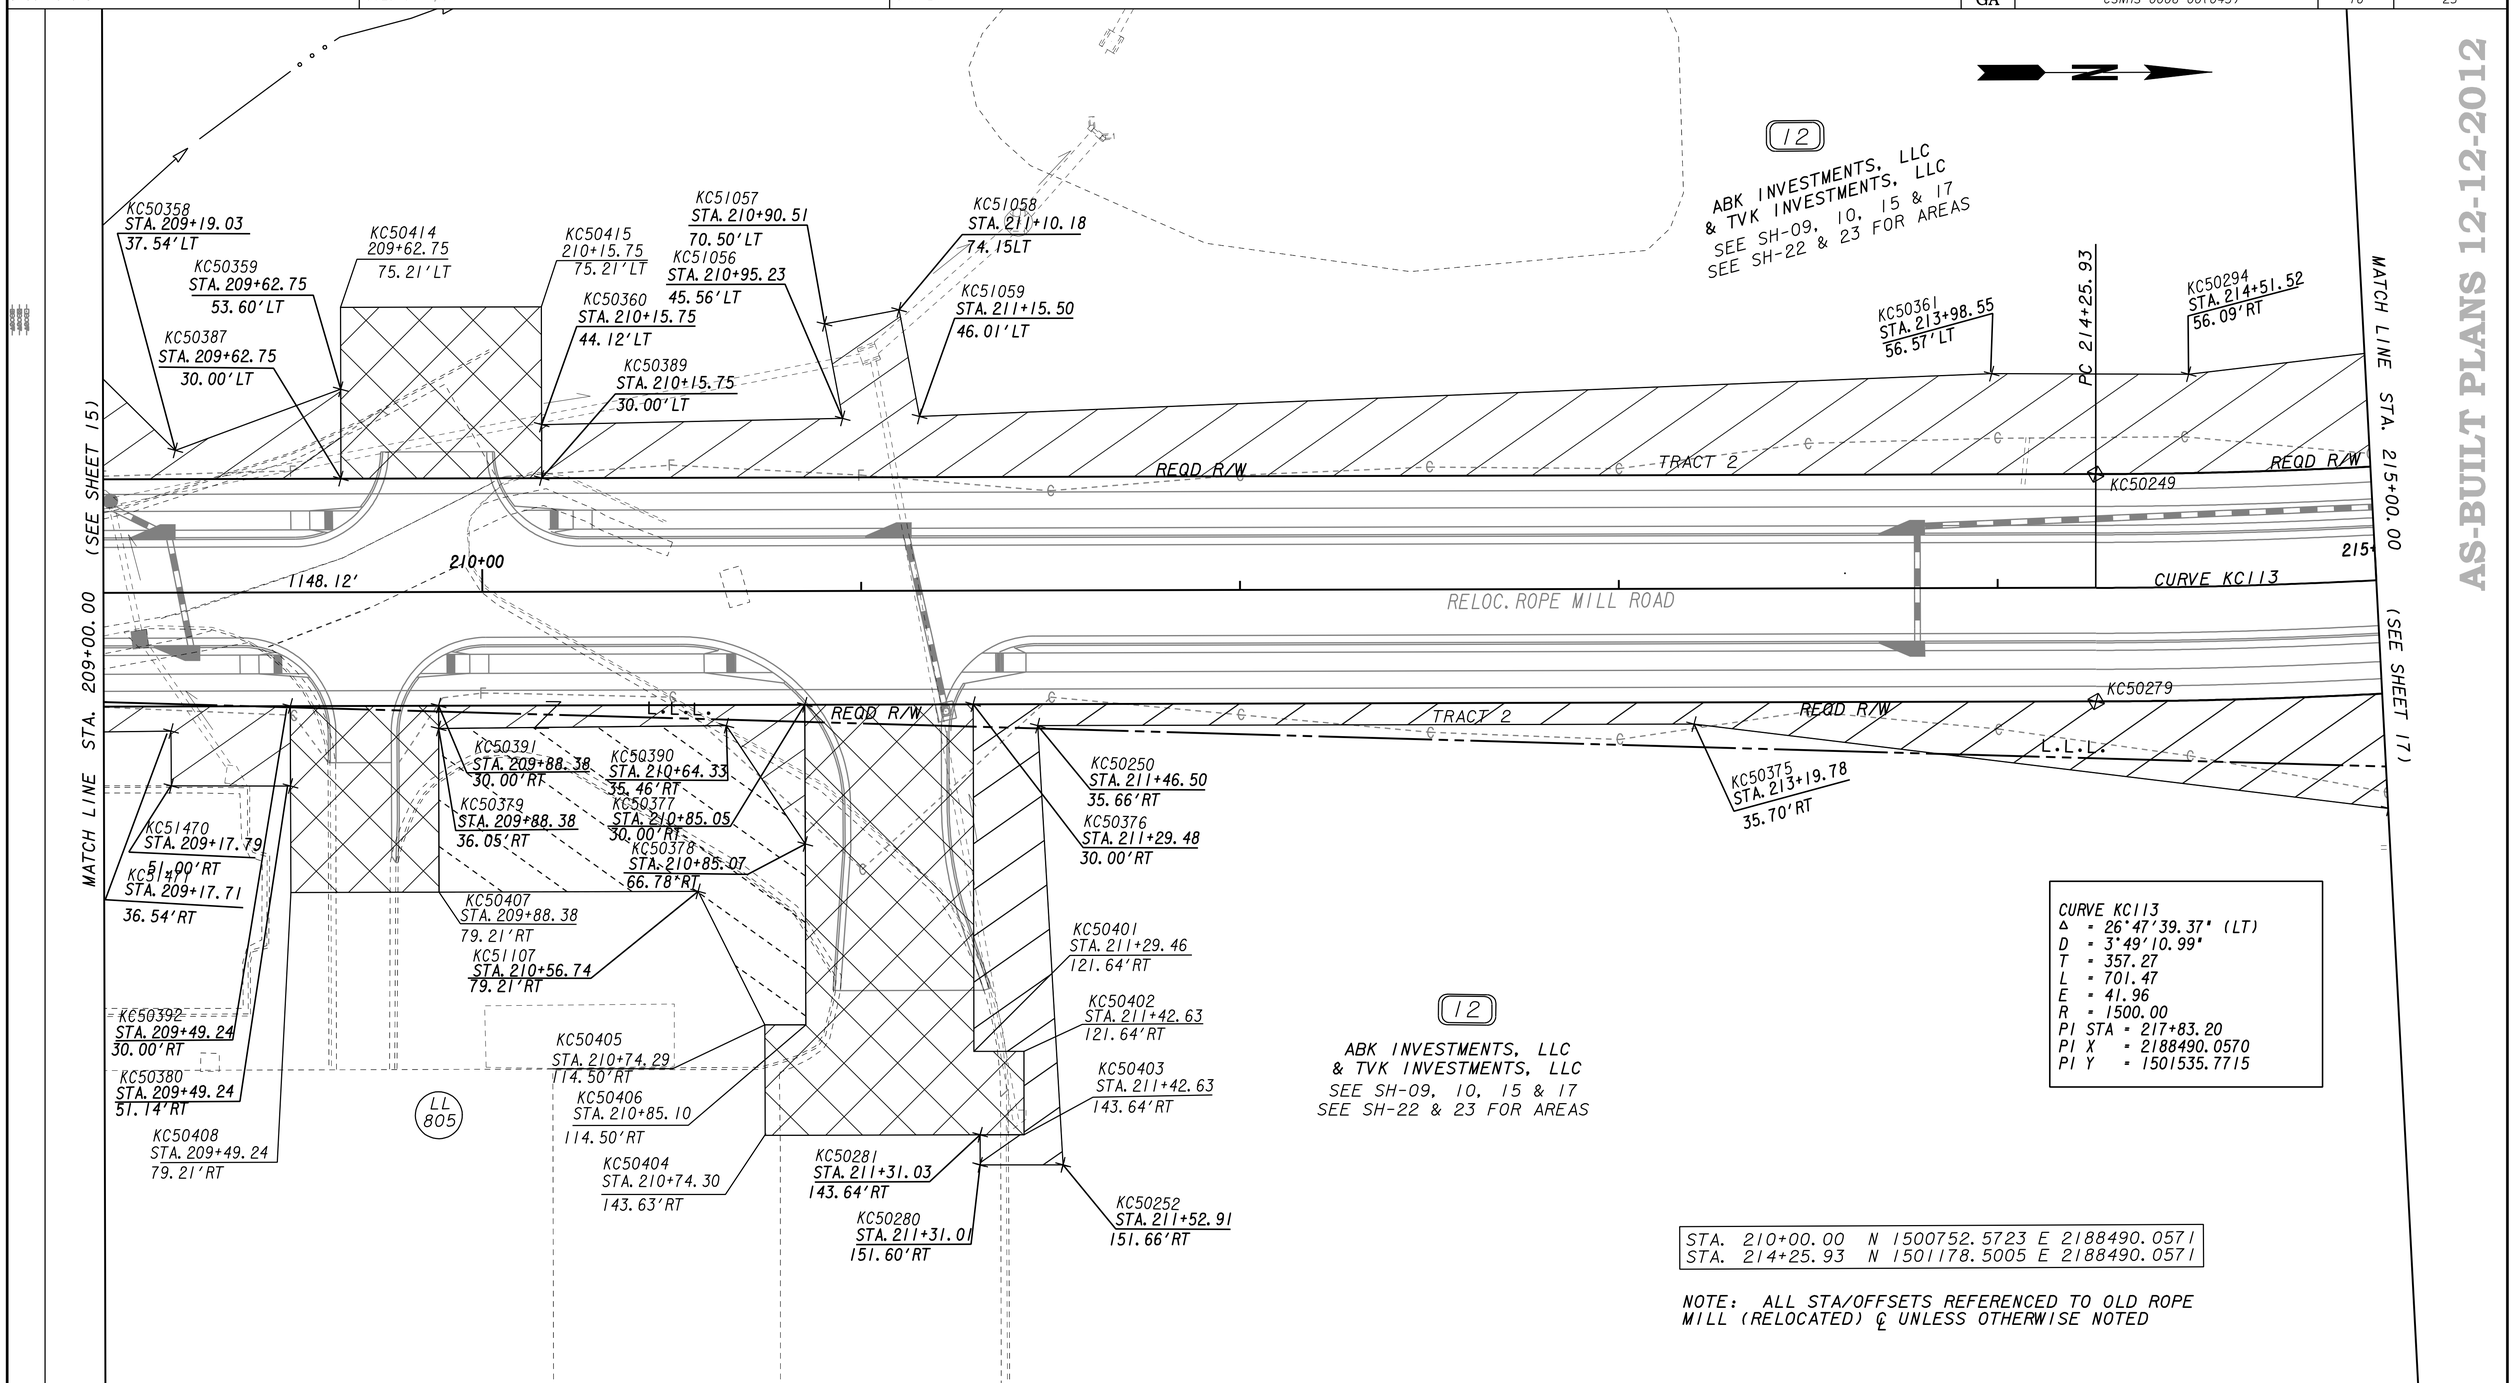

CURVE KC113
Δ = 26°47'39.37" (LT)
D = 3°49'10.99"
T = 357.27
L = 701.47
E = 41.96
R = 1500.00
PI STA = 217+83.20
PI X = 2188490.0570
PI Y = 1501535.7715

STA. 210+00.00	N 1500752.5723	E 2188490.0571
STA. 214+25.93	N 1501178.5005	E 2188490.0571

NOTE: ALL STA/OFFSETS REFERENCED TO OLD ROPE MILL (RELOCATED) ℄ UNLESS OTHERWISE NOTED

PROPERTY AND EXISTING R/W LINE
REQUIRED R/W LINE
CONSTRUCTION LIMITS
EASEMENT FOR CONSTR & MAINTENANCE OF SLOPES
EASEMENT FOR CONSTR OF SLOPES
EASEMENT FOR CONSTR OF DRIVES

BEGIN LIMIT OF ACCESS.....BLA
END LIMIT OF ACCESS.....ELA
LIMIT OF ACCESS
REQ'D R/W & LIMIT OF ACCESS

SCALE IN FEET
0 20 40 80

THE LPA GROUP
TRANSPORTATION CONSULTANTS
3595 ENGINEERING DRIVE
NORCROSS, GEORGIA 30092
(770) 263-9118

DATE	REVISIONS	DATE	REVISIONS
7-27-09	PAR 12 REVISED		

STATE OF GEORGIA
DEPARTMENT OF TRANSPORTATION

RIGHT OF WAY MAP

PROJECT NO: CSNHS-0006-00(043
COUNTY: CHEROKEE
LAND LOT NO: 804, 805
LAND DISTRICT: 15
GMD 890
DATE 09-30-08 SH 16 OF 25