STATE	PROJECT NUMBER	SHEET NO.	TOTAL SHEETS
GA.	CSBRG 00006-00 (432)		

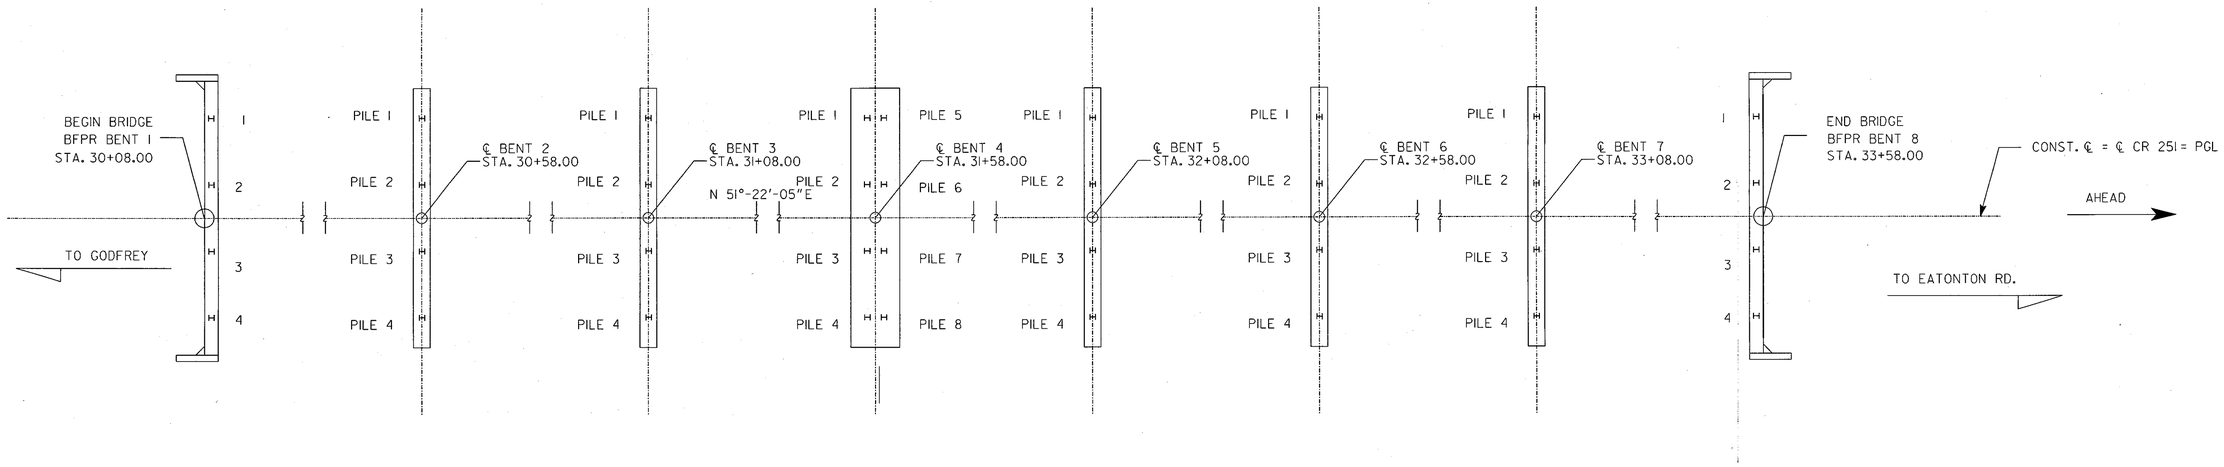

PLAN

AS-BUILT FOUNDATION INFORMATION		
END BENT	PILE LOCATION	PILE TIP ELEVATION
1	PILE 1	425.947
	PILE 2	425.684
	PILE 3	425.910
	PILE 4	425.887

AS-BUILT FOUNDATION INFORMATION		
BENT	FOOTING LOCATION	PILE TIP ELEVATION
2	PILE 1	420.767
	PILE 2	418.426
	PILE 3	423.473
	PILE 4	411.457

AS-BUILT FOUNDATION INFORMATION		
BENT	FOOTING LOCATION	PILE TIP ELEVATION
3	PILE 1	431.834
	PILE 2	424.660
	PILE 3	423.634
	PILE 4	413.150

AS-BUILT FOUNDATION INFORMATION		
BENT	FOOTING LOCATION	PILE TIP ELEVATION
4	PILE 1	429.363
	PILE 2	429.390
	PILE 3	429.183
	PILE 4	419.383
	PILE 5	428.707
	PILE 6	429.807
	PILE 7	427.673
	PILE 8	419.363

AS-BUILT FOUNDATION INFORMATION		
BENT	FOOTING LOCATION	PILE TIP ELEVATION
5	PILE 1	421.367
	PILE 2	422.357
	PILE 3	423.017
	PILE 4	420.907

AS-BUILT FOUNDATION INFORMATION		
BENT	FOOTING LOCATION	PILE TIP ELEVATION
6	PILE 1	414.377
	PILE 2	422.167
	PILE 3	420.405
	PILE 4	423.124

AS-BUILT FOUNDATION INFORMATION		
BENT	FOOTING LOCATION	PILE TIP ELEVATION
7	PILE 1	416.923
	PILE 2	407.343
	PILE 3	414.523
	PILE 4	415.027

AS-BUILT FOUNDATION INFORMATION		
END BENT	PILE LOCATION	PILE TIP ELEVATION
8	PILE 1	426.093
	PILE 2	427.497
	PILE 3	419.484
	PILE 4	428.353

THIS SHEET IS TO BE FILLED IN BY THE PROJECT ENGINEER AND FORWARDED TO THE BRIDGE DESIGN OFFICE AFTER INSTALLATION OF ALL PILES, FOR POSTING TO THE PLANS AS A PERMANENT RECORD OF THE BRIDGE CONSTRUCTION.

PROJECT ENGINEER DATE

( )
(AREA CODE) TELEPHONE NUMBER

BRIDGE NO. 1

GEORGIA
DEPARTMENT OF TRANSPORTATION
ENGINEERING DIVISION-OFFICE OF BRIDGES AND STRUCTURES

AS-BUILT FOUNDATION INFORMATION

CR 251 OVER BIG INDIAN CREEK

MORGAN COUNTY CSBRG 00006-00 (432)

NO SCALE DECEMBER 2011

DESIGNED DVW CHECKED AS REVIEWED WEI/WMD
DRAWN PS DESIGN GROUP X APPROVED BFR

DATE REVISIONS BY

S&A Atlanta
SASTRY & ASSOCIATES, INC.
11030 JONES BRIDGE ROAD, SUITE 201
ALPHARETTA, GA 30022
PHONE: 678-366-9375 FAX: 770-442-0761

DRAWING NO. 35 - 11
BRIDGE SHEET 11 OF 13

1 INCH WHEN PRINTED FULL SIZE

REVISED OCTOBER 7, 2014 PLOT DATE: 07 OCT 114 PLOT TIME: 16:48:27 S:\KCI-MORGAN COUNTY BRDIGE\11-INDIAN-CRK-ASBUILT.DGN