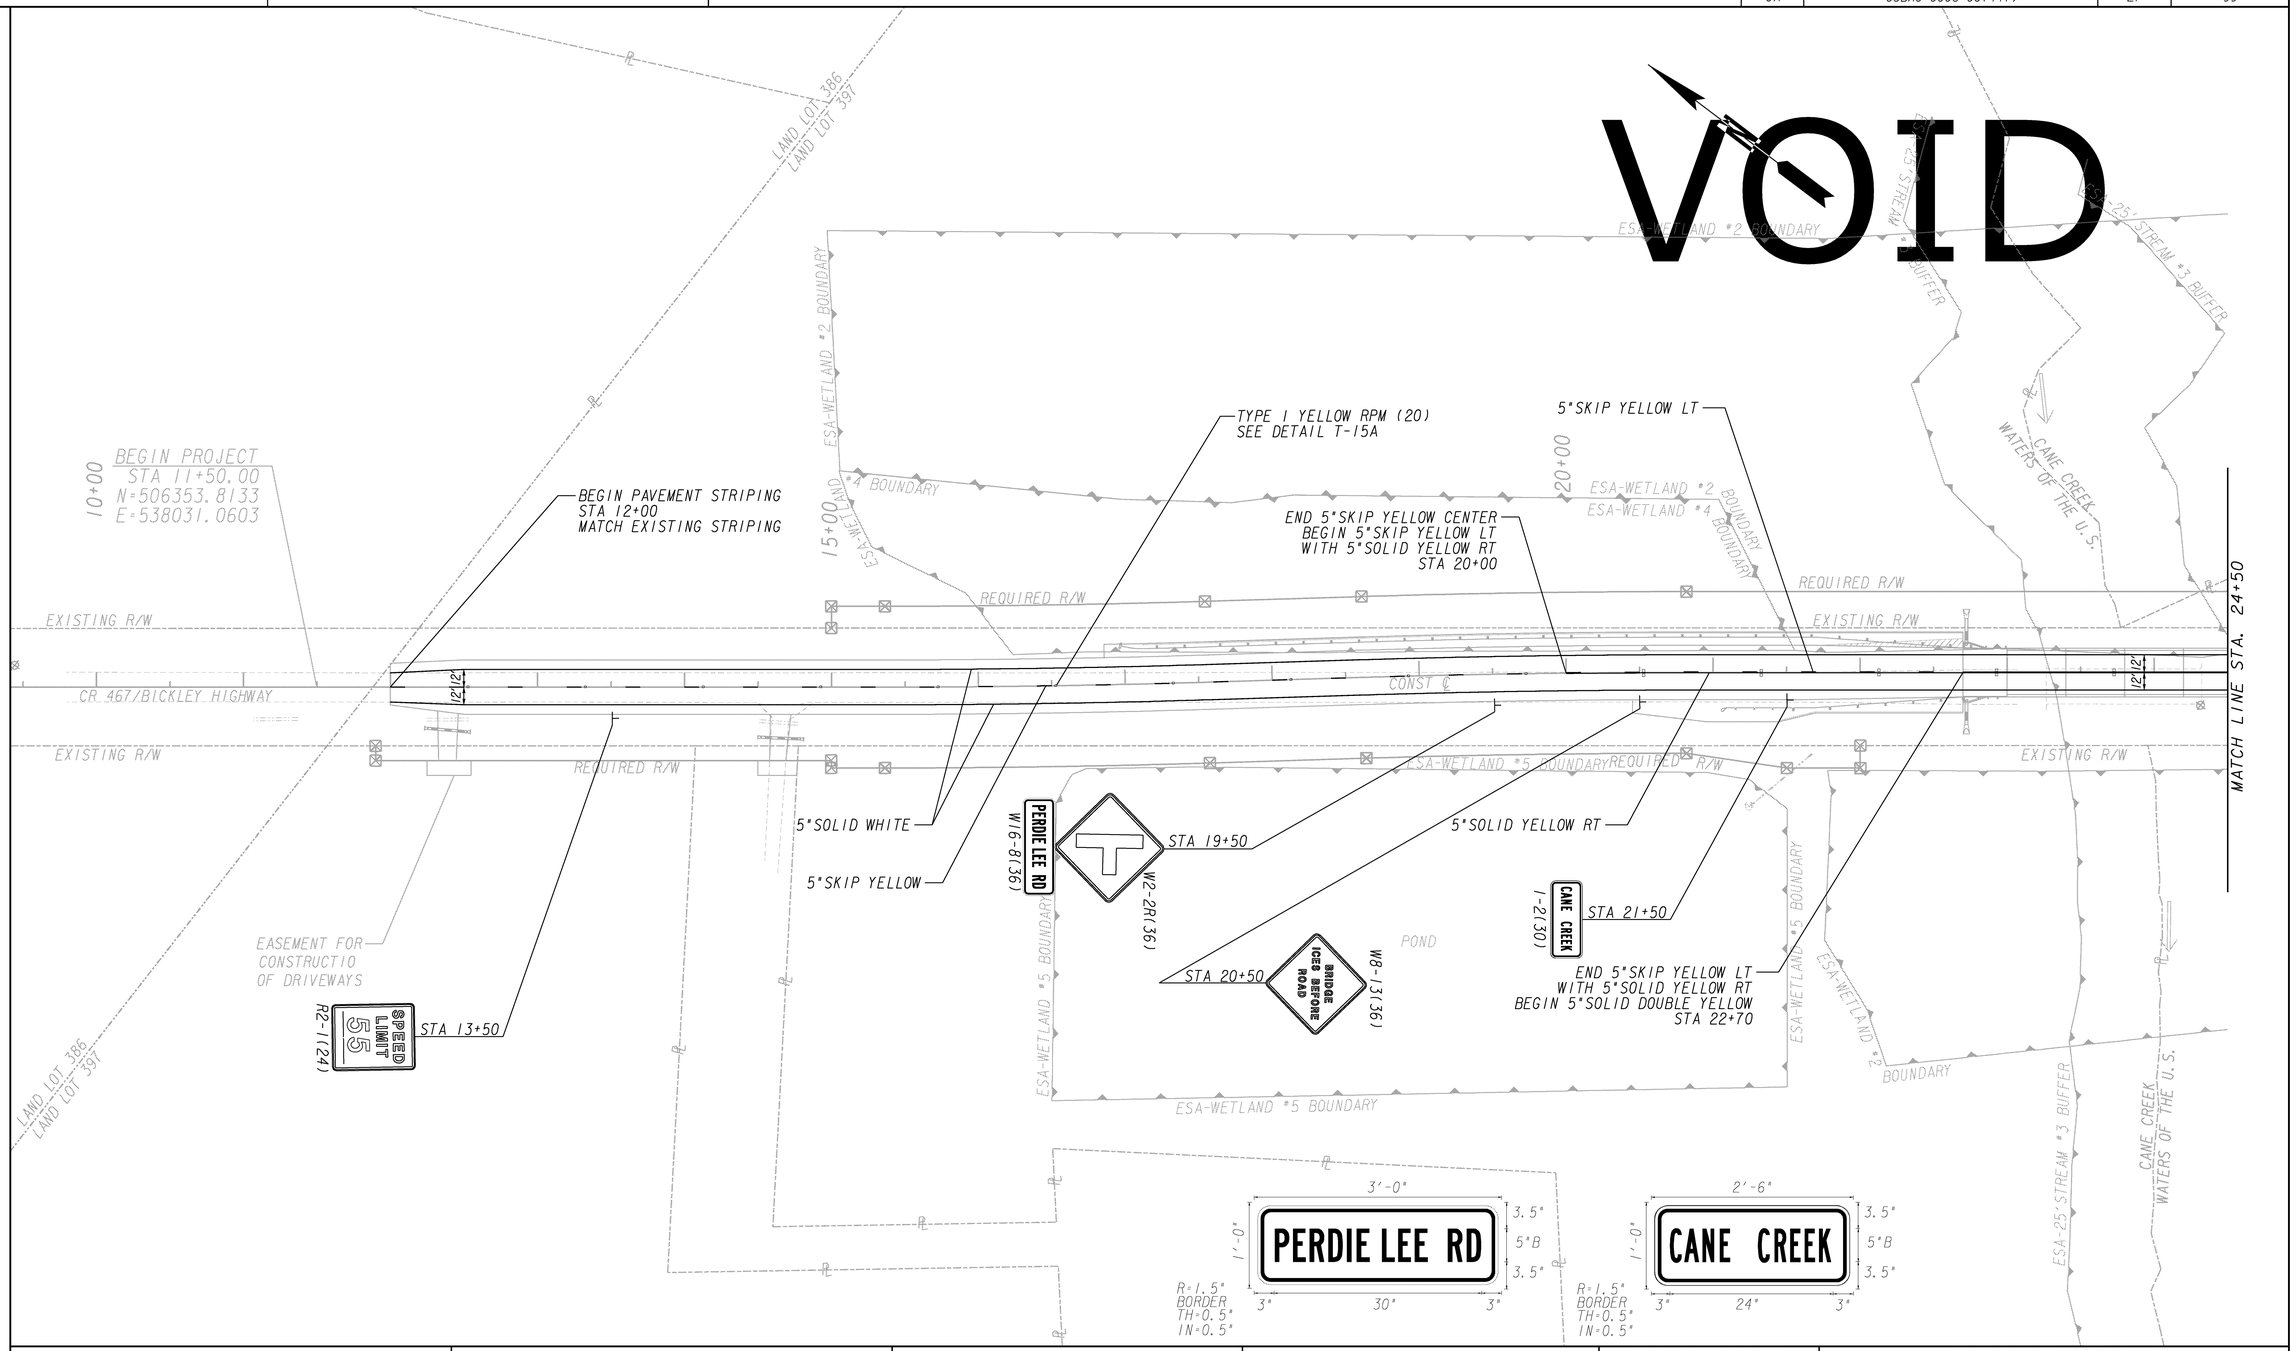

REVISION DATES		

STATE OF GEORGIA
DEPARTMENT OF TRANSPORTATION

OFFICE:

SIGNING AND MARKING PLANS

CR467/BICKLEY HWY AT CANE CREEK BRIDGE REPLACEMENT
CSBRG-0006-00(441) 10/15/2010

DRAWING No.
26-01

SCALE IN FEET
0 50 100 200

GPLN