6/7/2013 Fri Jun 07 10:56:47 2013	\\gdot-dsn1\gocfg\resources\Gdot-2012.tbl	L:\PROJECTS\FULTON COUNTY PROJECTS\0006864\DGN\ourston xsections\KC5080XSECT.DGN	STATE	PROJECT NUMBER	SHEET NO.	TOTAL SHEETS
kcowan			GA	CSSTP-0006-00(864)	111	341

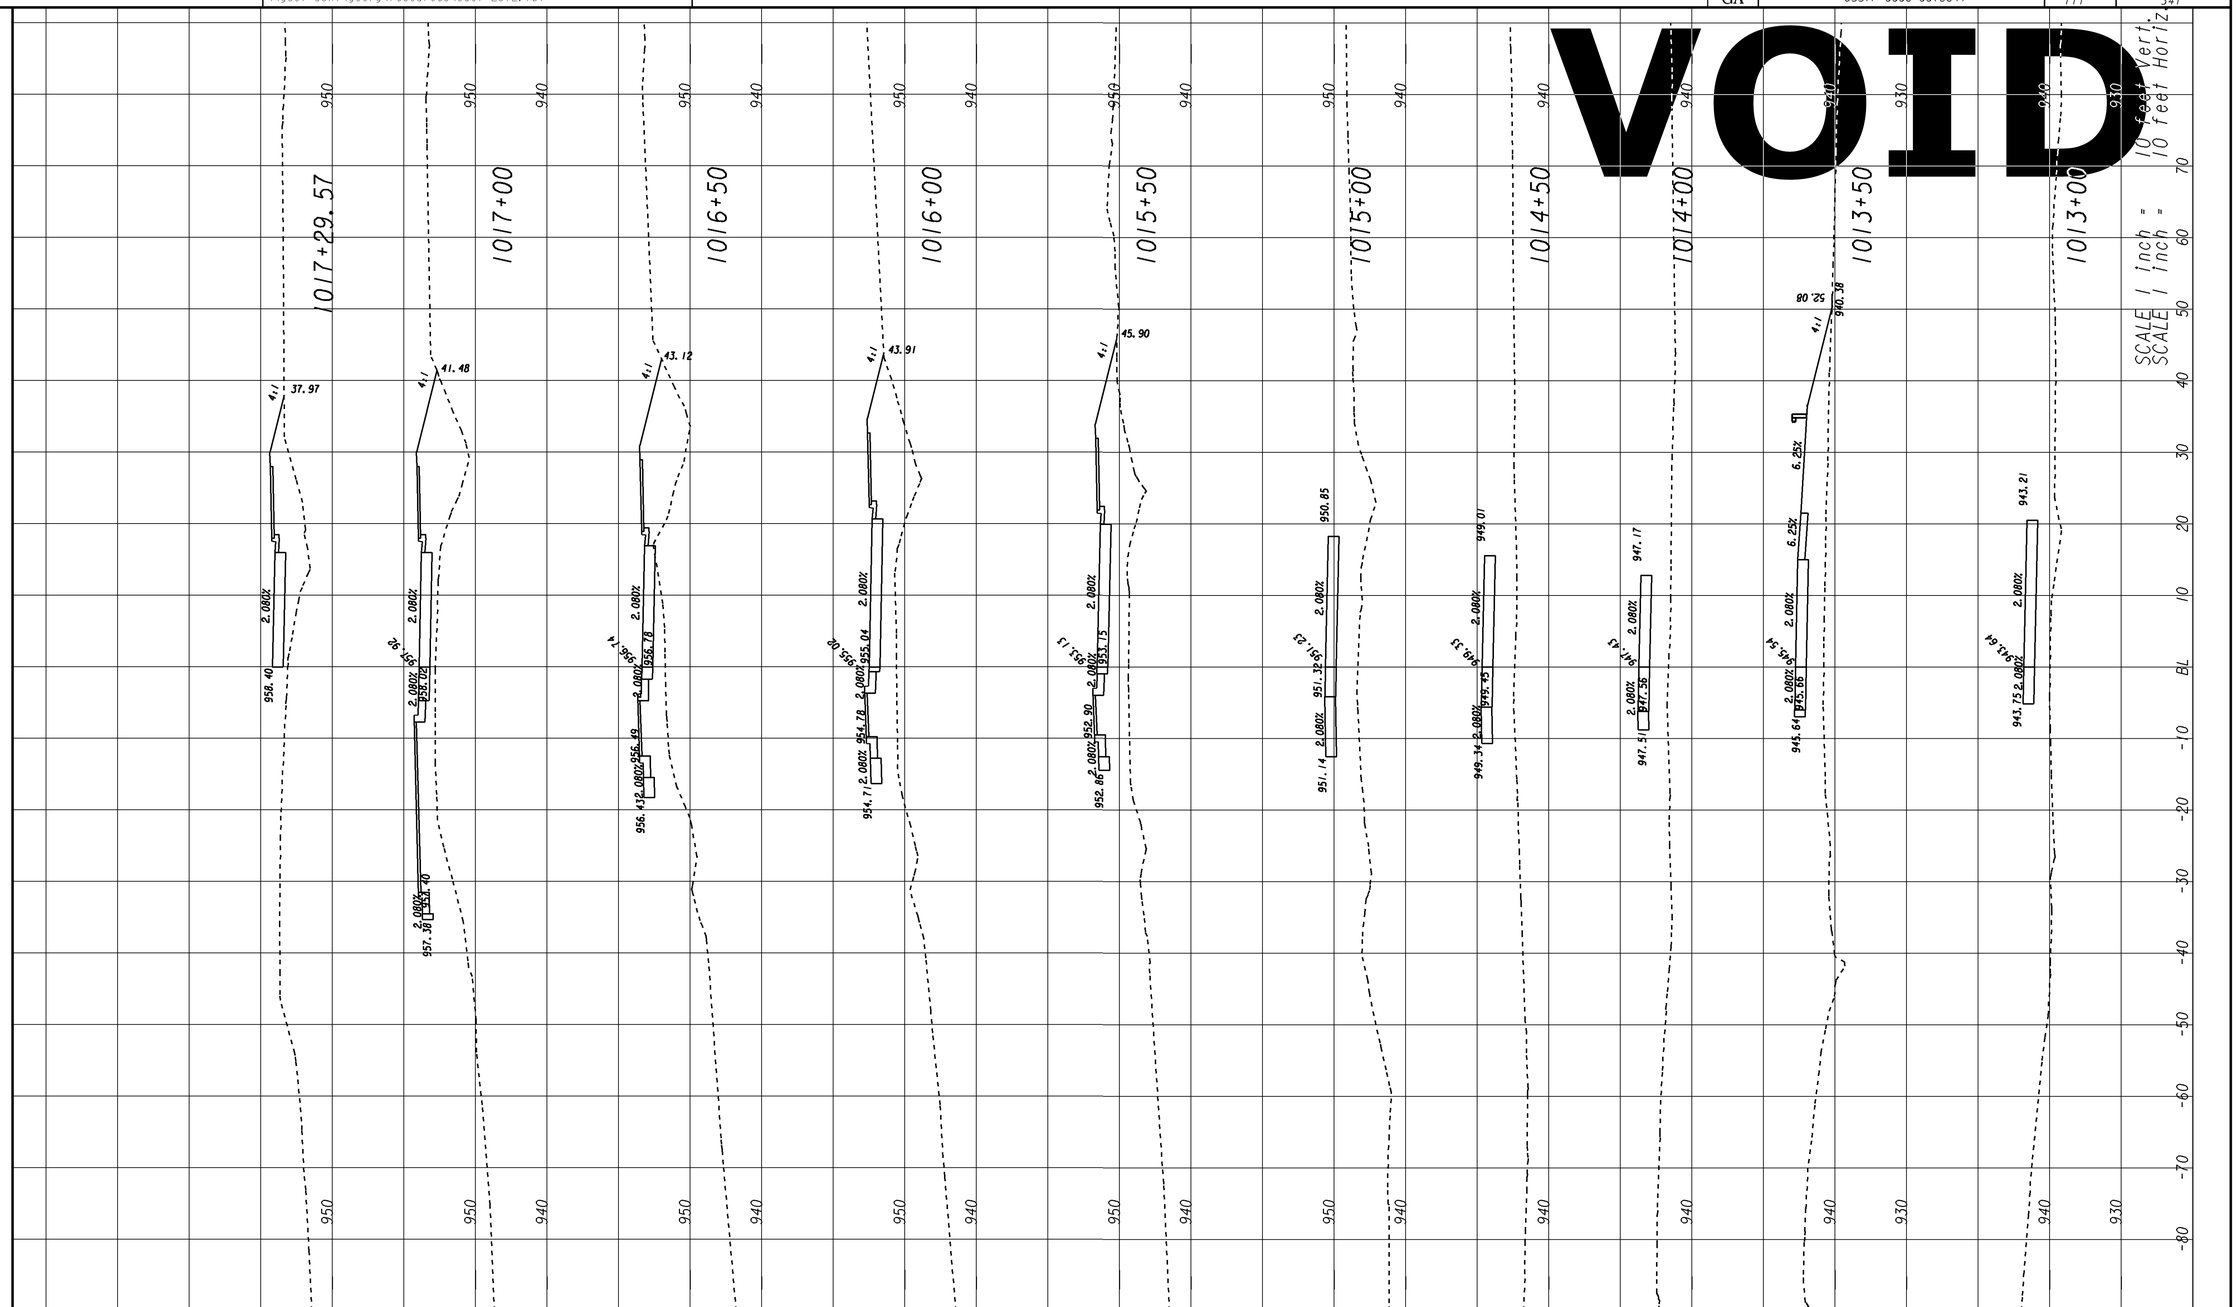

GEORGIA
DEPARTMENT OF TRANSPORTATION

REVISION DATES

STATE OF GEORGIA
DEPARTMENT OF TRANSPORTATION
OFFICE: DISTRICT 7 PRECONSTRUCTION

CROSS SECTIONS

SR 154 (R)
KC5080

DRAWING No. 23-03

1/5/2009 SUXEN