DATE$$$	002669RW02	O:\24258\f\002669RW02.dgn
muddlml	$$PENTABLE$$	GRWPLN

STATE	PROJECT NUMBER	SHEET NO.	TOTAL SHEETS
GA	CSSTP-0007-00(004)	3	11

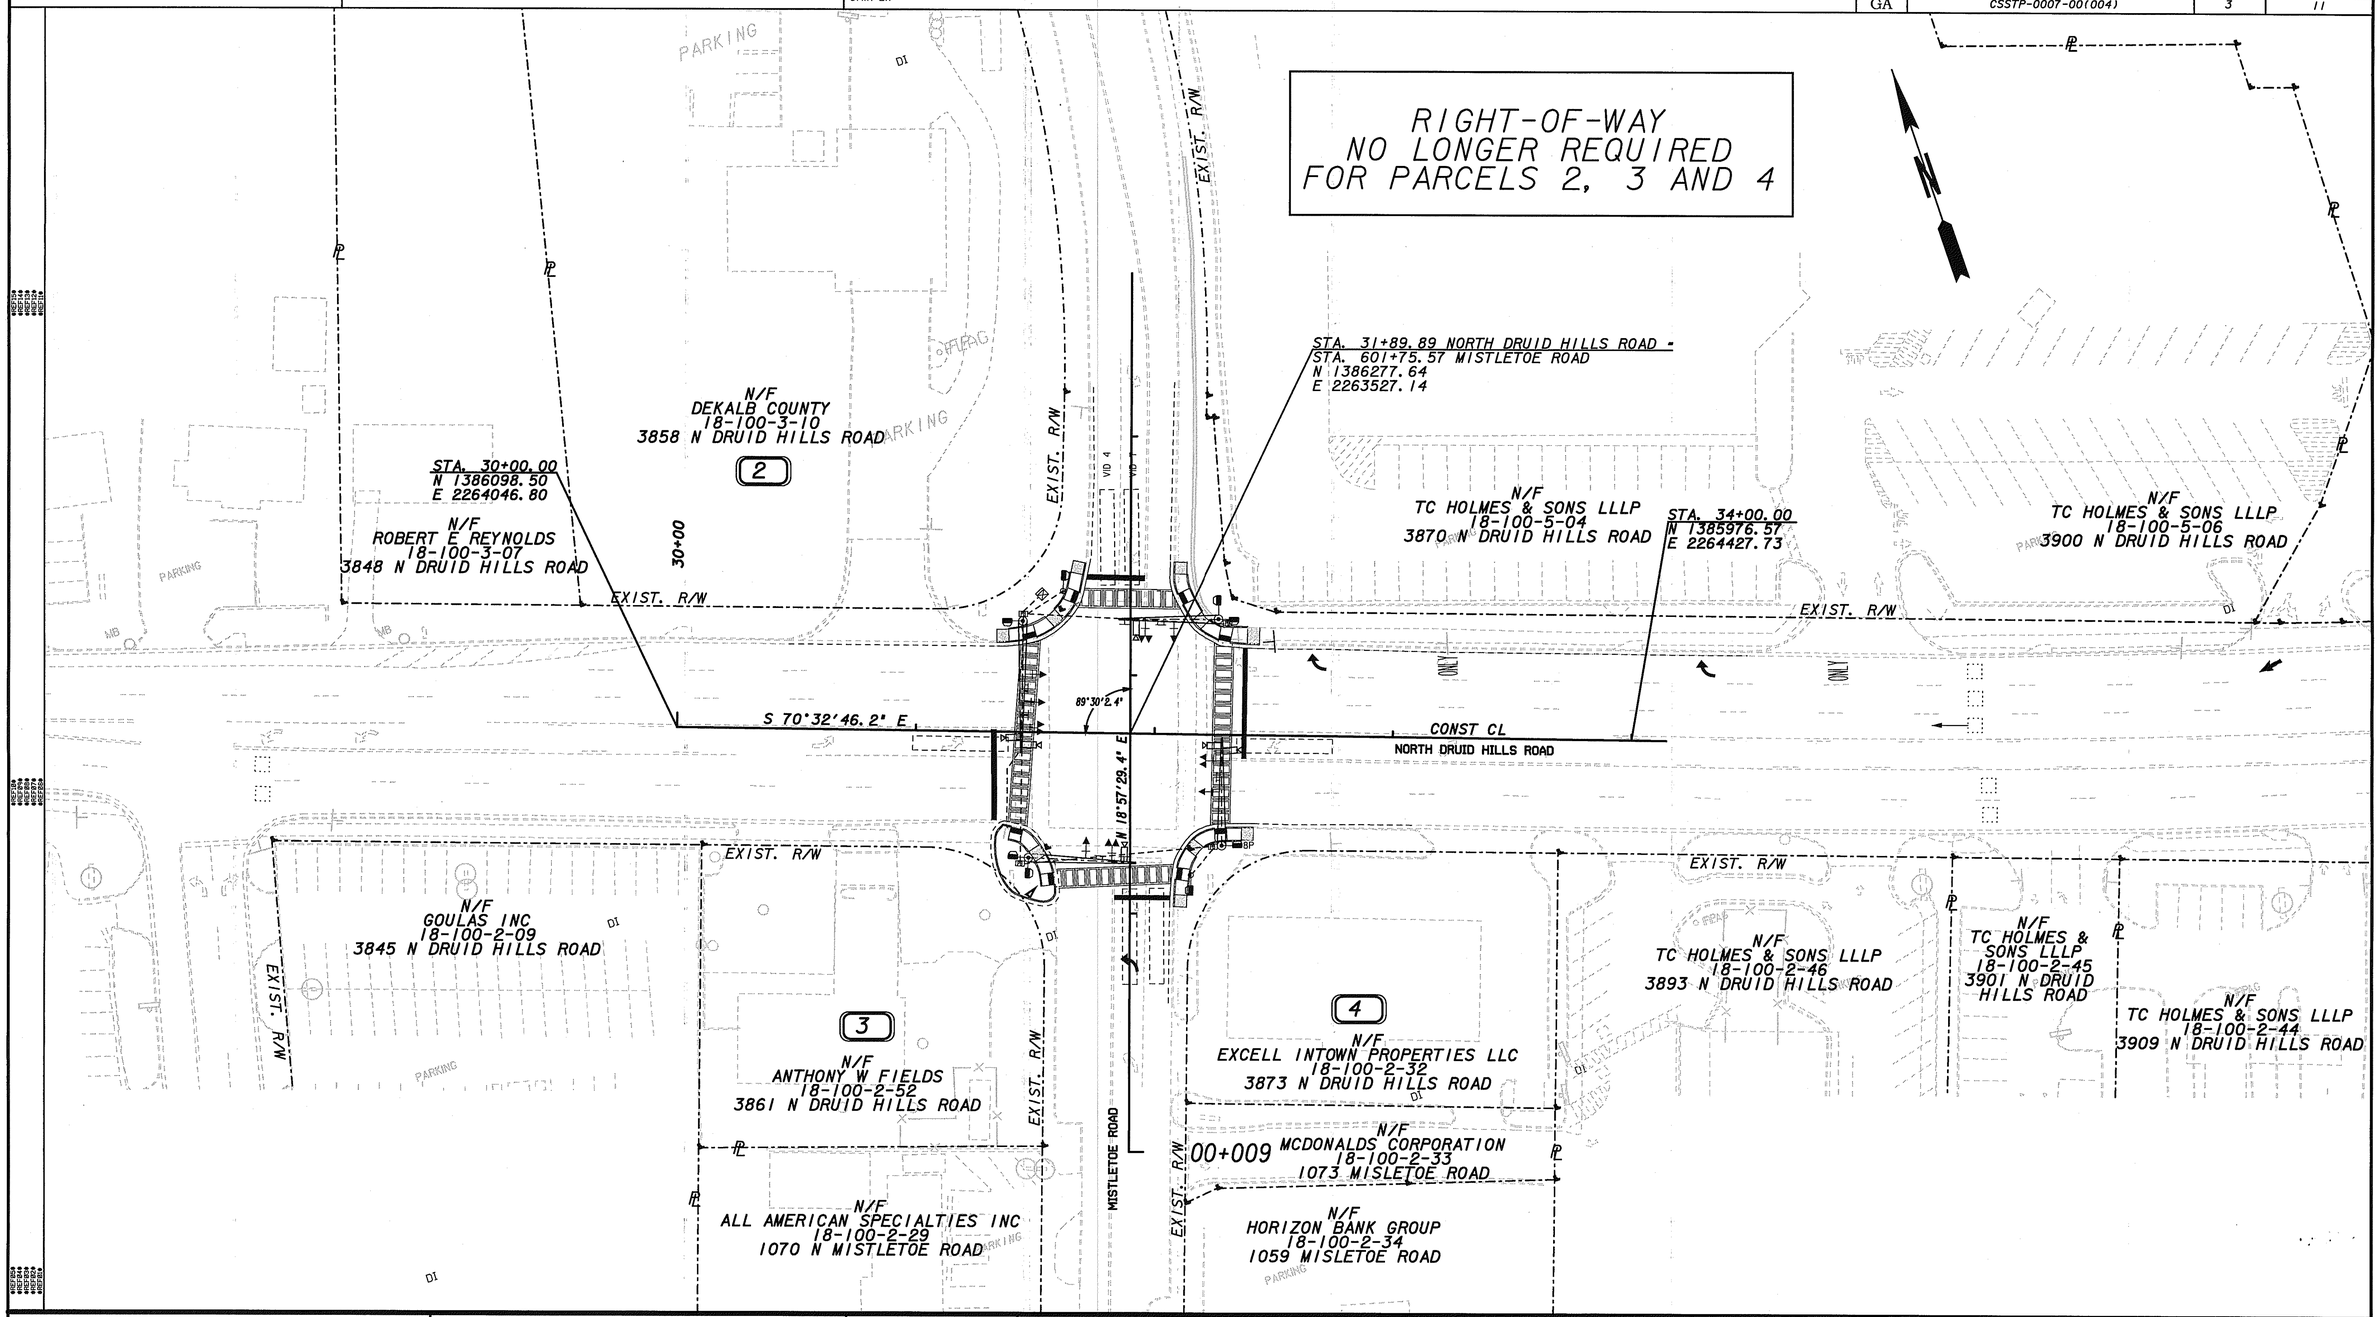

PROPERTY AND EXISTING R/W LINE
REQUIRED R/W LINE
CONSTRUCTION LIMITS
EASEMENT FOR CONSTR & MAINTENANCE OF SLOPES
EASEMENT FOR CONSTR OF SLOPES
EASEMENT FOR CONSTR OF DRIVES

BEGIN LIMIT OF ACCESS.....BLA
END LIMIT OF ACCESS.....ELA
LIMIT OF ACCESS
REQ'D R/W & LIMIT OF ACCESS

SCALE IN FEET
0 30 60 120

G S & P

DATE	REVISIONS	DATE	REVISIONS
01/04/10	REMOVED PARCEL 2, PARCEL 3, AND PARCEL 4		

STATE OF GEORGIA
DEPARTMENT OF TRANSPORTATION

RIGHT OF WAY MAP

PROJECT NO: CSSTP-0007-00(004)
COUNTY: DEKALB
LAND LOT NO: 100
LAND DISTRICT: 18
GMD: 531
DATE: 10/18/07 SH 3 OF 11

3/1/2007