VOID

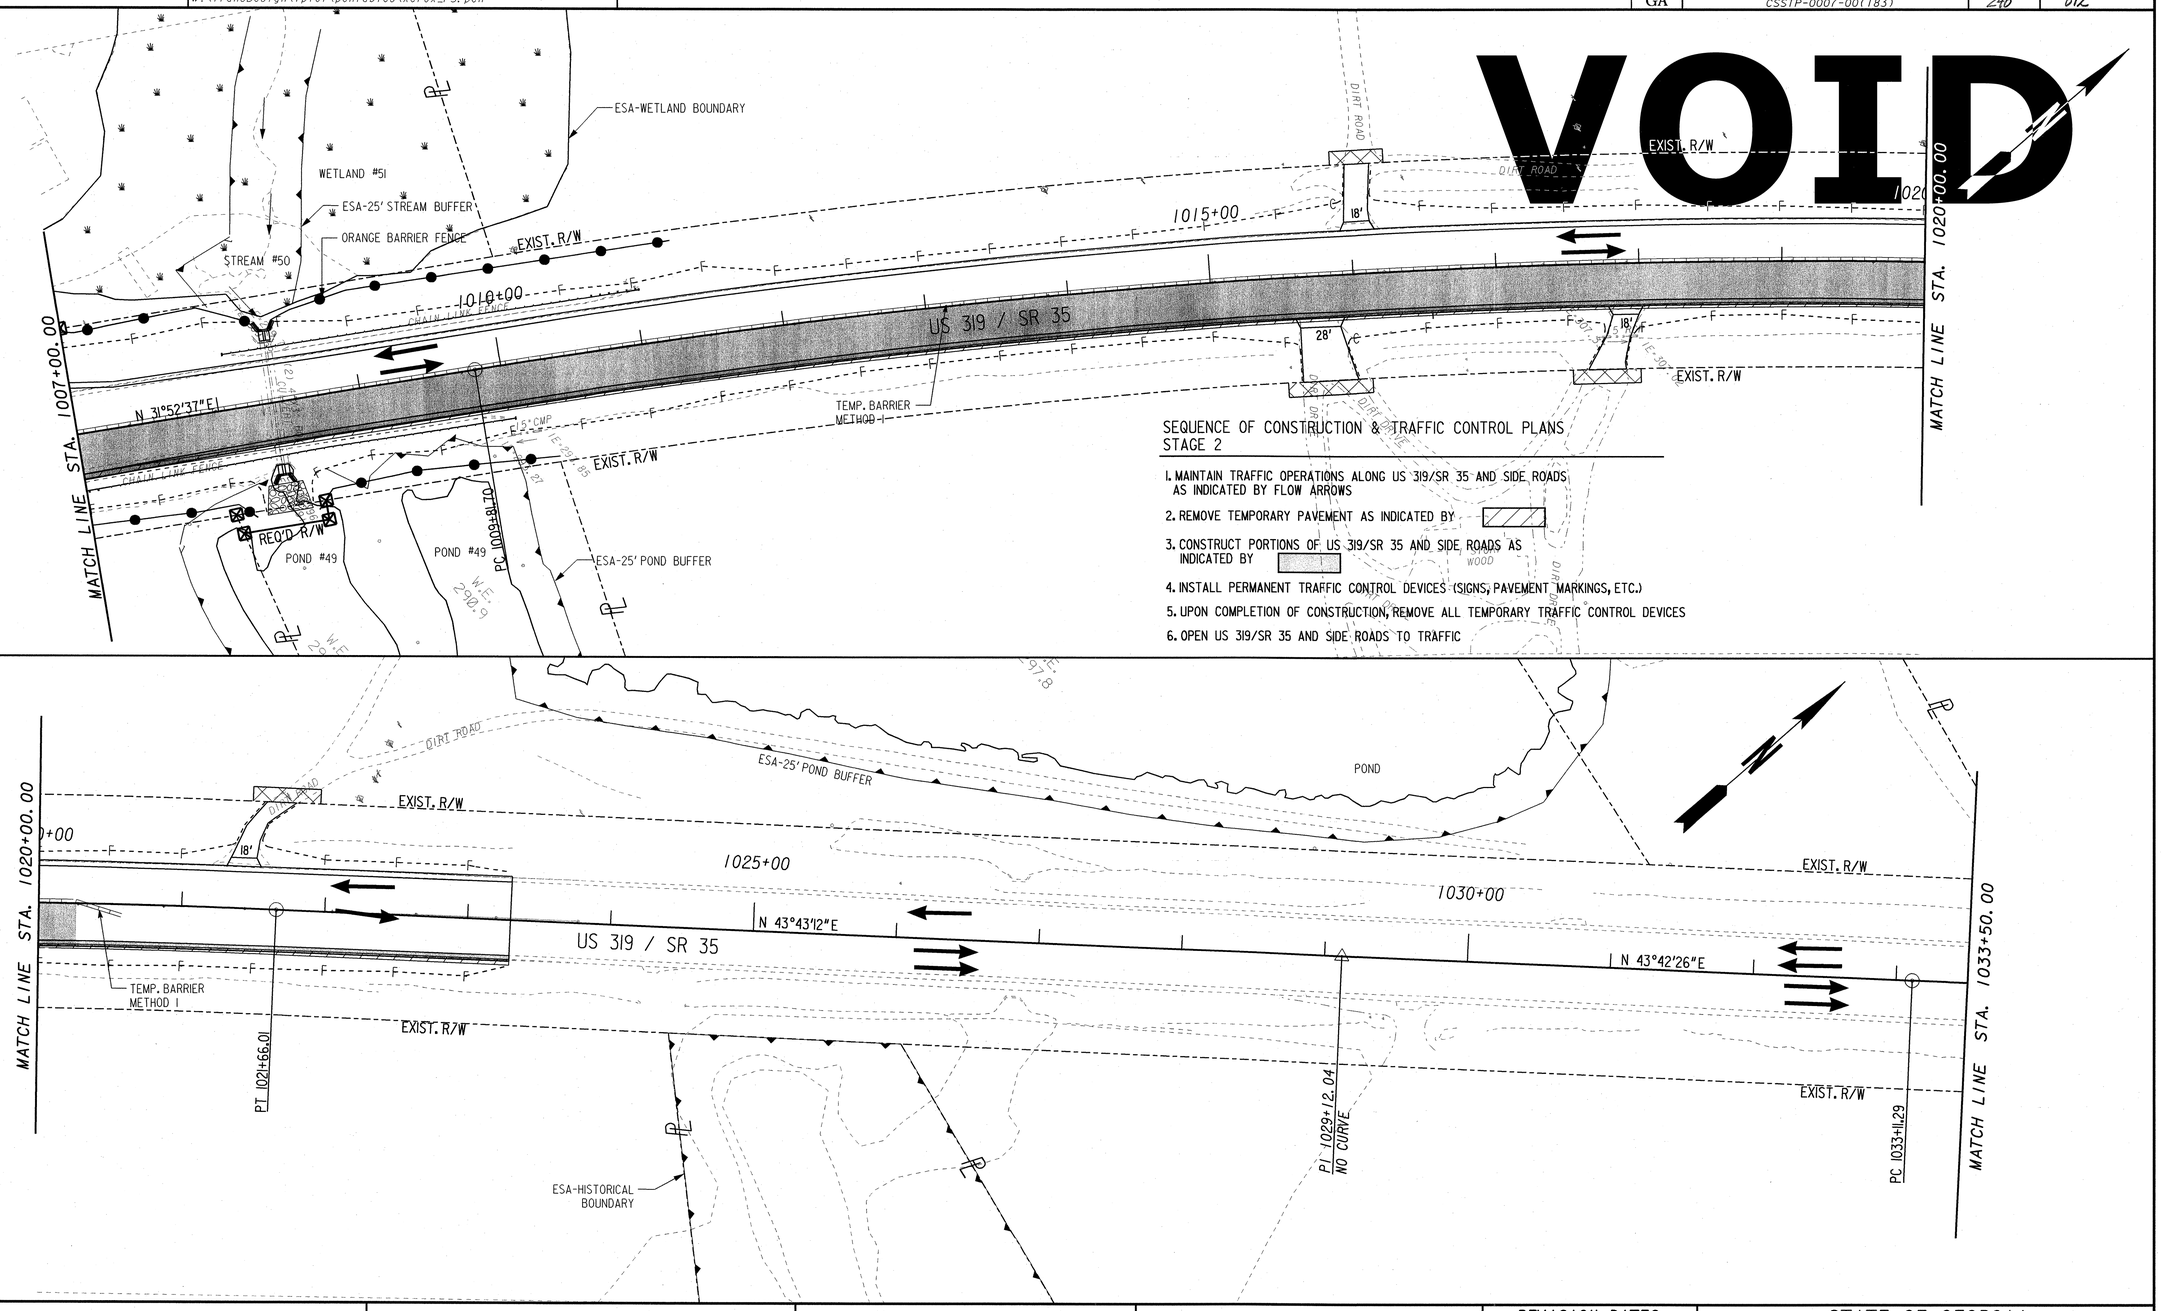

SEQUENCE OF CONSTRUCTION & TRAFFIC CONTROL PLANS STAGE 2

1. MAINTAIN TRAFFIC OPERATIONS ALONG US 319/SR 35 AND SIDE ROADS AS INDICATED BY FLOW ARROWS
2. REMOVE TEMPORARY PAVEMENT AS INDICATED BY
3. CONSTRUCT PORTIONS OF US 319/SR 35 AND SIDE ROADS AS INDICATED BY
4. INSTALL PERMANENT TRAFFIC CONTROL DEVICES (SIGNS, PAVEMENT MARKINGS, ETC.)
5. UPON COMPLETION OF CONSTRUCTION, REMOVE ALL TEMPORARY TRAFFIC CONTROL DEVICES
6. OPEN US 319/SR 35 AND SIDE ROADS TO TRAFFIC

PBS&J

SCALE IN FEET
0 50 100 200

REVISION DATES		

STATE OF GEORGIA
DEPARTMENT OF TRANSPORTATION
OFFICE: TRAFFIC SAFETY AND DESIGN

CONSTRUCTION STAGING PLAN - STAGE 2

US 319/SR 35
COLQUITT/TIFT COUNTIES

DRAWING No. 19-94

3/1/2007 GPLM